



TAYLOR STREET IMPROVEMENTS THE EMBARCADERO TO JEFFERSON STREET

DEPARTMENT OF PUBLIC WORKS

BUREAU OF ENGINEERING

CONTRACT NO. 1498J

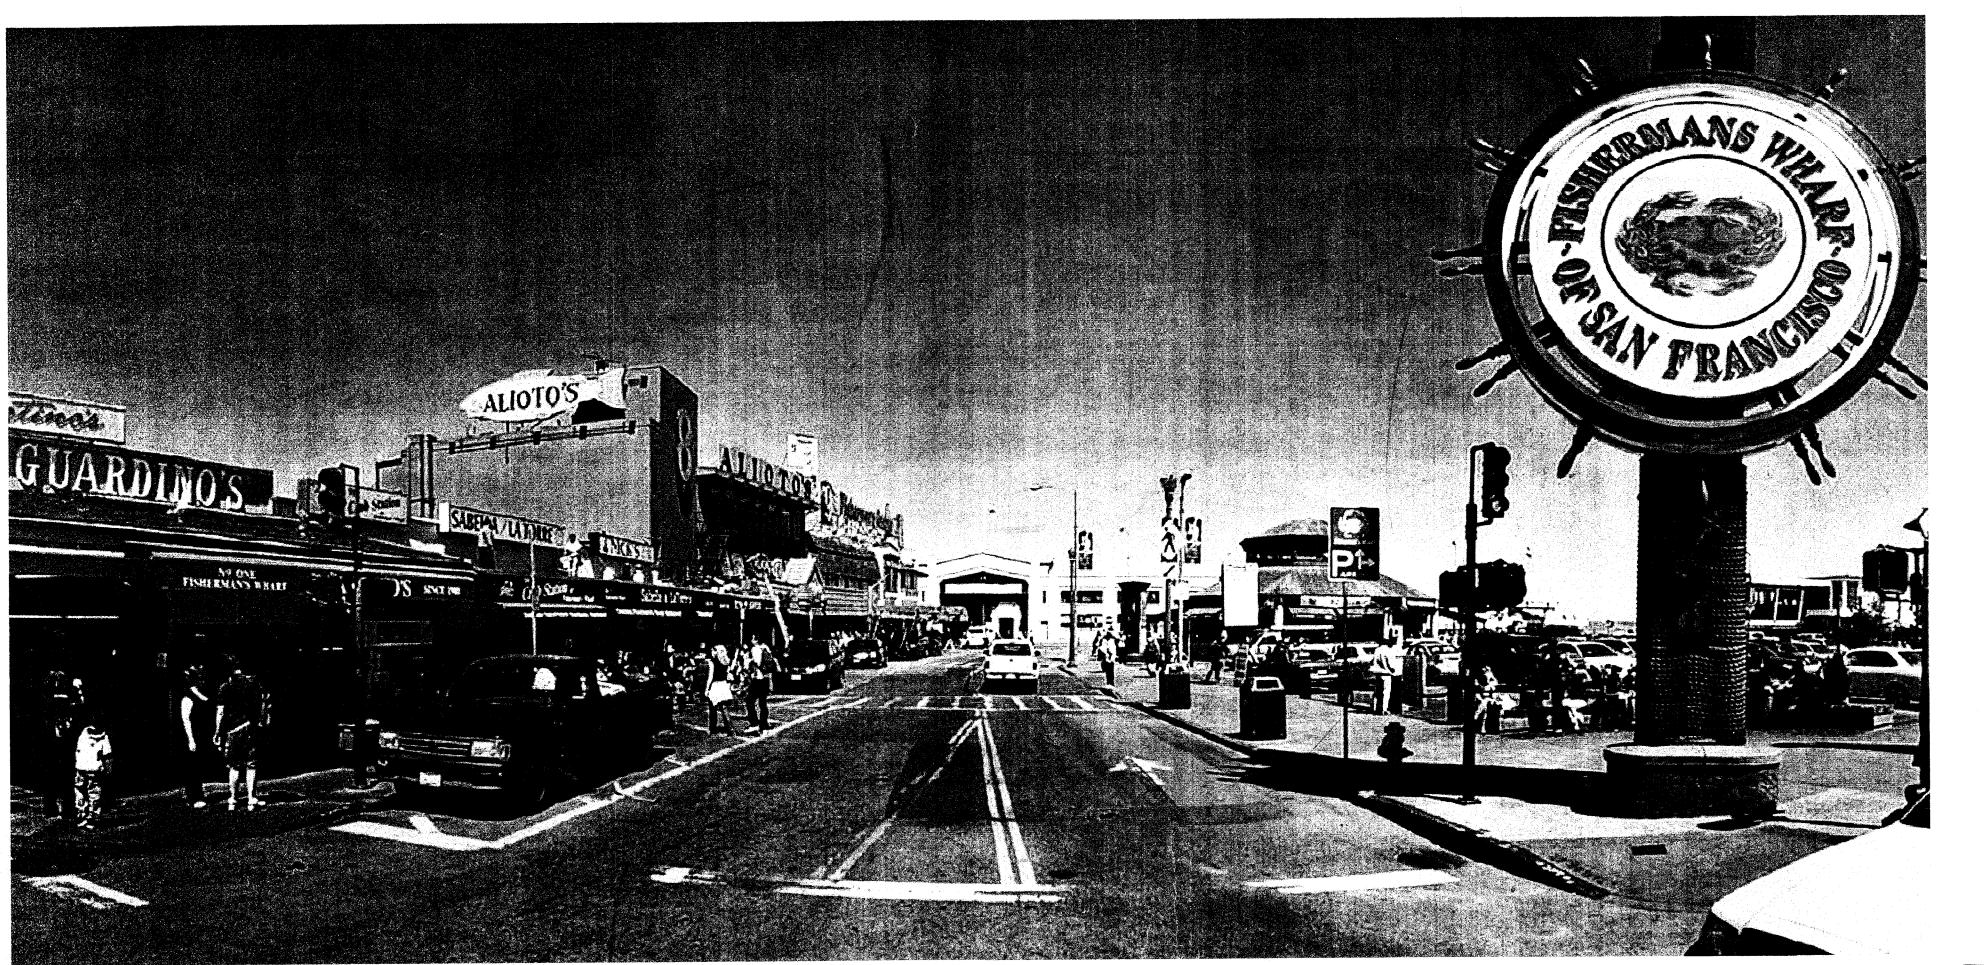

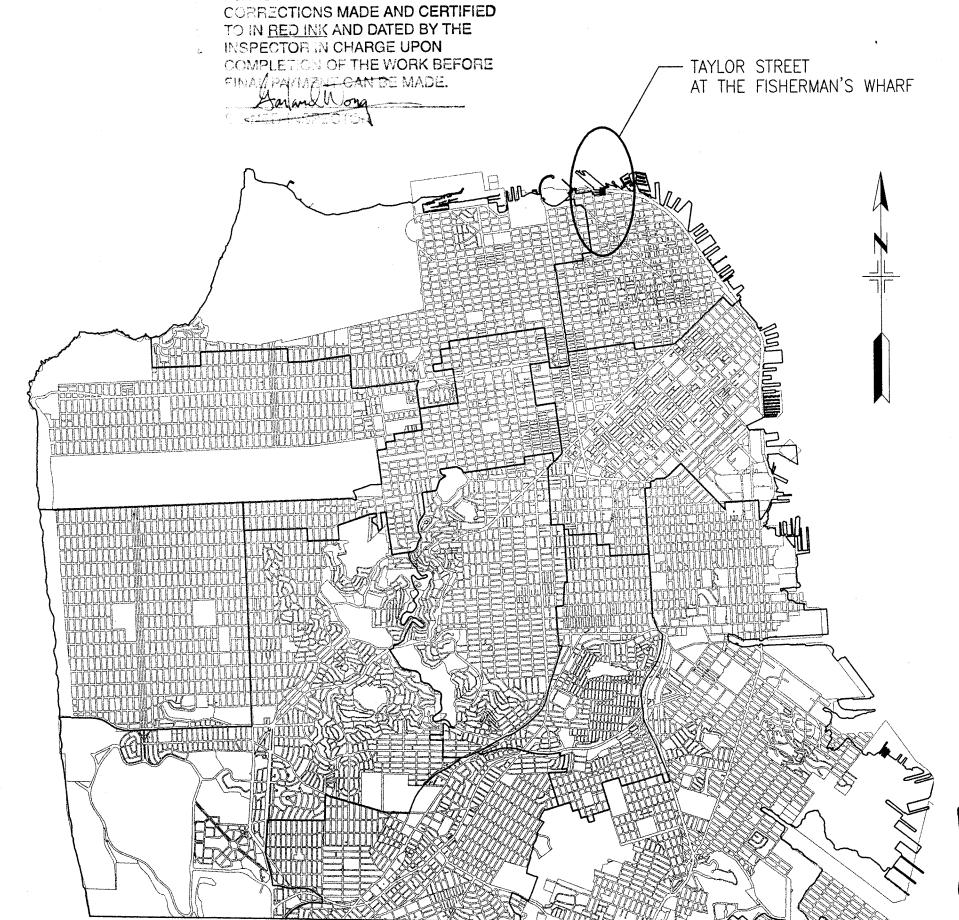


LOCATION MAP

COVER SHEET

CONFORMED SET

REFERENCE INFORMATION & FILE NO. OF SURVEYS BUREAU OF ENGINEERING DEPARTMENT OF PUBLIC WORKS CITY AND COUNTY OF SAN FRANCISCO TABLE OF REVISIONS
CHECK WITH TRACING TO SEE IF YOU HAVE LATEST REVISION

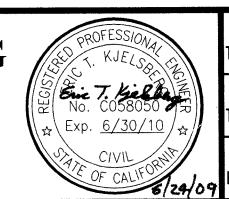

JUNE 2009

		:
DESIGNED	DATE	APPROVED
T.CLAVERIA CO	6/09	Pall Din 6.26.09
DRAWN	DATE	SECTION MANAGER DATE
T.CLAVERIA to	6/09	DEPUTY BUREAU MANAGER DATE
CHECKED ETK	DATE	N +10/1 - 6/30/m
E.KJELSBERG	6/09	CITY ENGINEER DATE


VED	SCALE	
6.26.09		N(
R DATE 6/29/04		
MANAGER DATE	SHEET	OF
ine 6/30/09		
DATE		


TAYLOR STREET IMPROVEMENTS THE EMBARCADERO TO JEFFERSON STREET

RAWING NO. FILE NO. REV. NO.

1498J

PLANS ARE TO BE RETURNED WITH CORRECTIONS MADE AND CERTIFIED TO IN RED INK AND DATED BY THE INSPECTOR IN CHARGE UPON COMPLETION OF THE WORK BEFORE FINAL PAYMENT CAN BE MADE. SIGNED-INSPECTOR

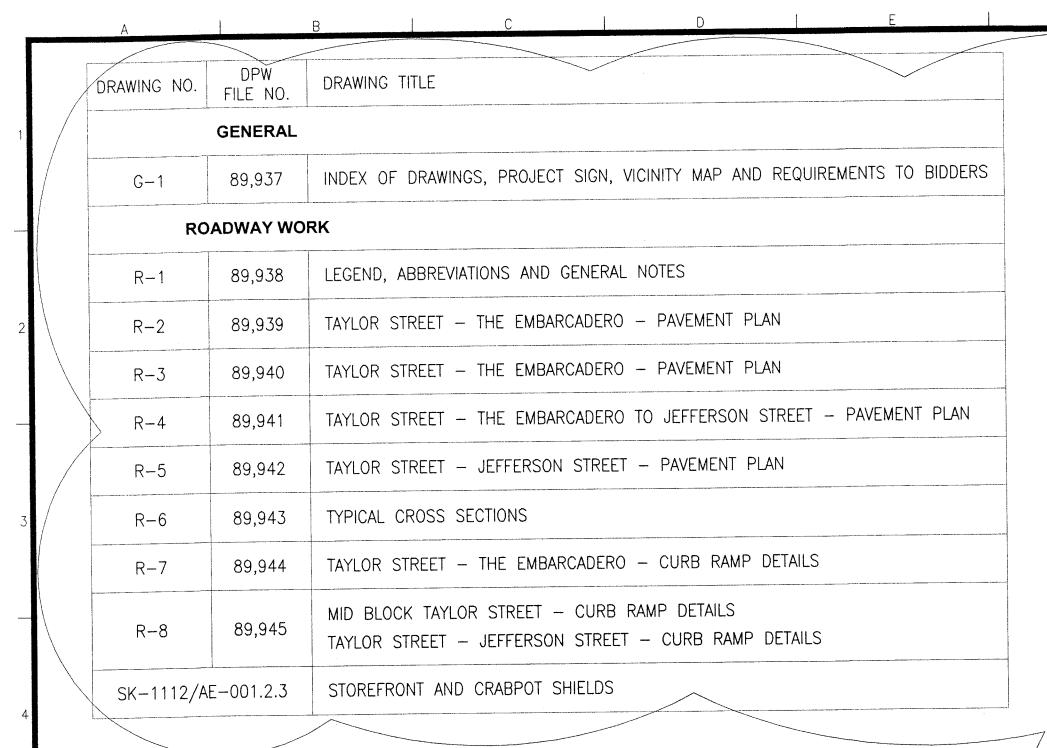

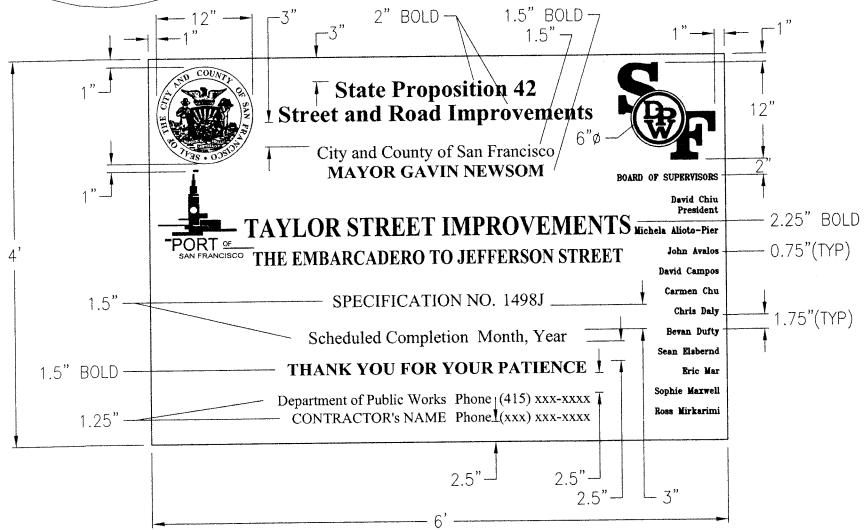

PROJECT SIGN

- 1. FONTS SHALL BE AS SHOWN: TIMES ROMAN OR COMPARABLE FONT.
- 2. BACKGROUND IS WHITE, AND SUPPORT (NOT SHOWN) SHALL BE PAINTED WHITE.
- 3. SIGN AND SUPPORT SHALL HAVE ANTI-GRAFFITI FINISH.
- 4. ALL TEXTS AND THE CITY LOGO ARE BLUE COLOR.
- DPW LOGO: THINNER OUTSIDE CIRCLE AND LETTERS D, P AND W ARE ORANGE COLOR; LETTERS S AND F, AND THE THICKER INNER CIRCLE ARE BLUE COLOR.
- ALL OTHER DIMENSIONS NOT SHOWN, SUCH AS SPACING BETWEEN LINES OF TEXT, SHALL BE SCALED APPROPRIATELY.
- 7. THE CONTRACTOR SHALL VERIFY THE NAMES OF BOARD MEMBERS, CONTACT PHONE NUMBERS, AND PROJECT COMPLETION MONTH AND YEAR PRIOR TO CONSTRUCTING PROJECT SIGN.
- 8. THE CONTRACTOR'S PHONE CONTACT SHALL BE ACCESSIBLE 24 HOURS A DAY, 7 DAYS A WEEK.

REFERENCE INFORMATION & FILE NO. OF SURVEYS 10/5/09 ADDENDUM NO. 2 BY AP DESCRIPTION TABLE OF REVISIONS CHECK WITH TRACING TO SEE IF YOU HAVE LATEST REVISION



BUREAU OF ENGINEERING DEPARTMENT OF PUBLIC WORKS

TS-3

STR-7025

BUREAU OF ENGINEERING	PROFESSIONAL CX G. RILLY	T.
DEPARTMENT OF PUBLIC WORKS	No. C051131 ⊞ Exp. 9/30/11 \\\\\\\\\\\\\\\\\\\\\\\\\\\\\\\\\\\	T.
CITY AND COUNTY OF SAN FRANCISCO	CIVIL OF CALIFORNIE OF CALIFORNIE	E

V 1 C			SEE DRAWING FILE NO. 89,937 REV. 0 FOR ORIGINAL MANAG	GERS' SIGNATURES
ESIGNED DATE		SCALE	TAYLOR STREET IMPROVEMENTS	CONTRACT NO. 1498J
CLAVERIA C 6/09 RAWN DATE	SECTION MANAGER DATE	NONE	THE EMBARCADERO TO JEFFERSON STREET	drawing no. G-1
CLAVERIA to 6/09	DEPUTY BUREAU MANAGER DATE	SHEET OF SHEETS	INDEX OF DRAWINGS, PROJECT SIGN	FILE NO. 89,937
HECKED ETK DATE KJELSBERG 6/09	CITY ENGINEER DATE	1 OF 39	VICINITY MAP AND REQUIREMENTS TO BIDDERS	REV. NO.

VICINITY MAP

INDEX OF DRAWINGS DRAWING TITLE FILE NO. **SEWER WORK** LEGEND, ABBREVIATIONS, GENERAL NOTES AND DETAILS 89,947 | SEWER PLAN AND PROFILE DETAILS AND 6"Ø DIP LAYOUT PLAN 89,949 UTILITY OCCUPANCY **WATER WORK** LEGEND, ABBREVIATIONS AND GENERAL NOTES 8" DUCTILE IRON WATER MAIN INSTALLATION **ELECTRICAL WORK** LEGEND, ABBREVIATIONS AND GENERAL NOTES ELECTRICAL DEMOLITION PLAN E-289,953.1 | ELECTRICAL DEMOLITION PLAN E-389,954 | ELECTRICAL PLAN 89,954.1 | ELECTRICAL PLAN 89,955 | ELECTRICAL DETAILS TRAFFIC SIGNAL WORK 89,956 TRAFFIC SIGNAL LEGEND - SYMBOLS, ABBREVIATIONS AND GENERAL NOTES

TRAFFIC SIGNAL MODIFICATIONS - TAYLOR STREET AND JEFFERSON STREET

SIGNAL HEAD MOUNTINGS

TRAFFIC SIGNAL PULLBOX DETAIL, TYPE I-IV PULL BOX, COVER AND CONDUIT

DRAWING NO.	DPW FILE NO.	DRAWING TITLE
TRAFF	IC ROUTING	WORK
T-1	89,957	CONSTRUCTION PHASING PLAN — PHASE 1
T-2	89,958	CONSTRUCTION PHASING PLAN - PHASE 2
T-3	89,959	CONSTRUCTION PHASING PLAN - PHASE 3
STR-7	7695	DETAILS FOR DELINEATORS, CHANNELIZERS AND BARRICADES
STR-7	7696	PEDESTRIAN CROSSWALKS THROUGH CONSTRUCTION ZONES
FOF	RCE MAIN WO	ORK (ALTERNATE BID ITEM NO. 1)
FM-1	89,960	LEGEND, ABRREVIATIONS AND GENERAL NOTES
FM-2	89,960.1	TAYLOR STREET FORCE MAIN WITH BORE AND JACK, PLAN AND PROFILE
FM-3	89,960.2	CASING, TRENCHING AND CLEANOUT DETAILS
FM-4	89,960.3	10" FORCE MAIN CONNECTION AND CONCRETE COLLAR DETAILS
U-2	89,961	UTILITY TRENCHING RESULTS
U-3	89,961.1	UTILITY TRENCHING RESULTS
U-4	89,961.2	UTILITY TRENCHING RESULTS
A-38,341.1		RELOCATE 30" DIAMETER FORCE MAIN AT JEFFERSON STREET AND TAYLOR STREET

REQUIREMENTS TO BIDDERS


IN ACCORDANCE WITH THE PROVISIONS OF THE CALIFORNIA PUBLIC CONTRACT CODE SECTION 3300, A BID SUBMITTED TO A PUBLIC AGENCY BY A CONTRACTOR WHO IS NOT LICENSED IN ACCORDANCE WITH CHAPTER 9 OF THE BUSINESS AND PROFESSIONS CODE SHALL BE CONSIDERED NON-RESPONSIVE AND SHALL BE REJECTED BY THE PUBLIC AGENCY.

AT THE TIME OF BID OPENING, THE CONTRACTOR SHALL POSSESS A VALID CLASS "A" CALIFORNIA GENERAL ENGINEERING CONTRACTOR'S LICENSE.

В	C D E	F	<u></u> Н	<u> </u>	J	K	j	L M	SIC	GNED-INSPECTOR 0
	LEGEND						ABB	REVIATIONS		
APPROXIMATE A MINIMUM OF AC	REA TO BE RECONSTRUCTED WITH 3-INCH THICK WS ON 8-INCH THICK CONCRETE BASE.	PGE	EXISTING PG&E MANHOLE	ACWS	ASPHALT CONCRETE WEARING SURFACE	E D)WY	DRIVEWAY	(N)	NEW
		-•-	EXISTING POWER POLE	BC	BEGINNING OF HORIZONTAL CURVE	(E)	EXISTING	PA	PORT AUTHORITY
CONSTRUCT CONSTR	MBINED 6—INCH WIDE CONCRETE CURB IDE CONCRETE GUTTER.	Ð	EXISTING SEWER CLEANOUT	BLDG	BUILDING	E	C I	END OF HORIZONTAL CURVE	PC	POINT OF CURVATURE
		_	EMOTING SEMEN SEBAROOT	ВМ	BENCHMARCH	Е	LEV	ELEVATION	PI	POINT OF INTERSECTION
APPROXIMATE A TO BE RECONS	REA OF 3-1/2-INCH THICK CONCRETE SIDEWALK TRUCTED.	S	EXISTING SEWER MANHOLE	BRK	GRADE BREAK	E	VC I	END OF VERTICAL CURVE	PT	POINT OF TANGENT
				BVC	BEGINNING OF VERTICAL CURVE	F	A f	FIRE ALARM	PVI	POINT OF VERTICAL INTERSECTION
(WARNING BAND	BE CONSTRUCTED WITH 12-INCH WIDE GROOVED BORDERS S) AND CAST-IN-PLACE DETECTABLE SURFACE TILES	 0-	EXISTING SIGN POLE	C1	CURVE 1	F	IG f	FIGURE	PVC	POINT OF VERTICAL CURVE
(TRUNCATED DO	MES)	◆	EXISTING SURVEY BENCHMARK	С	CURB	G	(GUTTER	REF PT	REFERENCE POINT
	OR SIDEWALK OR PAVEMENT ELEVATION CHBASIN ELEVATION	\triangle	EXISTING SURVEY CONTROL POINT	СВ	CATCHBASIN	G	HP (GUTTER HIGH POINT	STA	STATION
/		8	EXISTING TRAFFIC SIGNAL	Ę.	CENTER LINE	Н	P I	HIGH-PRESSURE	TYP	TYPICAL
	ETAIL INDENTIFICATION	TPB	EXISTING TELEPHONE PULLBOX	CO	CLEANOUT	LF) [_OW-PRESSURE	VC	VERTICAL CURVE
FIG REFERENCE DRA	WING NO.			DWG	DRAWING	М	H N	MANHOLE		
EXISTING BACK	OF SIDEWALK	WM	EXISTING WATER METER							
MATCH LINE		W	EXISTING WATER VALVE							
CONFORM LINE										
EXISTING BARBA	RY COAST PLAQUE				GENERAI	NOTES	5	·		
EXISTING CATCHI	BASIN TO BE ABANDONED	1. ENTERING FAMILIAR DOCUMEI	G INTO THIS CONTRACT WITH THE CITY INDICAT WITH THE EXISTING CONDITIONS AND REVIEWE NTS.	ES THAT THE CO D SAME WITH TH	NTRACTOR HAS VISITED THE SITE, IS E REQUIREMENTS OF THE CONTRACT	11. CROS CONE	SS SECTION DITIONS UNL	CALL—OUTS ARE SHOWN ONLY ON LESS OTHERWISE INDICATED.	NCE ON THE DRA	AWINGS AND ARE TYPICAL FOR SIM
EXISTING CATCHE	BASIN TO REMAIN	2. THE CON	TRACTOR IS RESPONSIBLE FOR REVIEWING ALL	CONTRACT DOC	UMENTS AND FIELD CONDITIONS. AND	12. EXIST	TING CATCH	BASIN GRADE SHALL BE ADJUSTED	O IN THE FIELD	TO CONFORM TO NEW GUTTER GR
		FOR CONTRAC	NFIRMING THAT THE WORK IS BUILDABLE AS SECTOR IS RESPONSIBLE FOR OBTAINING CLARIFIC QUESTION OR RELATED WORK.	HOWN RFFORF P	ROCEEDING WITH THE WORK THE	13. THE	LIMITS OF S	SIDEWALK RECONSTRUCTION SHOWN TO THE NEAREST FLAG/JOINT.	ON THE DRAWI	NGS ARE APPROXIMATE. THE CONT
NEW CATCHBASIN	1		STRACTOR SHALL VERIFY EXISTING FACILITIES IN	THE FIELD, WH	ETHER OR NOT THEY ARE SHOWN ON	14. ALL I		LT AND PULL BOX COVERS WITHIN	THE AREA OF S	SIDEWALK RECONSTRUCTION SHALL
EXISTING DRAIN		4. THE CON PROCEED	ITRACTOR SHALL NOTIFY THE ENGINEER IN WRI	TING OF CONFLIC	CTS BETWEEN DRAWINGS PRIOR TO	15. THE SLOP	12-INCH W ED RAMP A	VIDE GROOVED BORDERS (WARNING AND WING SURFACES UNLESS OTHE	BANDS) ON CUI RWISE INDICATED	RB RAMPS SHALL NOT BE PART (
EXISTING ELECTR	RIC PULL BOX	ADJACEN	ITRACTOR IS RESPONSIBLE FOR WORKING AROUT TO THE WORK AREA. THESE FACILITIES INCLUTED AR TRACKS, TREES, LANDSCAPING, HYDRANTS A	JDE. BUT ARF N	OT LIMITED TO THE FOLLOWING:	IHE	FOLLOWING	VERTICAL ELEMENTS INSTALLED OR MINIMUM CLEARANCES: THE MINIMUSSURE HYDRANT IS FIVE (5) FEET.	JM CLEARANCE F	RETWEEN A POLE OR VERTICAL FL
	OLIER					VERTI	CAL ELEMEI	NT TO A LOW PRESSURE HYDRANT	IS THREE (3) F	EET.
	RESSURE OR HIGH-PRESSURE FIRE HYDRANT		CKNESS OF THE NEW ASPHALT CONCRETE WEAR UNLESS OTHERWISE INDICATED ON THE DRAWI			0154	U OF THE T	MENTS MUST BE PROTECTED PER S PROJECT MANUAL. CALL THE COUN DANGER OF DISTURBANCE, DESTRU	TY SURVEYOR A	[(415) 554—5833 TO REPORT AI
EXISTING FIRE V	ALVE	UNLESS	OTHERWISE INDICATED ON THE DRAWINGS OR	AS DIRECTED BY	THE ENGINEER.	18. IN TH	IE EVENT C	OBBLESTONES ARE ENCOUNTERED	IN ANY STREET	UNDER CONSTRUCTION, THE CONT
EXISTING GAS ME	ETER	8. WRITTEN PROCEED	DIMENSIONS SHALL GOVERN. THE CONTRACTOR DING WITH THE WORK.	SHALL VERIFY	ALL DIMENSIONS PRIOR TO	SHALI AND COBB	L REMOVE SECURELY I LESTONES S	THEM FROM THE PROJECT SITE AS PLACED ON PALLETS SO THEY CAN SHALL BE DELIVERED, INCLUDING C 2323 CESAR CHAVEZ STREET OR	CITY PROPERTY BE MOVED ABO FF LOADING, TO	. THE COBBLESTONES SHALL BE 1 OUT SAFELY AFTER DELIVERY. THE THE LOWER LOT OF THE CESAR
★ EXISTING GAS VA		CONSTRU	KISTING AND NEW ELEVATIONS ARE GIVEN FOR ICT TO NEW ELEVATIONS. UNLESS OTHERWISE (INSTRUMENT ONLY).	THE SAME POINT DIRECTED BY THE	, THE CONTRACTOR SHALL ENGINEER, THE EXISTING	SAN CONTI COBB	FRANCISCO. RACTOR SHA LESTONES S	- CONTACT LIZ LERMA AT (415) 64 ALL CLEAN THE COBBLESTONES OF SO AS TO MINIMIZE DAMAGE. SALVA	1-2627, 48 HO DIRT AND EXER AGE HAULING AN	URS PRIOR TO DELIVERY. THE RCISE CARE IN TRANSPORTING THE ID DELIVERY OF EXISTING CORRIE
 EXISTING BOLLAR 	D/GUARD POST		D DETAILS AND INFORMATION SHALL BE USED			TO TH	HE DESIGNA	TED AREAS, FROM THE PROJECT S	ITE, SHALL BE	OONE AS INCIDENTAL WORK.


				REFERENCE INFORMATION & FILE NO. OF SURVEYS
NO. DATE	DESCRIPTION	BY	APP.	
	DESCRIPTION TABLE OF REVISIONS ECK WITH TRACING TO SEE IF YOU HAVE LATEST REVISION	BY	APP.	

EXISTING LIGHT POLE

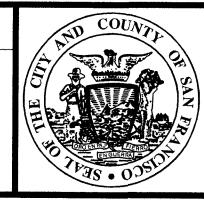

BUREAU OF ENGINEERING

DEPARTMENT OF PUBLIC WORKS CITY AND COUNTY OF SAN FRANCISCO

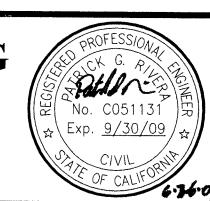

STANDARD DETAILS AND INFORMATION SHALL BE USED FOR ALL APPLICABLE CASES UNLESS SHOWN OR OTHERWISE INDICATED.


	DESIGNED	DATE	APPROVED
	T.CLAVERIA	-6/09	Palah Di 6.26.0
	DRAWN	DATE	SECTION MANAGER DA
	T.CLAVERIA to	² 6/09	DEPUTY BUREAU MANAGER DA
	CHECKED	DATE	M + (D) 1. 6/30
•	E.KJELSBERG	6/09	CITY ENGINEER DA DA

	SCALE	
OJ ATE	NONE	THE E
ATE	SHEET OF SHEETS	
/_	2 OF 39	LEGEND.

CONTRACT NO. 1498J TAYLOR STREET IMPROVEMENTS EMBARCADERO TO JEFFERSON STREET DRAWING NO. FILE NO. LEGEND, ABBREVIATIONS AND GENERAL NOTES REV. NO.


19. AT THE COMPLETION OF WORK, THE CONTRACTOR SHALL REMOVE ALL MARKS, STAINS AND BLEMISHES RESULTING FROM CONSTRUCTION OPERATIONS THROUGHOUT THE CONTRACT.


89,938

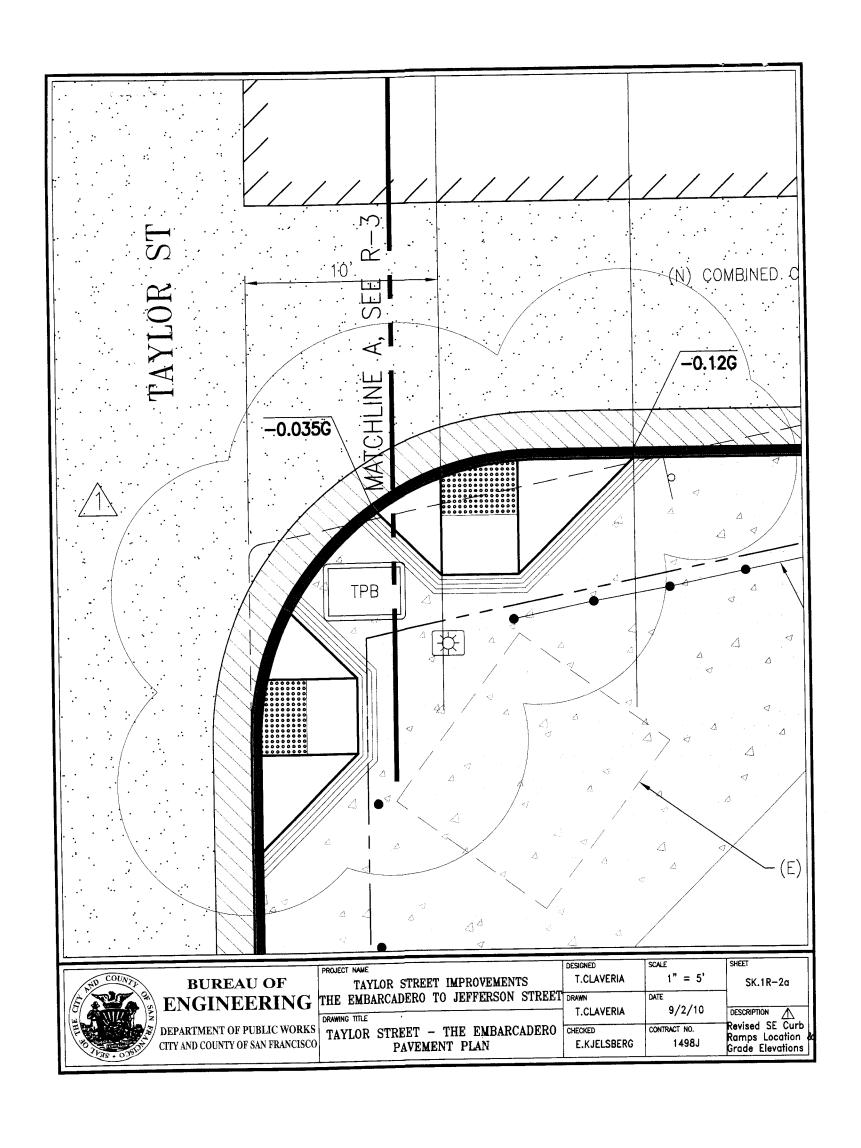


C1 C2 C3

MATCHLINE B, SEE R-4

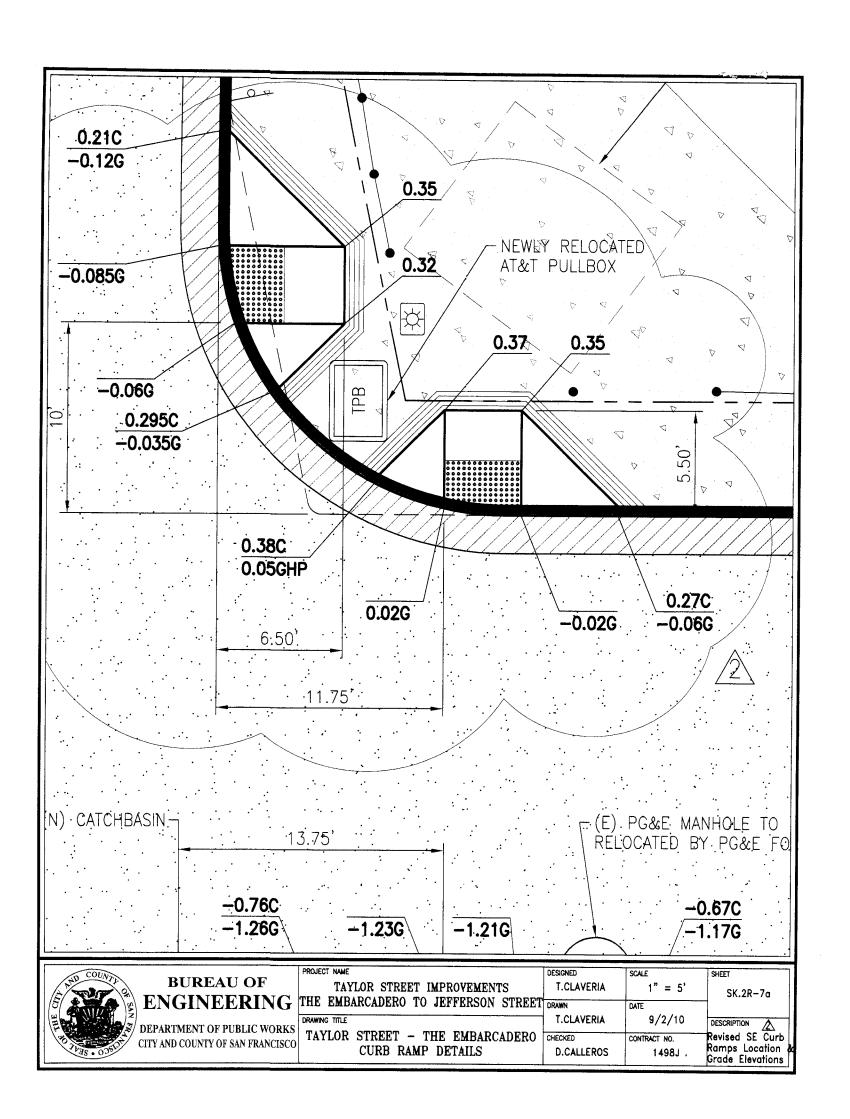

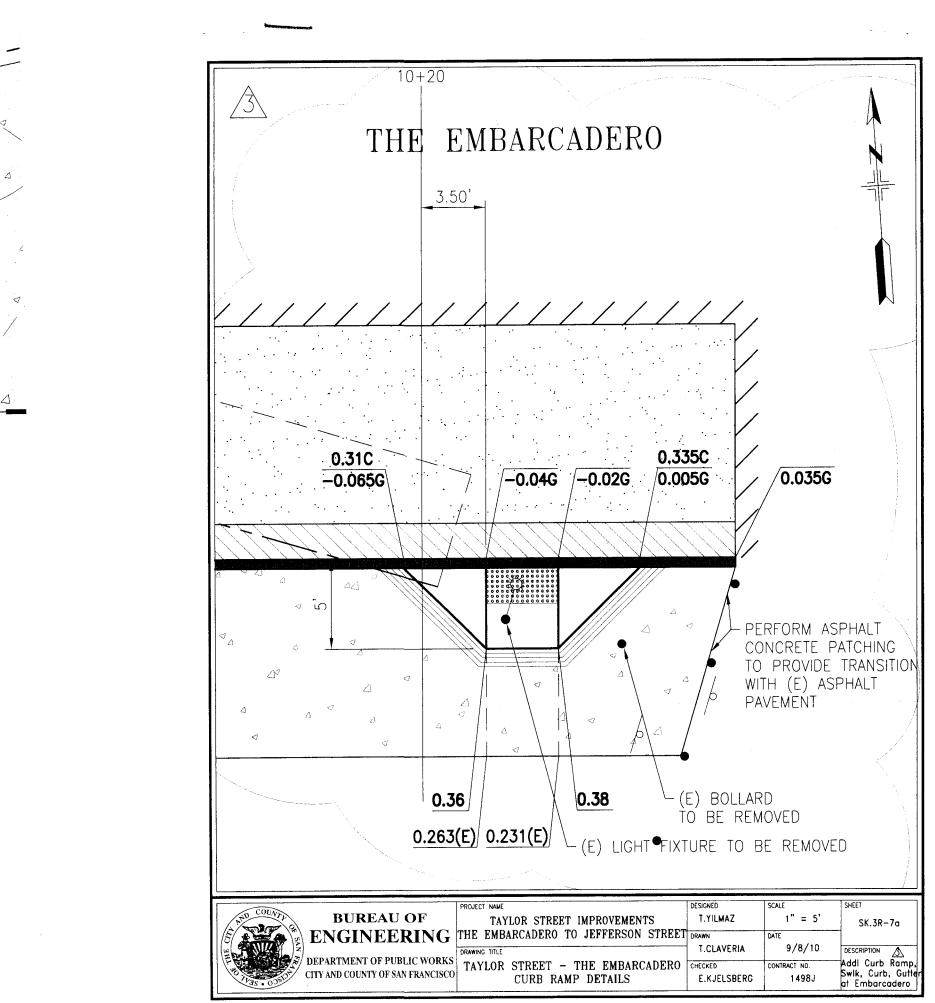


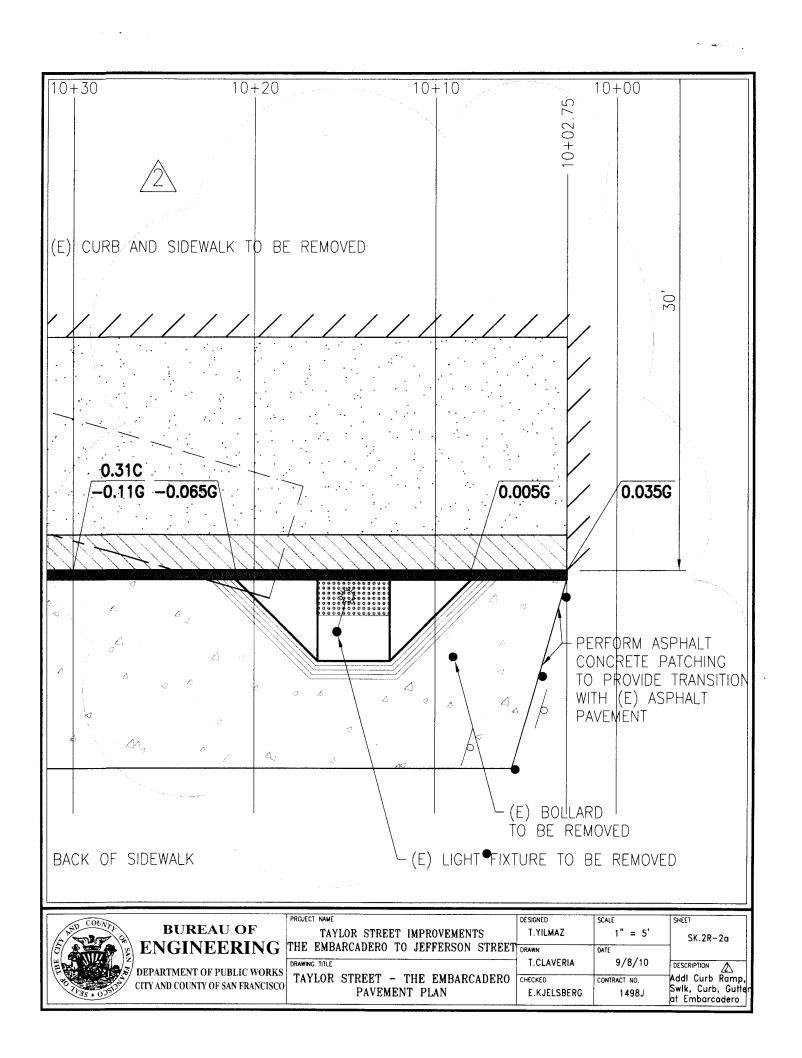



PLANS ARE TO BE RETURNED WITH CORRECTIONS MADE AND CERTIFIED TO IN RED INK AND DATED BY THE INSPECTOR IN CHARGE UPON COMPLETION OF THE WORK BEFORE FIRST MADE.

3 OF **39**

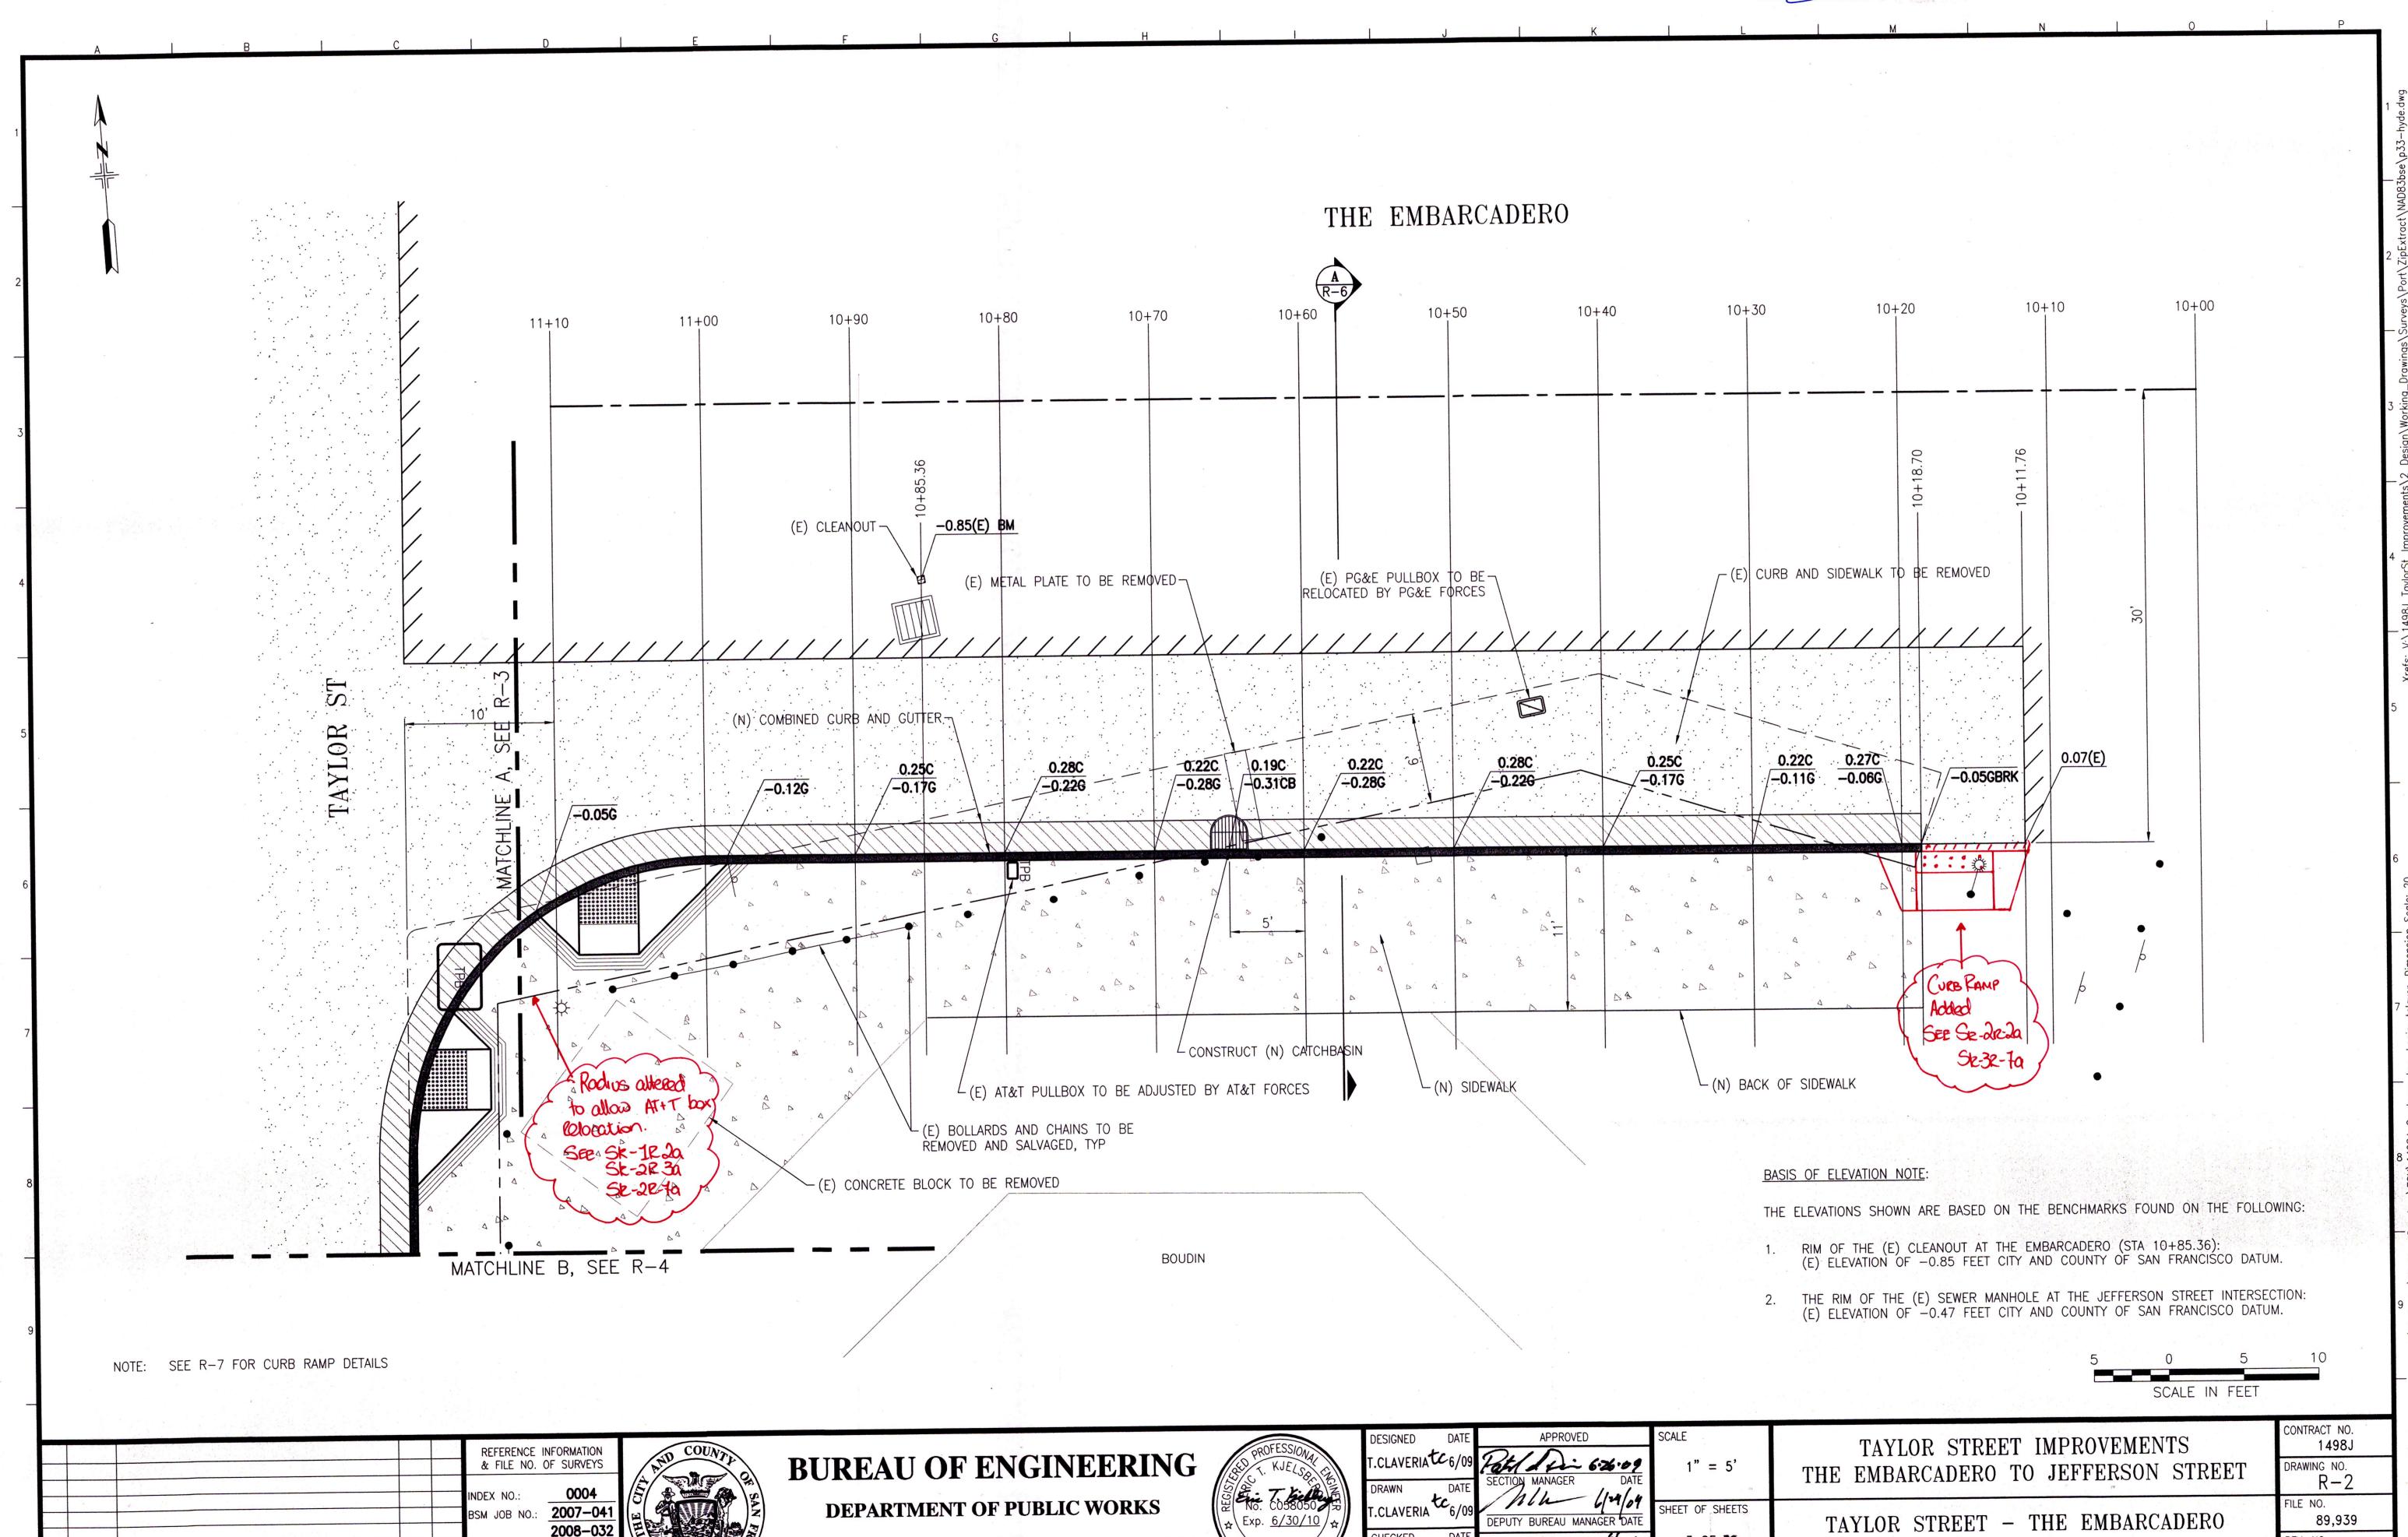

CITY AND COUNTY OF SAN FRANCISCO

2008-032

BY APP. DATE OF SURVEY: **8/29/07**5/15/08

DESCRIPTION


TABLE OF REVISIONS
CHECK WITH TRACING TO SEE IF YOU HAVE LATEST REVISION

NO. DATE


REV. NO.

PAVEMENT PLAN

AS BUILT
Signed:

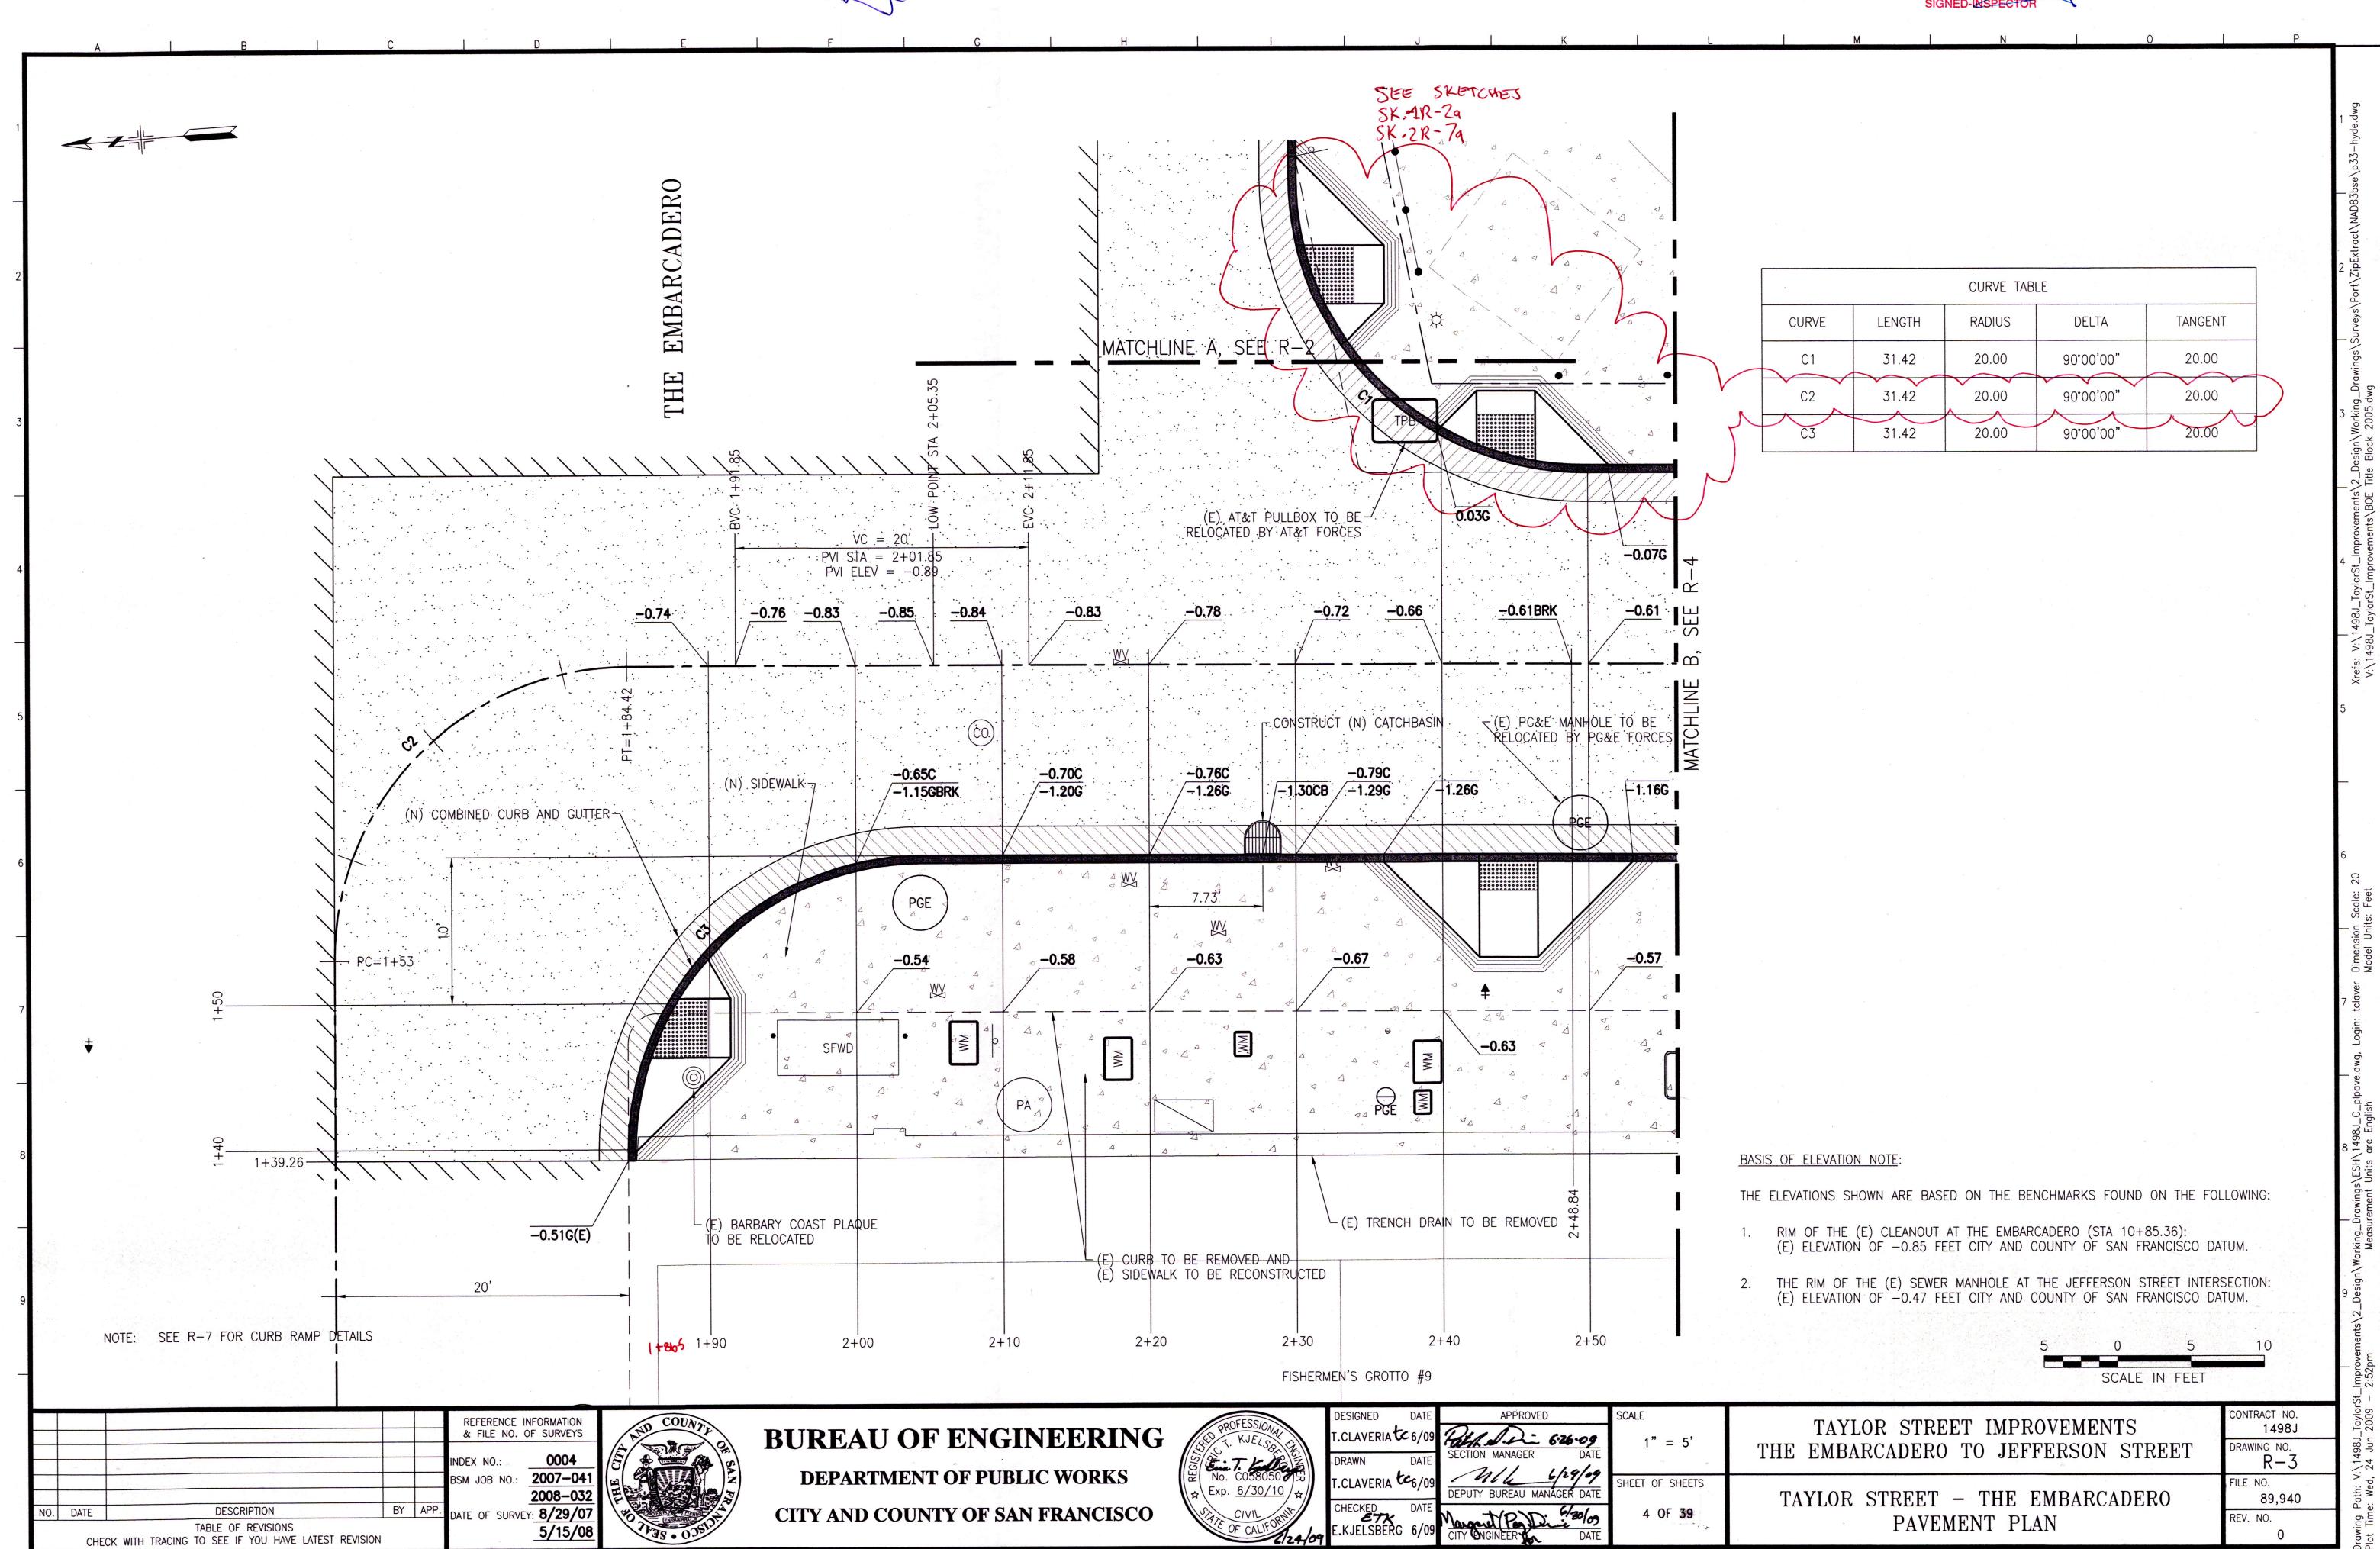



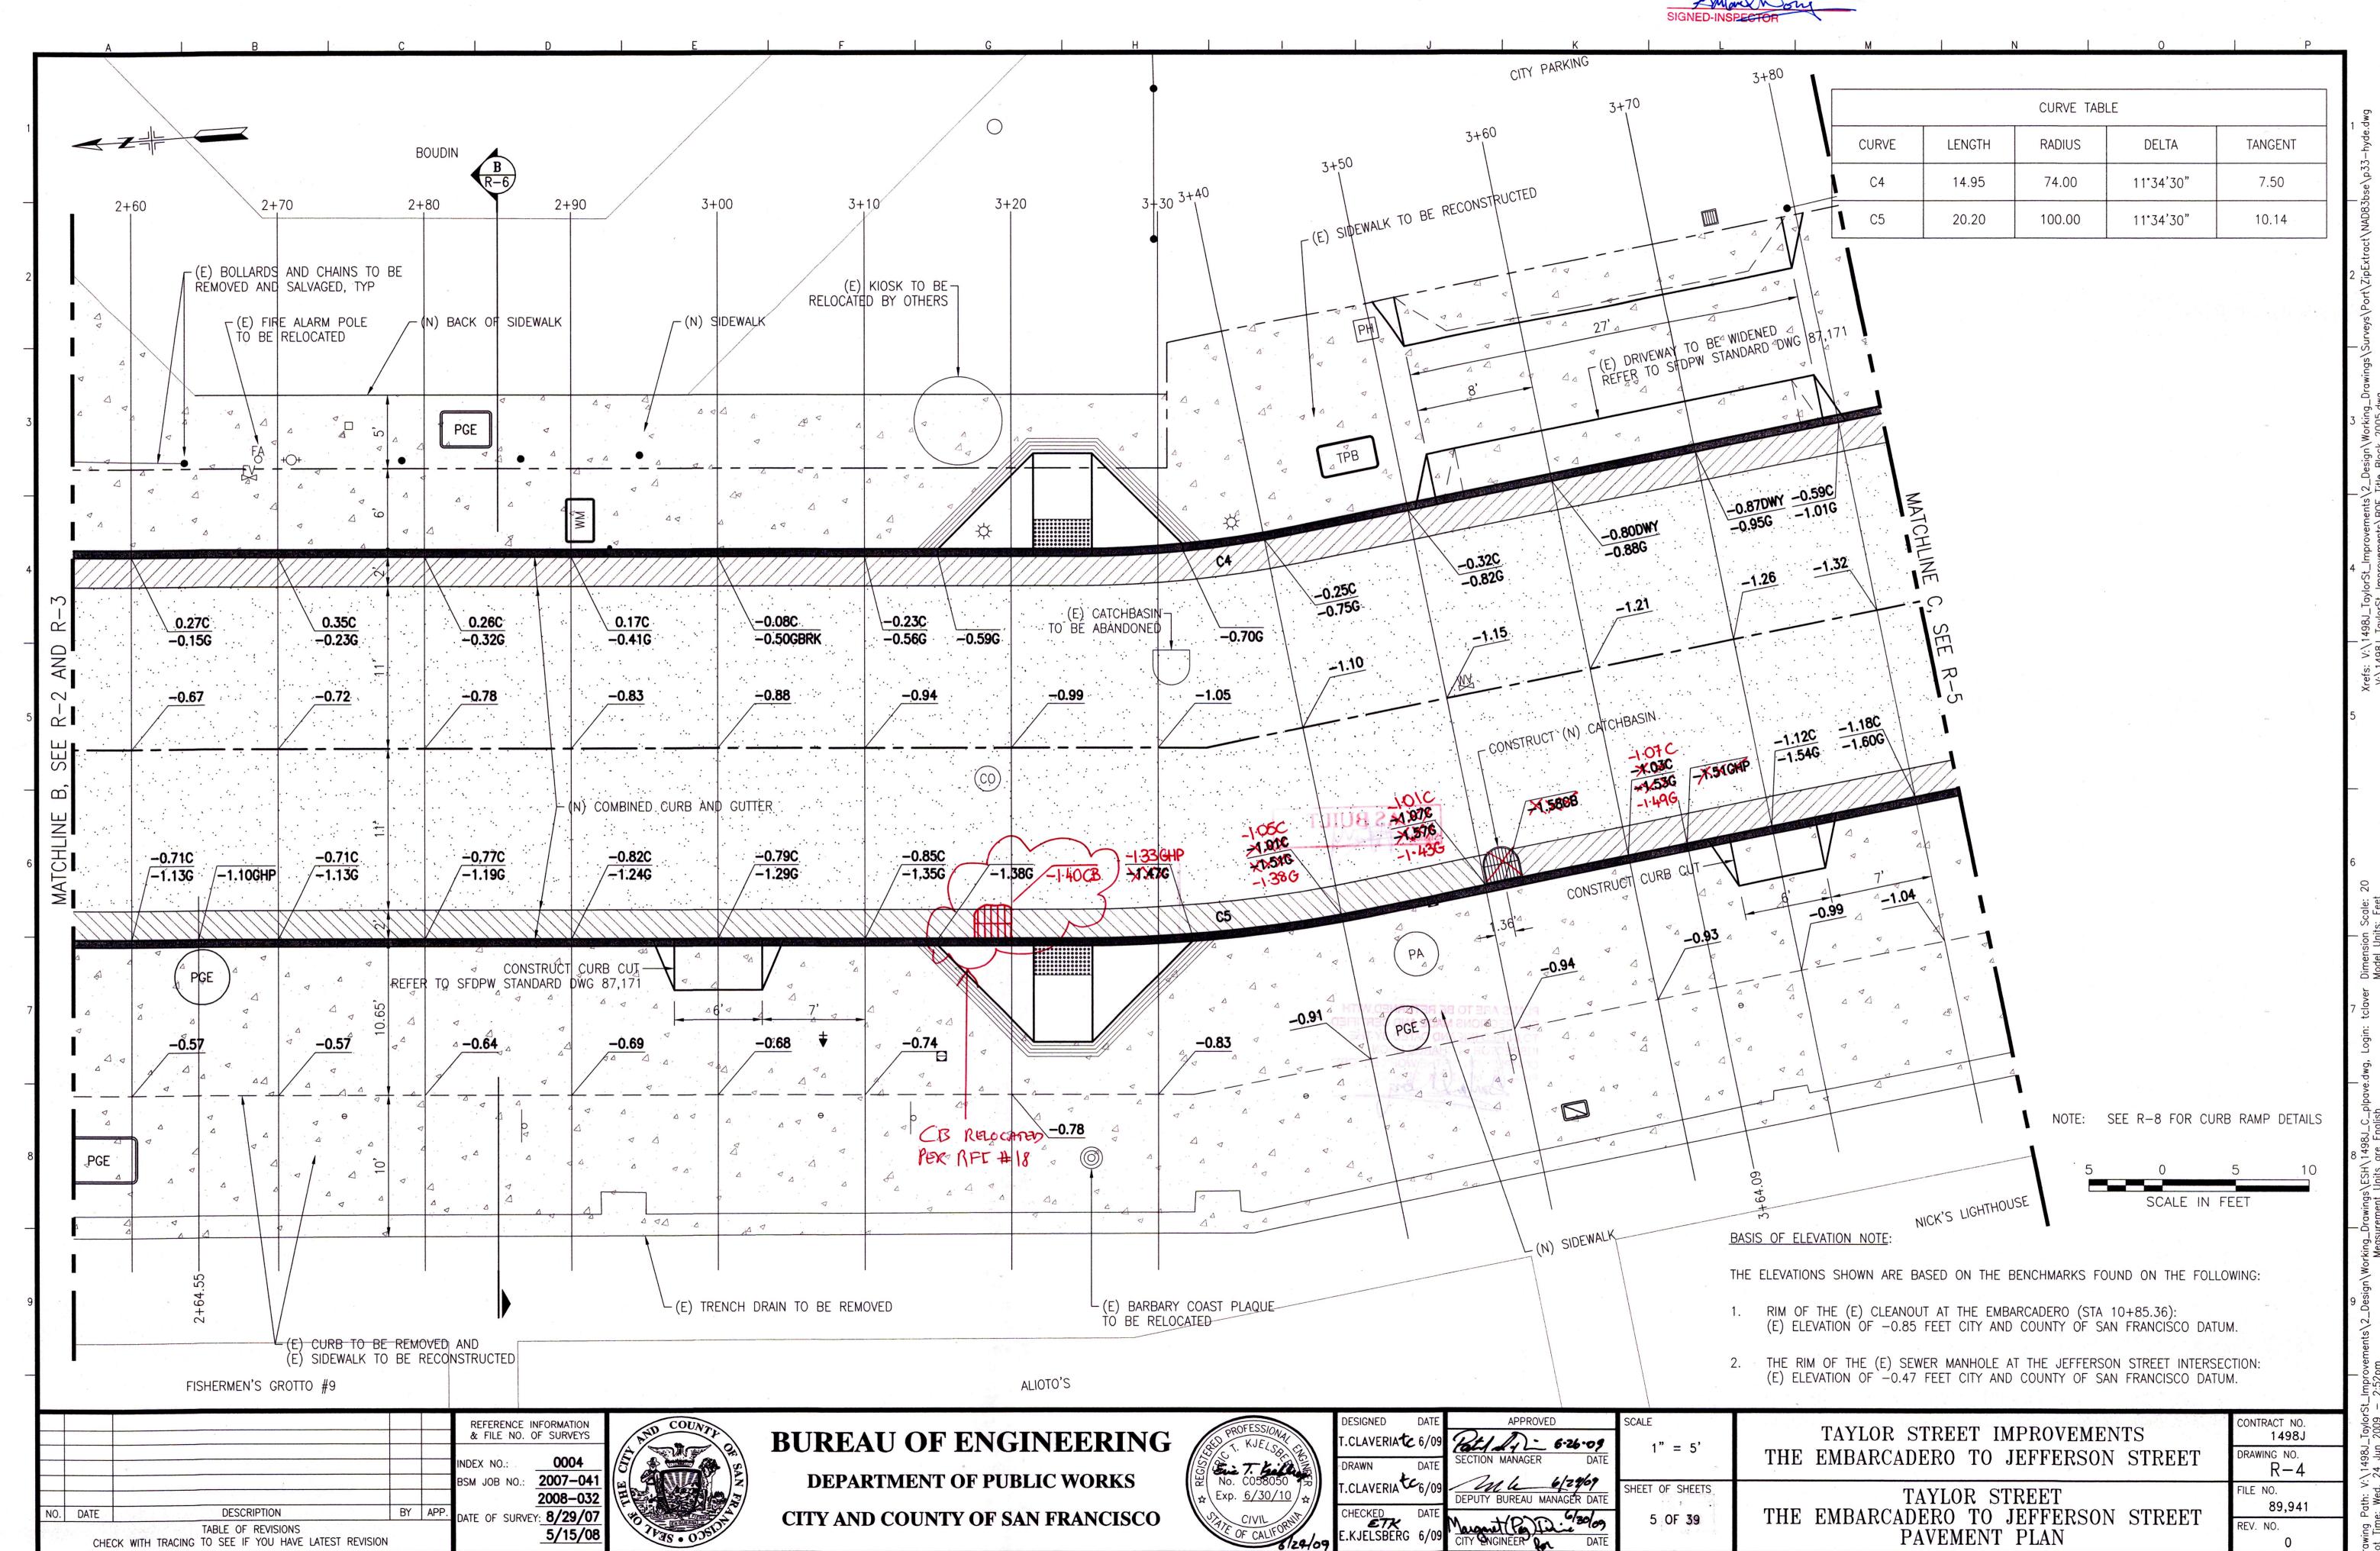


PGE

BUREAU OF

CONFORM TO

(E) ELEV


OD-SS

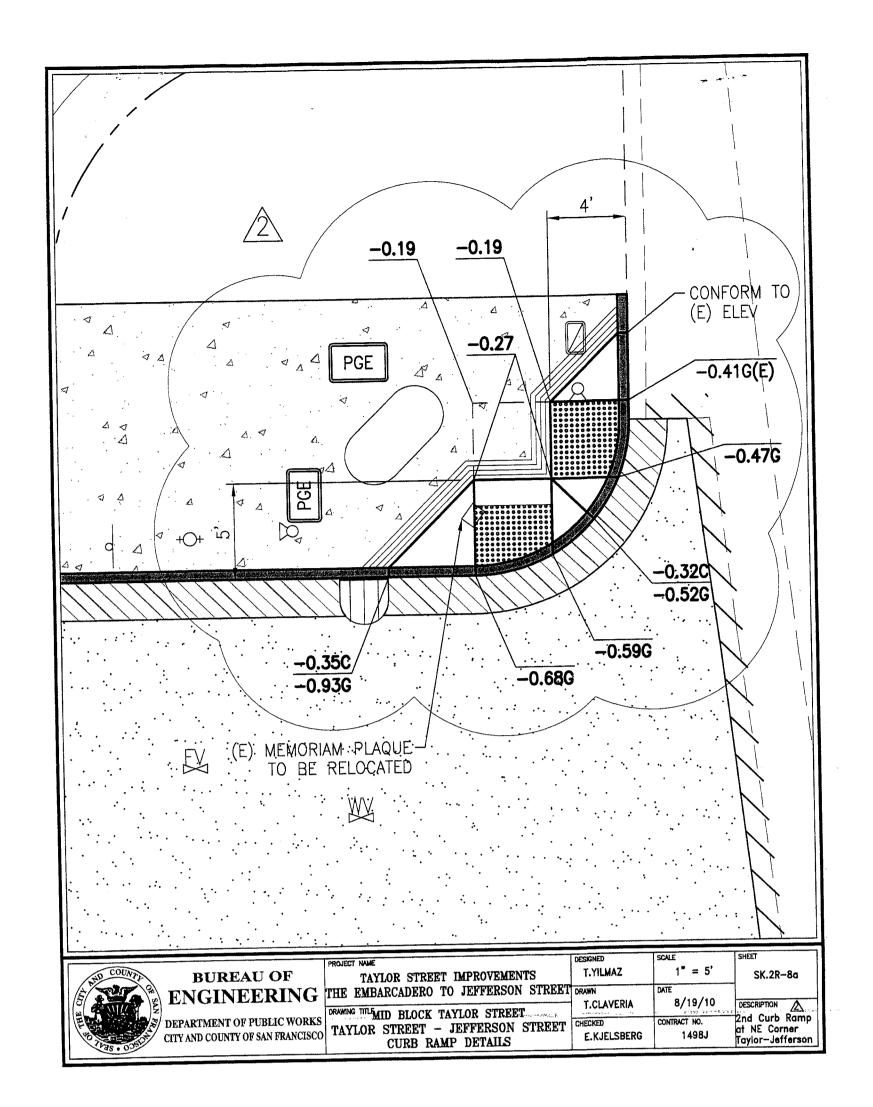



PLANS ARE TO BE RETURNED WITH CORRECTIONS MADE AND CERTIFIED TO IN RED INK AND DATED BY THE INSPECTOR IN CHARGE UPON COMPLETION OF THE WORK BEFORE THE ALL OF THE WORK BEFORE THE WORK BEFOR



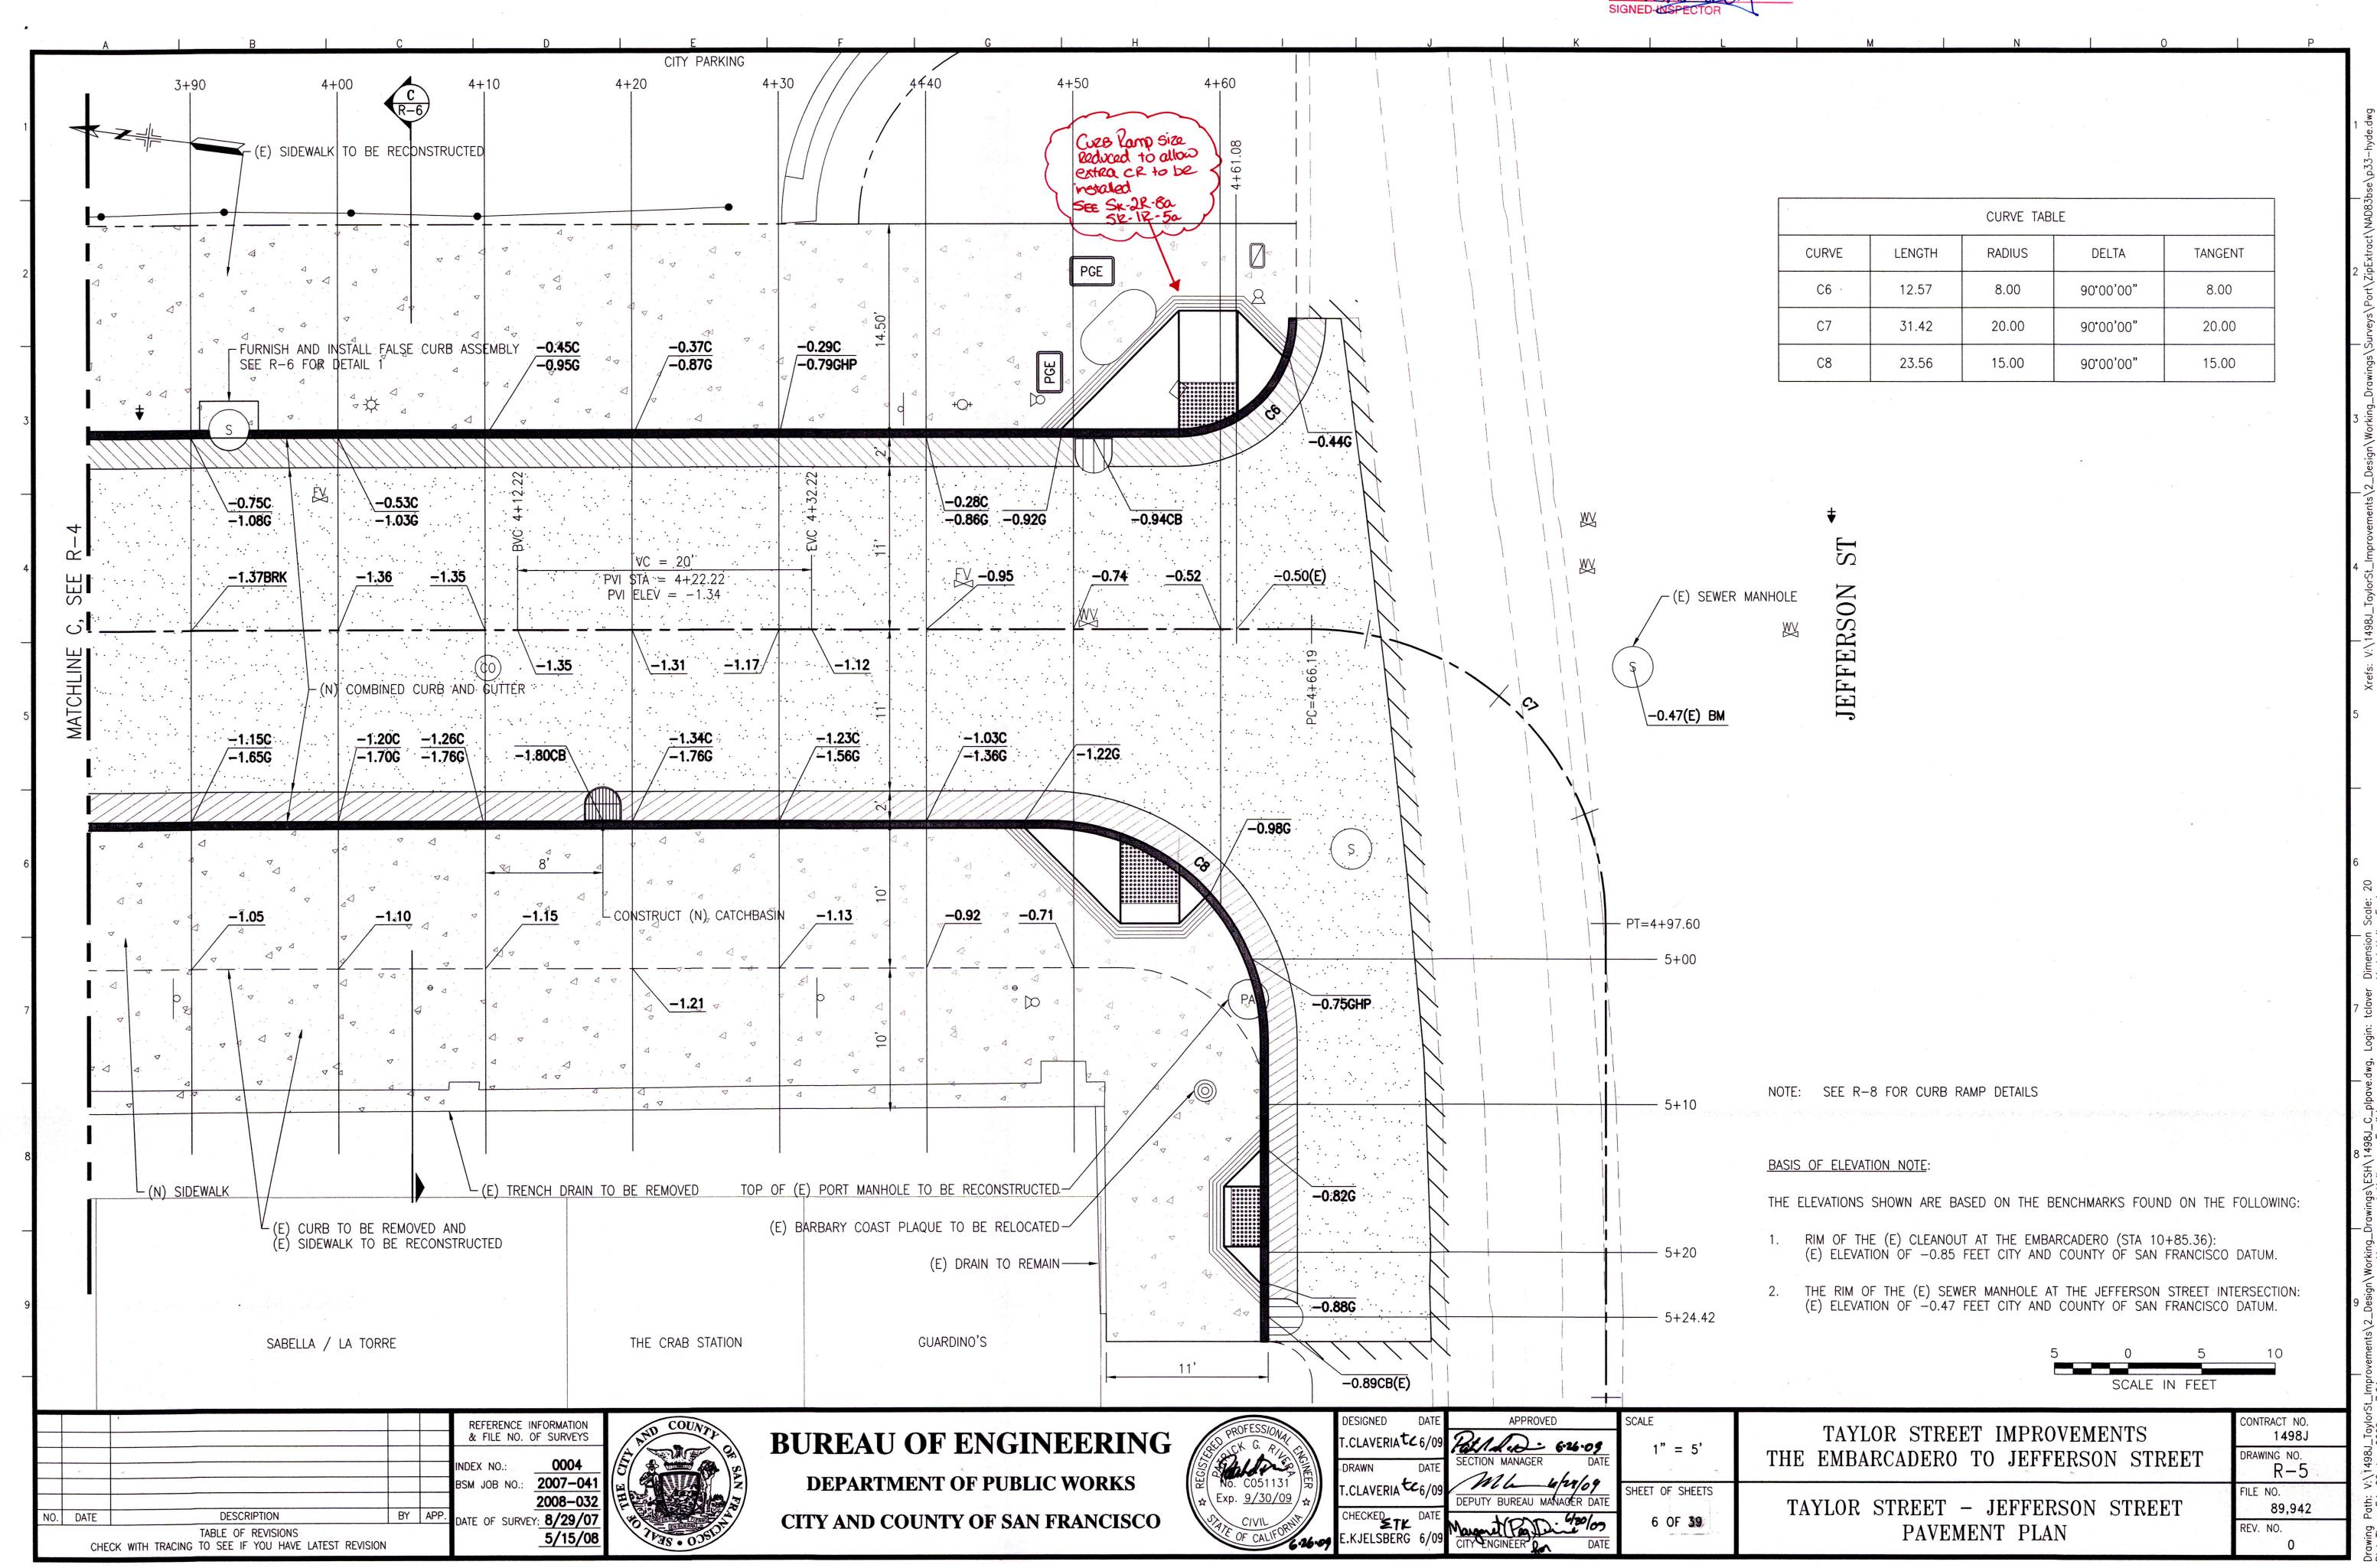


89,943

REV. NO.

TYPICAL CROSS SECTIONS



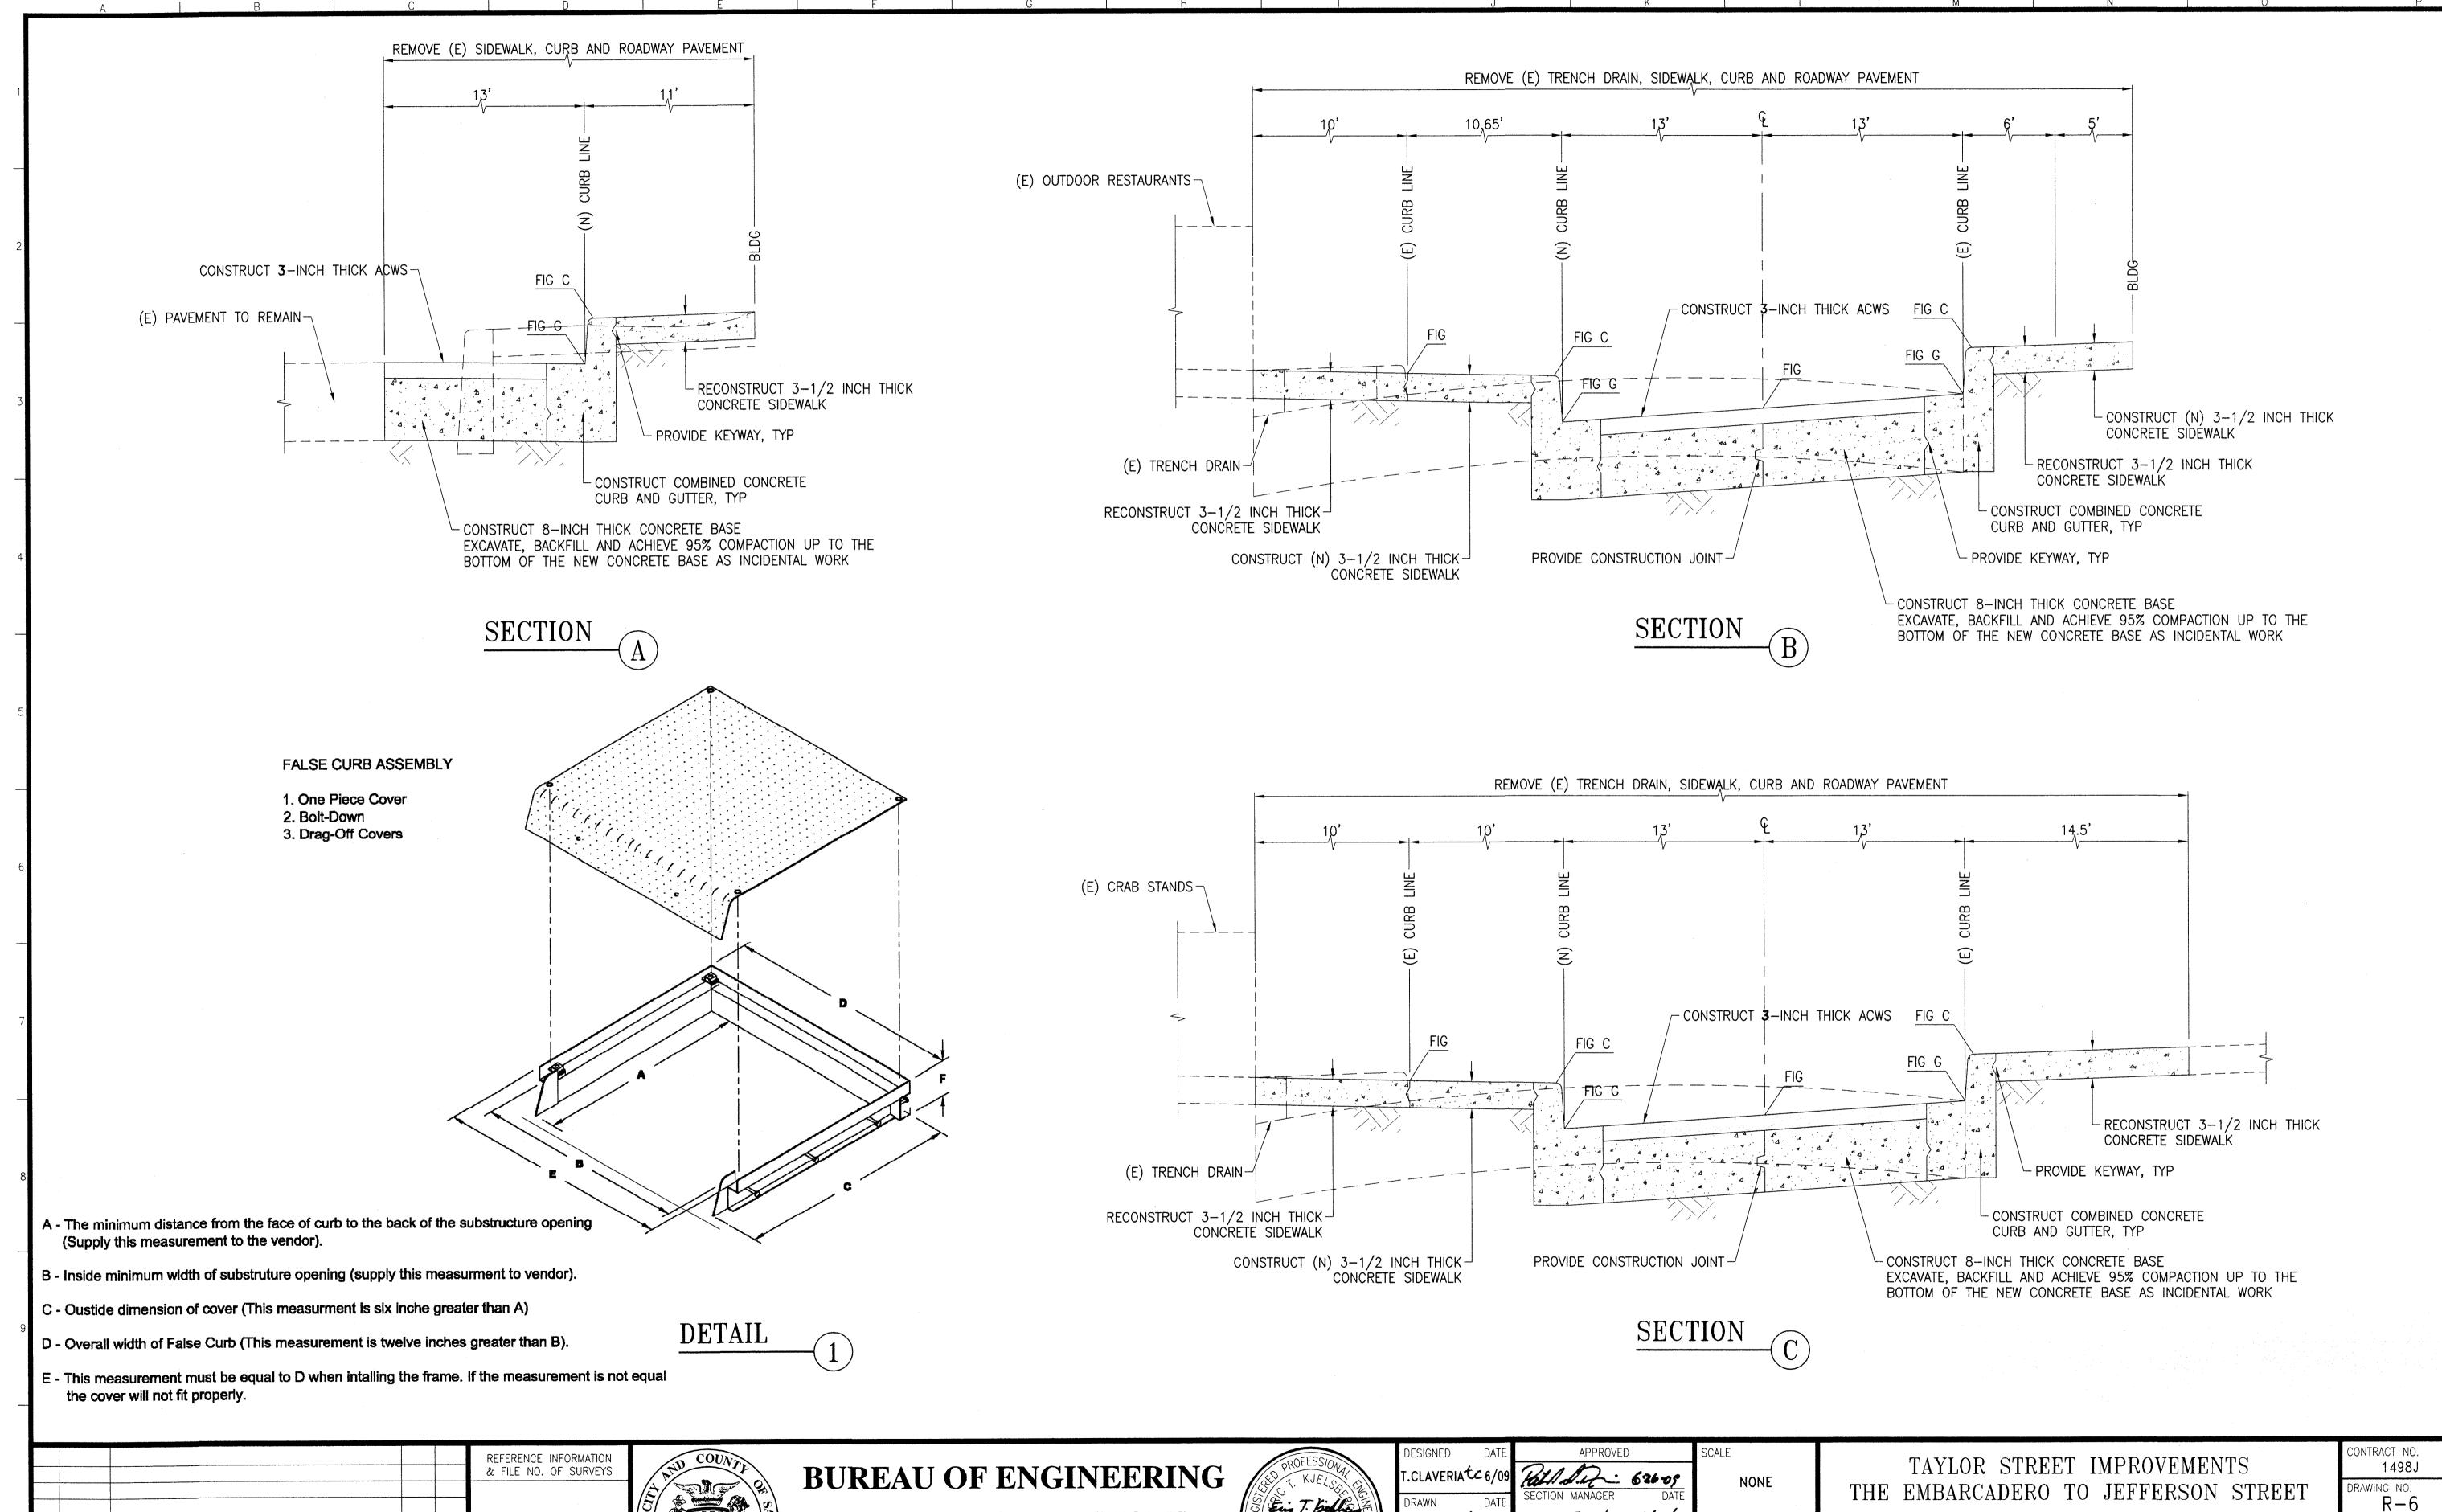

No. C058050

T.CLAVERIA C6/09

7 OF 39

DEPARTMENT OF PUBLIC WORKS


CITY AND COUNTY OF SAN FRANCISCO

DESCRIPTION

TABLE OF REVISIONS
CHECK WITH TRACING TO SEE IF YOU HAVE LATEST REVISION

DATE

CHECK WITH TRACING TO SEE IF YOU HAVE LATEST REVISION

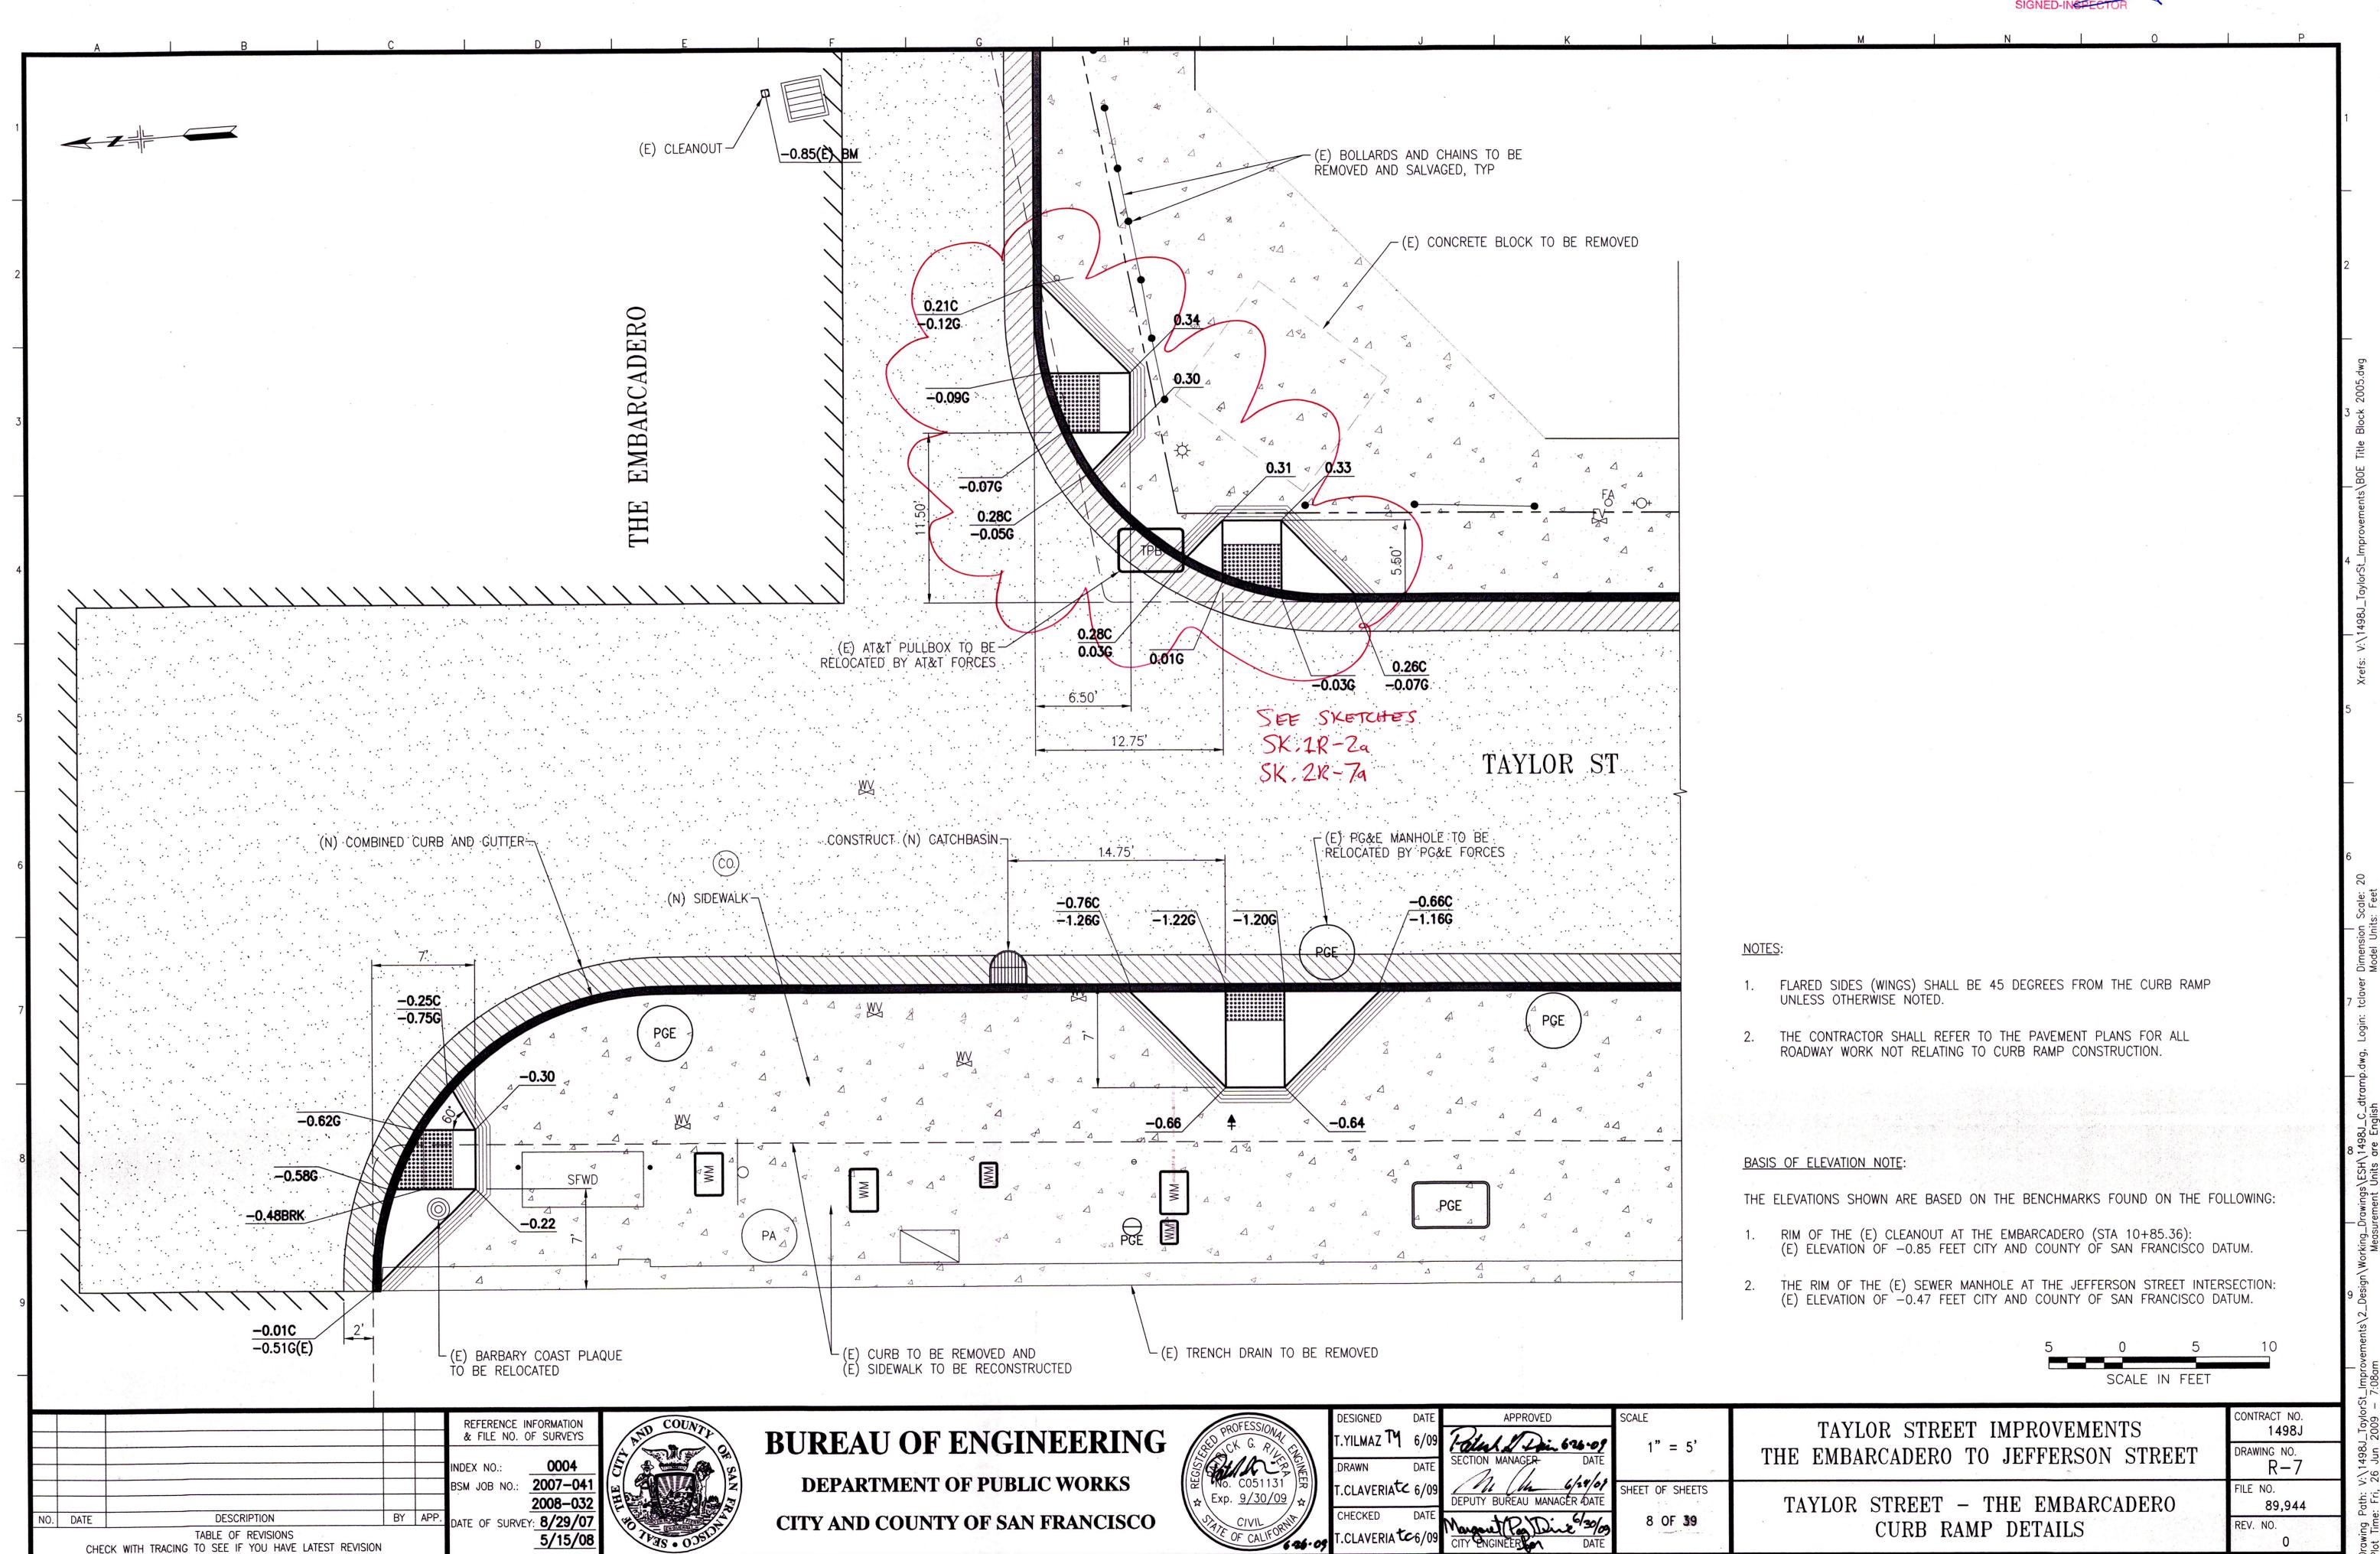


PLANS ARE TO BE RETURNED WITH TO IN <u>RED INK</u> AND DATED BY THE INSPECTOR IN CHARGE UPON COMPLETION OF THE WORK BEFORE

89,945

REV. NO.

9 OF **39**

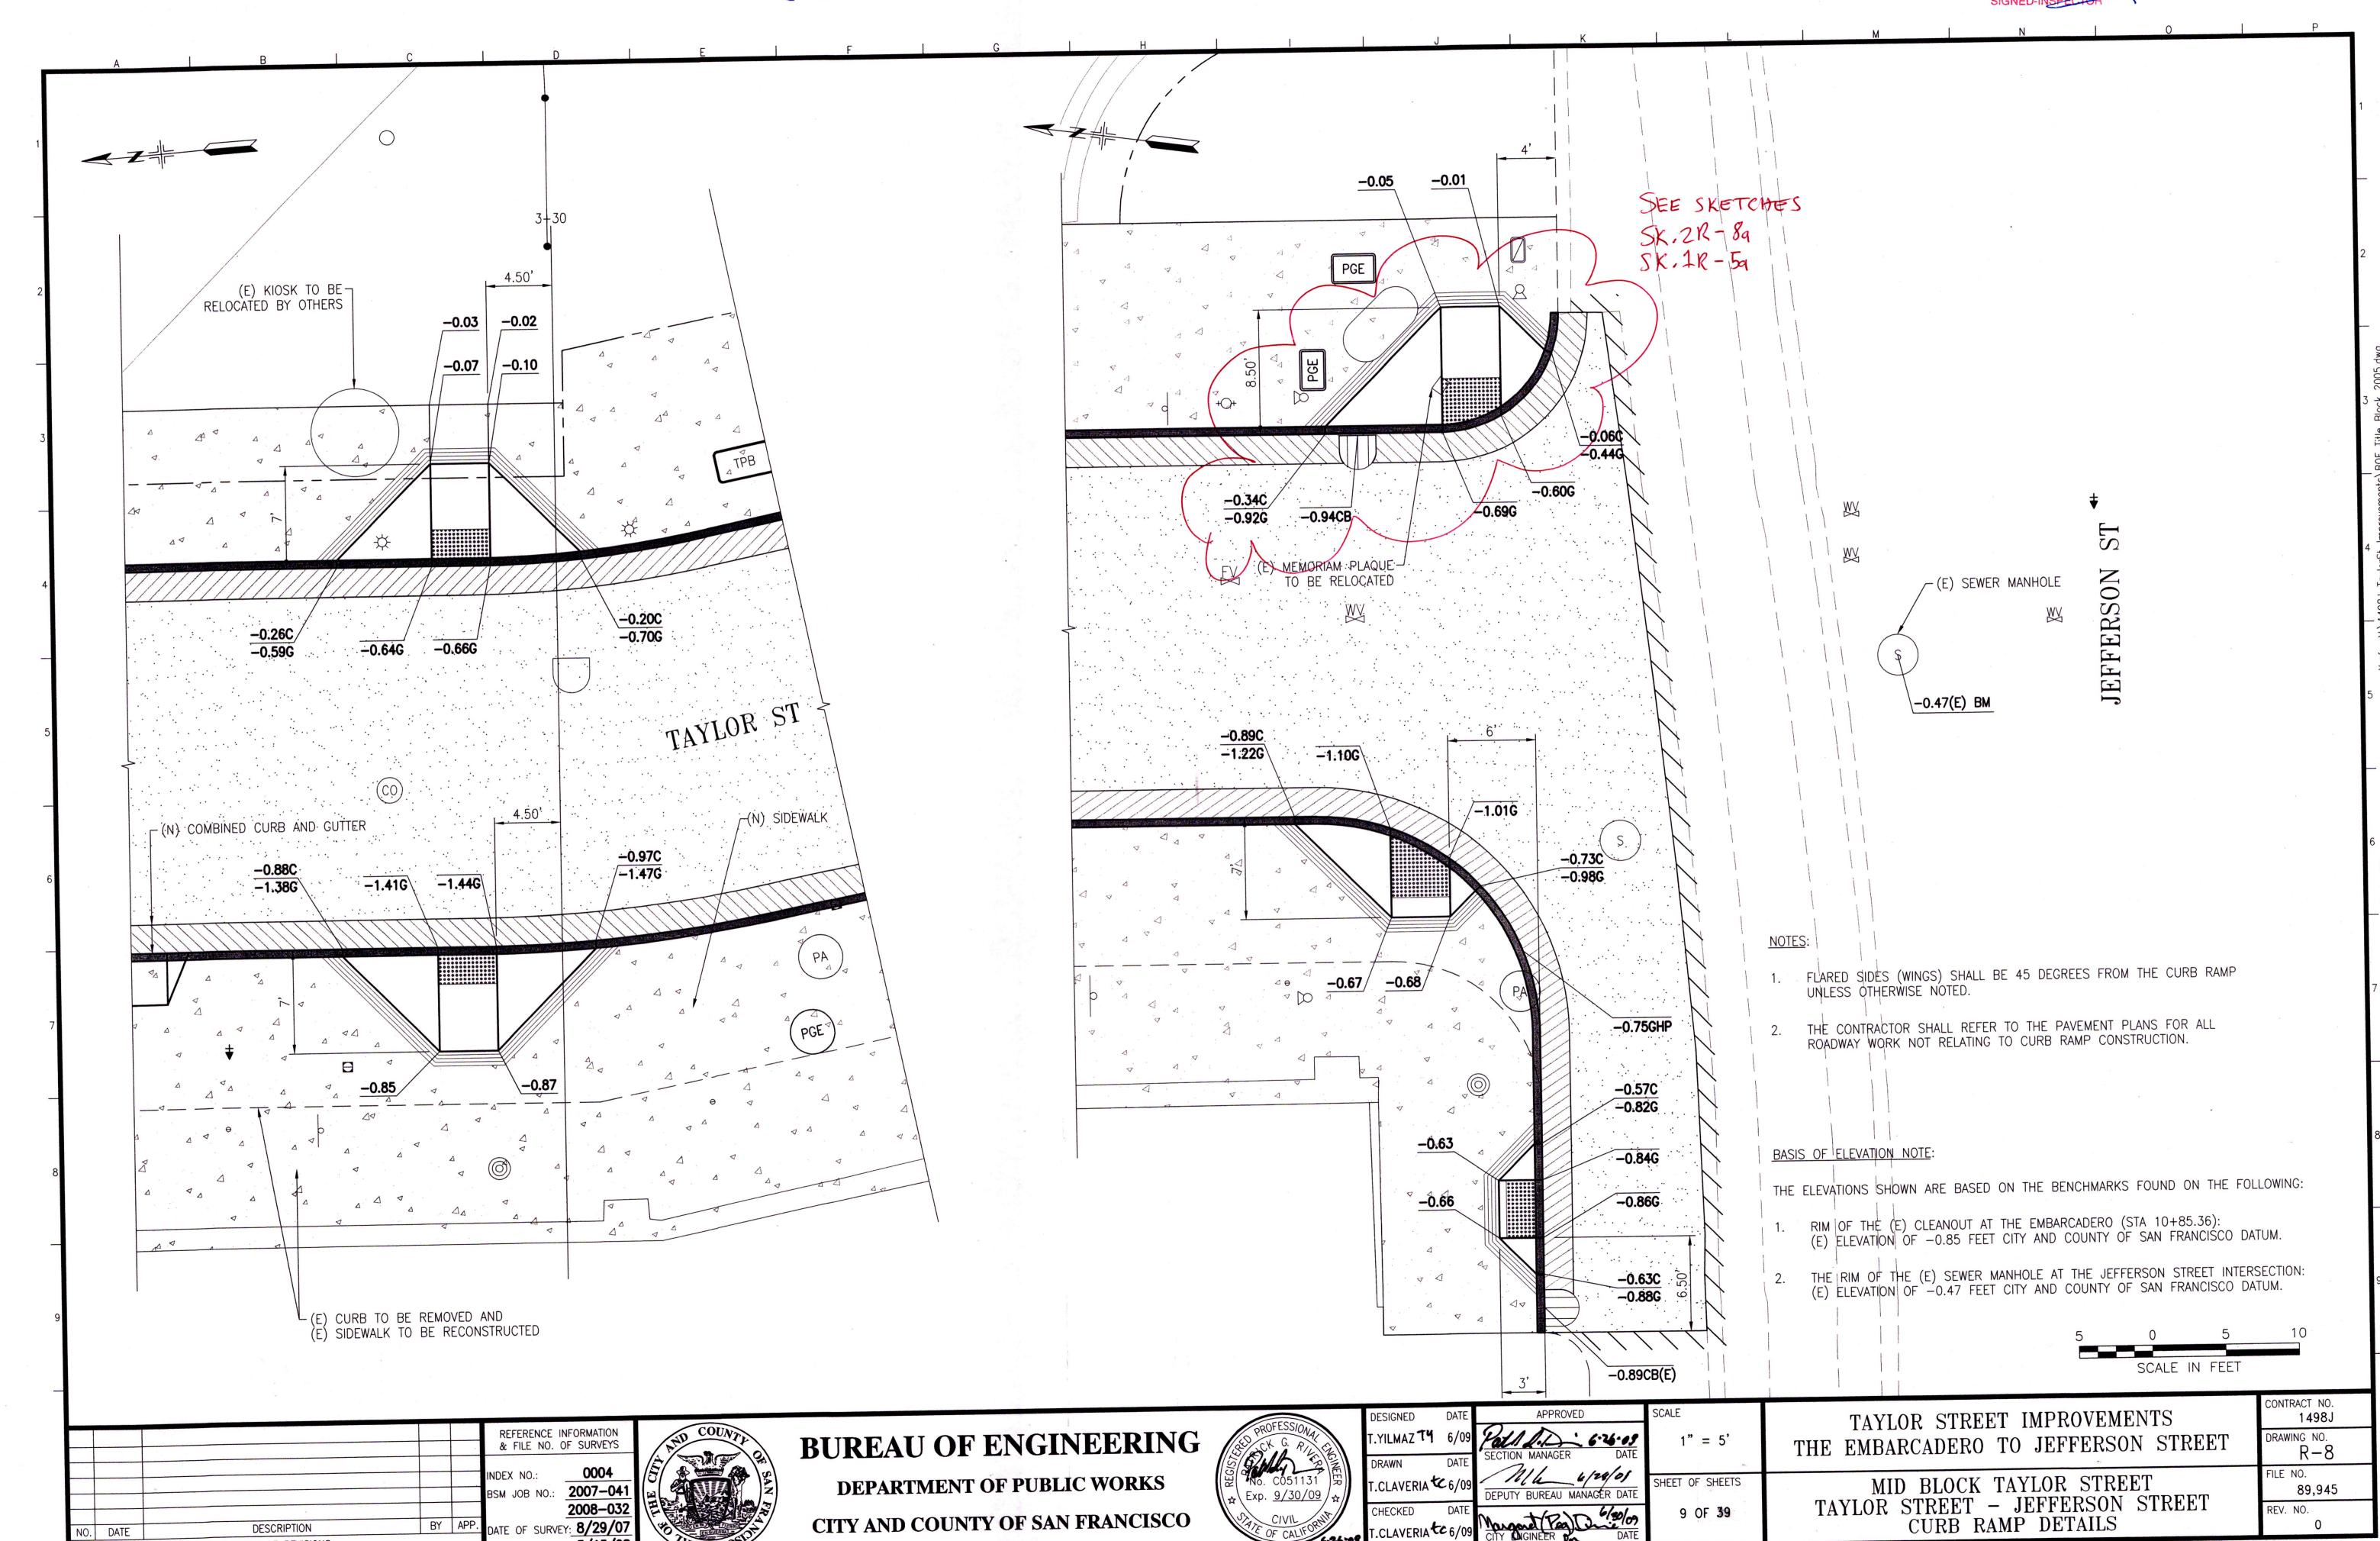

CITY AND COUNTY OF SAN FRANCISCO

DATE OF SURVEY: 8/29/07

5/15/08

DESCRIPTION

TABLE OF REVISIONS
CHECK WITH TRACING TO SEE IF YOU HAVE LATEST REVISION


NO. DATE



<u>LEGEND</u>		ABBRI	EVIATIONS
SIZE & TYPE	EXISTING SEWER OR CULVERT	±	PLUS OR MINUS
0, [5]	EXISTING MH	ACWS	ASPHALT CONCRETE WEARING SURFACE
	EXISTING CB, SWI	APPROX AVE	APPROXIMATE AVENUE
L.J, LJ	EXISTING CB, SWI EXISTING SIDE SEWER (SS) W/ AIR VENT	AWSS	AUXILIARY WATER SUPPLY SYSTEM
⊞	EXISTING SIDE SEWER (33) W/ AIR VENT EXISTING CRAB POT / FLOOR SINK INLET	B&S	BELL AND SPIGOT
ш	, , , , , , , , , , , , , , , , , , ,	BLVD BRK	BOULEVARD
	EXISTING MUNI TRACKS	CB	BRICK CATCHBASIN
10 10 10 10 10 10 10 10 10 10 10 10 10 1	EXISTING MUNI OVERHEAD WIRES	CF	CUBIC FEET
MUNI MUNI	EXISTING MUNI DUCT BANK	CH CIPL	CHANGE CURED IN-PLACE LINER
SIZE & TYPE	NEW SEWED OD CHIVEDT	CO	CLEAN OUT
	NEW SEWER OR CULVERT	CONC	CONCRETE
0	NEW MH PER SFDPW STD PLAN 87,181	C-C CY	CENTER TO CENTER
	NEW MH PER SFDPW STD PLAN 87,182	DET	CUBIC YARD DETAIL
	REPLACE (E) MH PER SFDPW STD PLAN 87,181	DIA OR Ø	DIAMETER
<u>O</u>	MORTAR (E) MH	DIP	DUCTILE IRON PIPE
		DWG E	DRAWING EAST
	ABANDON EXISTING MH	(E)	EXISTING
	REPLACE (E) MH PER SFDPW STD PLAN 87,182	EF	EACH FACE
		EMBED EL	EMBEDMENT ELEVATION
⊖	3'ø MH W/ TRAP ON OUTLET & GRATED COVER	ENGR	ENGINEER
\otimes	3'Ø MH W/ TRAP ON OUTLET & SOLID COVER	EQ	EQUAL
V		EW HDPE	EACH WALL HIGH DENSITY POLYETHYLENE PIPE
	NEW CLEAN OUT	HORIZ	HÖRIZONTAL
		ID	INSIDE DIAMETER
	EXISTING MH	INV ISP	INVERT IRON STONE PIPE
71		LF	LINEAR FEET
	NEW MH	MAX	MAXIMUM
		MH MIN	MANHOLE MINIMUM
	MORTAR (E) MH	N	NORTH
		(N)	NEW
77	REPLACE EXISTING MH	NIC NO.	NOT IN CONTRACT NUMBER
		NTS	NOT TO SCALE
	ABANDON EXISTING MH	OC	ON CENTER
	ADAINDON EXISTING MIT	OD DED	OUTSIDE DIAMETER
× ×	DEMOVE EVICTING AND	PEP PL	POLYETHYLENE PIPE PROPERTY LINE
×	REMOVE EXISTING MH	RC	REINFORCED CONCRETE
©	EXISTING SURVEY MONUMENT	RCP S	REINFORCED CONCRETE PIPE SOUTH
\cap	NEW CB PER SFDPW STD PLAN 87,188	SF	SQUARE FEET
	REPLACE (E) CB PER SFDPW STD PLAN 87,188	S.F. SFDPW	SAN FRANCISCO SAN FRANCISCO DEPARTMENT
	ABANDON (E) CB		OF PUBLIC WORKS
cars	、	SPECS	SLOPE SPECIFICATIONS
<u> </u>	NEW SS PER SFDPW STD PLAN 87,196	SS	SIDE SEWER
·	NEW 6" OR 8"Ø SS CONNECTION TO MAIN SEWER	ST [*] STD	STREET STANDARD
	PLUG EXISTING FACILITIES	SWI	STORM WATER INLET
+***	PLUG AND FILL EXISTING FACILITIES	THRU	THROUGH
	APPROXIMATE PAVEMENT SURFACE	(TYP) VERT	TYPICAL VERTICAL
-	DIRECTION OF FLOW	VCP	VITRIFIED CLAY PIPE
	SLURRY GROUT SHOWN IN SECTION OR PROFILE	W	WEST
		W/ W/O	WITH WITHOUT
		,	,

GENERAL NOTES


- 1. NUMBER AND LOCATIONS OF SIDE SEWER CONNECTIONS ARE APPROXIMATE. CONTRACTOR SHALL VERIFY SIDE SEWER CONNECTIONS IN THE FIELD.
- 2. ALL GROUND SURFACE ELEVATIONS AND INVERT ELEVATIONS TO BE CONFORMED ARE APPROXIMATE.
- 3. ELEVATIONS ARE IN REFERENCE TO S.F. CITY DATUM.
- 4. IN ACCORDANCE WITH THE PROVISIONS OF THE CALIFORNIA PUBLIC CONTRACT CODE SECTION 3300, A BID SUBMITTED TO A PUBLIC AGENCY BY A CONTRACTOR WHO IS NOT LICENSED IN ACCORDANCE WITH CHAPTER 9 OF THE BUSINESS AND PROFESSIONS CODE SHALL BE CONSIDERED NON-RESPONSIVE AND SHALL BE REJECTED BY THE PUBLIC AGENCY.
- 5. AT THE TIME THIS CONTRACT IS BID, THE CONTRACTOR SHALL POSSESS A STATE OF CALIFORNIA CLASS "A" GENERAL ENGINEERING CONTRACTOR'S LICENSE.
- 6. PRIOR TO CONSTRUCTION, THE CONTRACTOR SHALL OBTAIN PERMIT FROM SF PORT AND EXCAVATION PERMIT FROM SFDPW-STREET CONSTRUCTION COORDINATION CENTER LOCATED AT 875 STEVENSON STREET, ROOM 460.
- 7. MAXIMUM TRENCH WIDTH SHALL BE THE LARGER OUTSIDE DIMENSION OF THE NEW OR EXISTING SEWER/STRUCTURE PLUS 1.5 FEET ON EACH SIDE.
- 8. ALL NEW VCP AND RCP MAIN SEWERS SHALL BE CONSTRUCTED ON CRUSHED ROCK PER BEDDING DETAIL SHOWN BELOW UNLESS OTHERWISE NOTED.
- 9. PIPE LENGTH SHOWN ON PROFILE INDICATES HORIZONTAL DISTANCE EXCLUDING INSIDE DIMENSION OF EACH SEWER MANHOLE/STRUCTURE.
- 10. AFTER SEWER WORK HAS BEEN COMPLETED, THE CONTRACTOR SHALL CLEAN ALL CATCHBASINS SHOWN ON SW-DRAWINGS AND REPLACE CAST IRON WATER TRAP AS DIRECTED BY THE RESIDENT ENGINEERS.
- 11. CONTRACTOR SHALL PROTECT ALL SURVEY MONUMENTS AND BENCHMARKS LOCATED WITHIN THE CONTRACT LIMIT. CITY MONUMENTS LOCATED WITHIN 10 FEET OF TRENCH MUST BE REFERENCED PRIOR TO ANY DEMOLITION, AND A CORNER RECORD MUST BE FILED WITH THE COUNTY SURVEYOR'S OFFICE BY CONTACTING BUREAU OF STREET—USE AND MAPPING AT (415)554—5829. THE MONUMENTS MUST BE REVISITED AFTER CONSTRUCTION HAS BEEN COMPLETED TO VERIFY THAT NO MOVEMENT HAS OCCURRED. IF MONUMENTS ARE NOT REFERENCED PRIOR TO CONSTRUCTION, THE CITY WILL CHARGE \$ 7,500 A PIECE TO THE CONTRACTOR FOR REESTABLISHING THE MONUMENT.
- 12. PRIOR TO ABANDONING EXISTING SEWER FACILITIES, CONTRACTOR SHALL VERIFY THAT THERE ARE NO ACTIVE CONNECTIONS TO THESE FACILITIES. CONTRACTOR SHALL NOTIFY RESIDENT ENGINEER IMMEDIATELY OF ANY DISCREPANCIES.

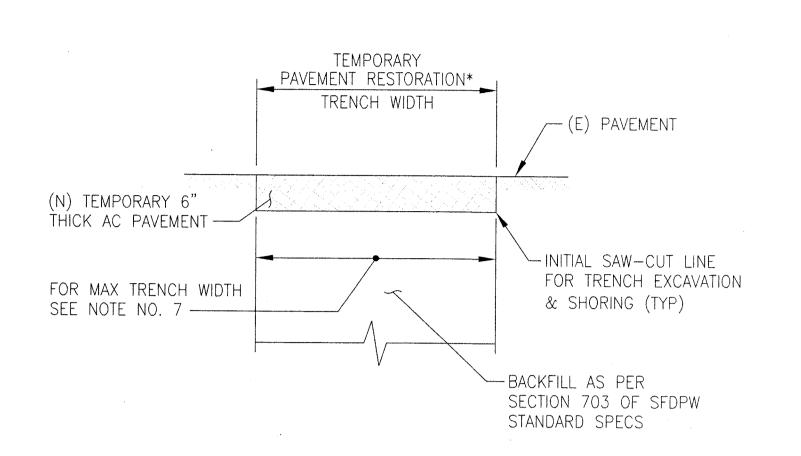

TRENCH RESTORATION DETAIL FOR ASPHALT STREET

NTS

* LIMITS OF TEMPORARY AC PAVEMENT SHALL BE PER THIS DETAIL UNLESS SUBSEQUENT DRAWINGS DELINEATE WIDER AREA TO BE PAVED.

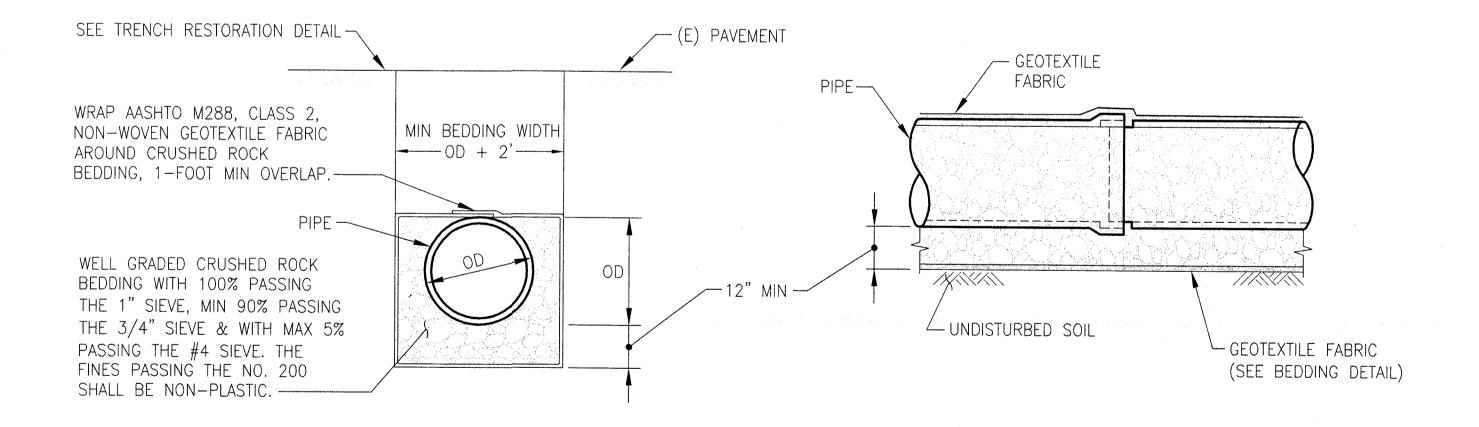


BEDDING DETAIL FOR RIGID PIPE

PIPE INSTALLATION

NTS

					REFERENCE INFO & FILE NO. OF
0	6/09	ISSUED FOR BIDS	JF	ID	
NO.	DATE	DESCRIPTION	BY	APP.	
	CHE	TABLE OF REVISIONS CK WITH TRACING TO SEE IF YOU HAVE LATEST REVISION			

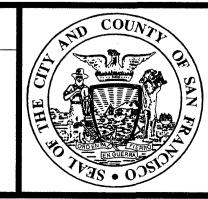

BUREAU OF ENGINEERING

DEPARTMENT OF PUBLIC WORKS
CITY AND COUNTY OF SAN FRANCISCO

ORECOL	DESIGNED
PROFESSIONAL S. DIES CON	JF 54
No. C63097 Exp. 06/10	DRAWN UF FOR JLY EC
OF CALIFORNIA OF CALIFORNIA	CHECKED GF GF
06/46/04	Į.

	DESIGNED	DATE	APPROVED
	JF 54	6/2009	300 Dapa - 6/26/09
	DRAWN	DATE	SECTION MANAGER DATE
	JL/ EC	6/2009	DEPUTY BUREAU MANAGER DATE
	CHECKED	DATE	1600: 7/1
7	GF GF	6/2009	CITY ONGINEER DATE

SCALE	
AS SHOWN	7
SHEET OF SHEETS	
11 OF 39	

TAYLOR STREET IMPROVEMENTS
THE EMBARCADERO TO JEFFERSON STREET

SEWER WORK
LEGEND, ABBREVIATIONS, NOTES AND DETAILS

CONTRACT NO.


SW-1

FILE NO.


EV. NO.


1498J


89,946

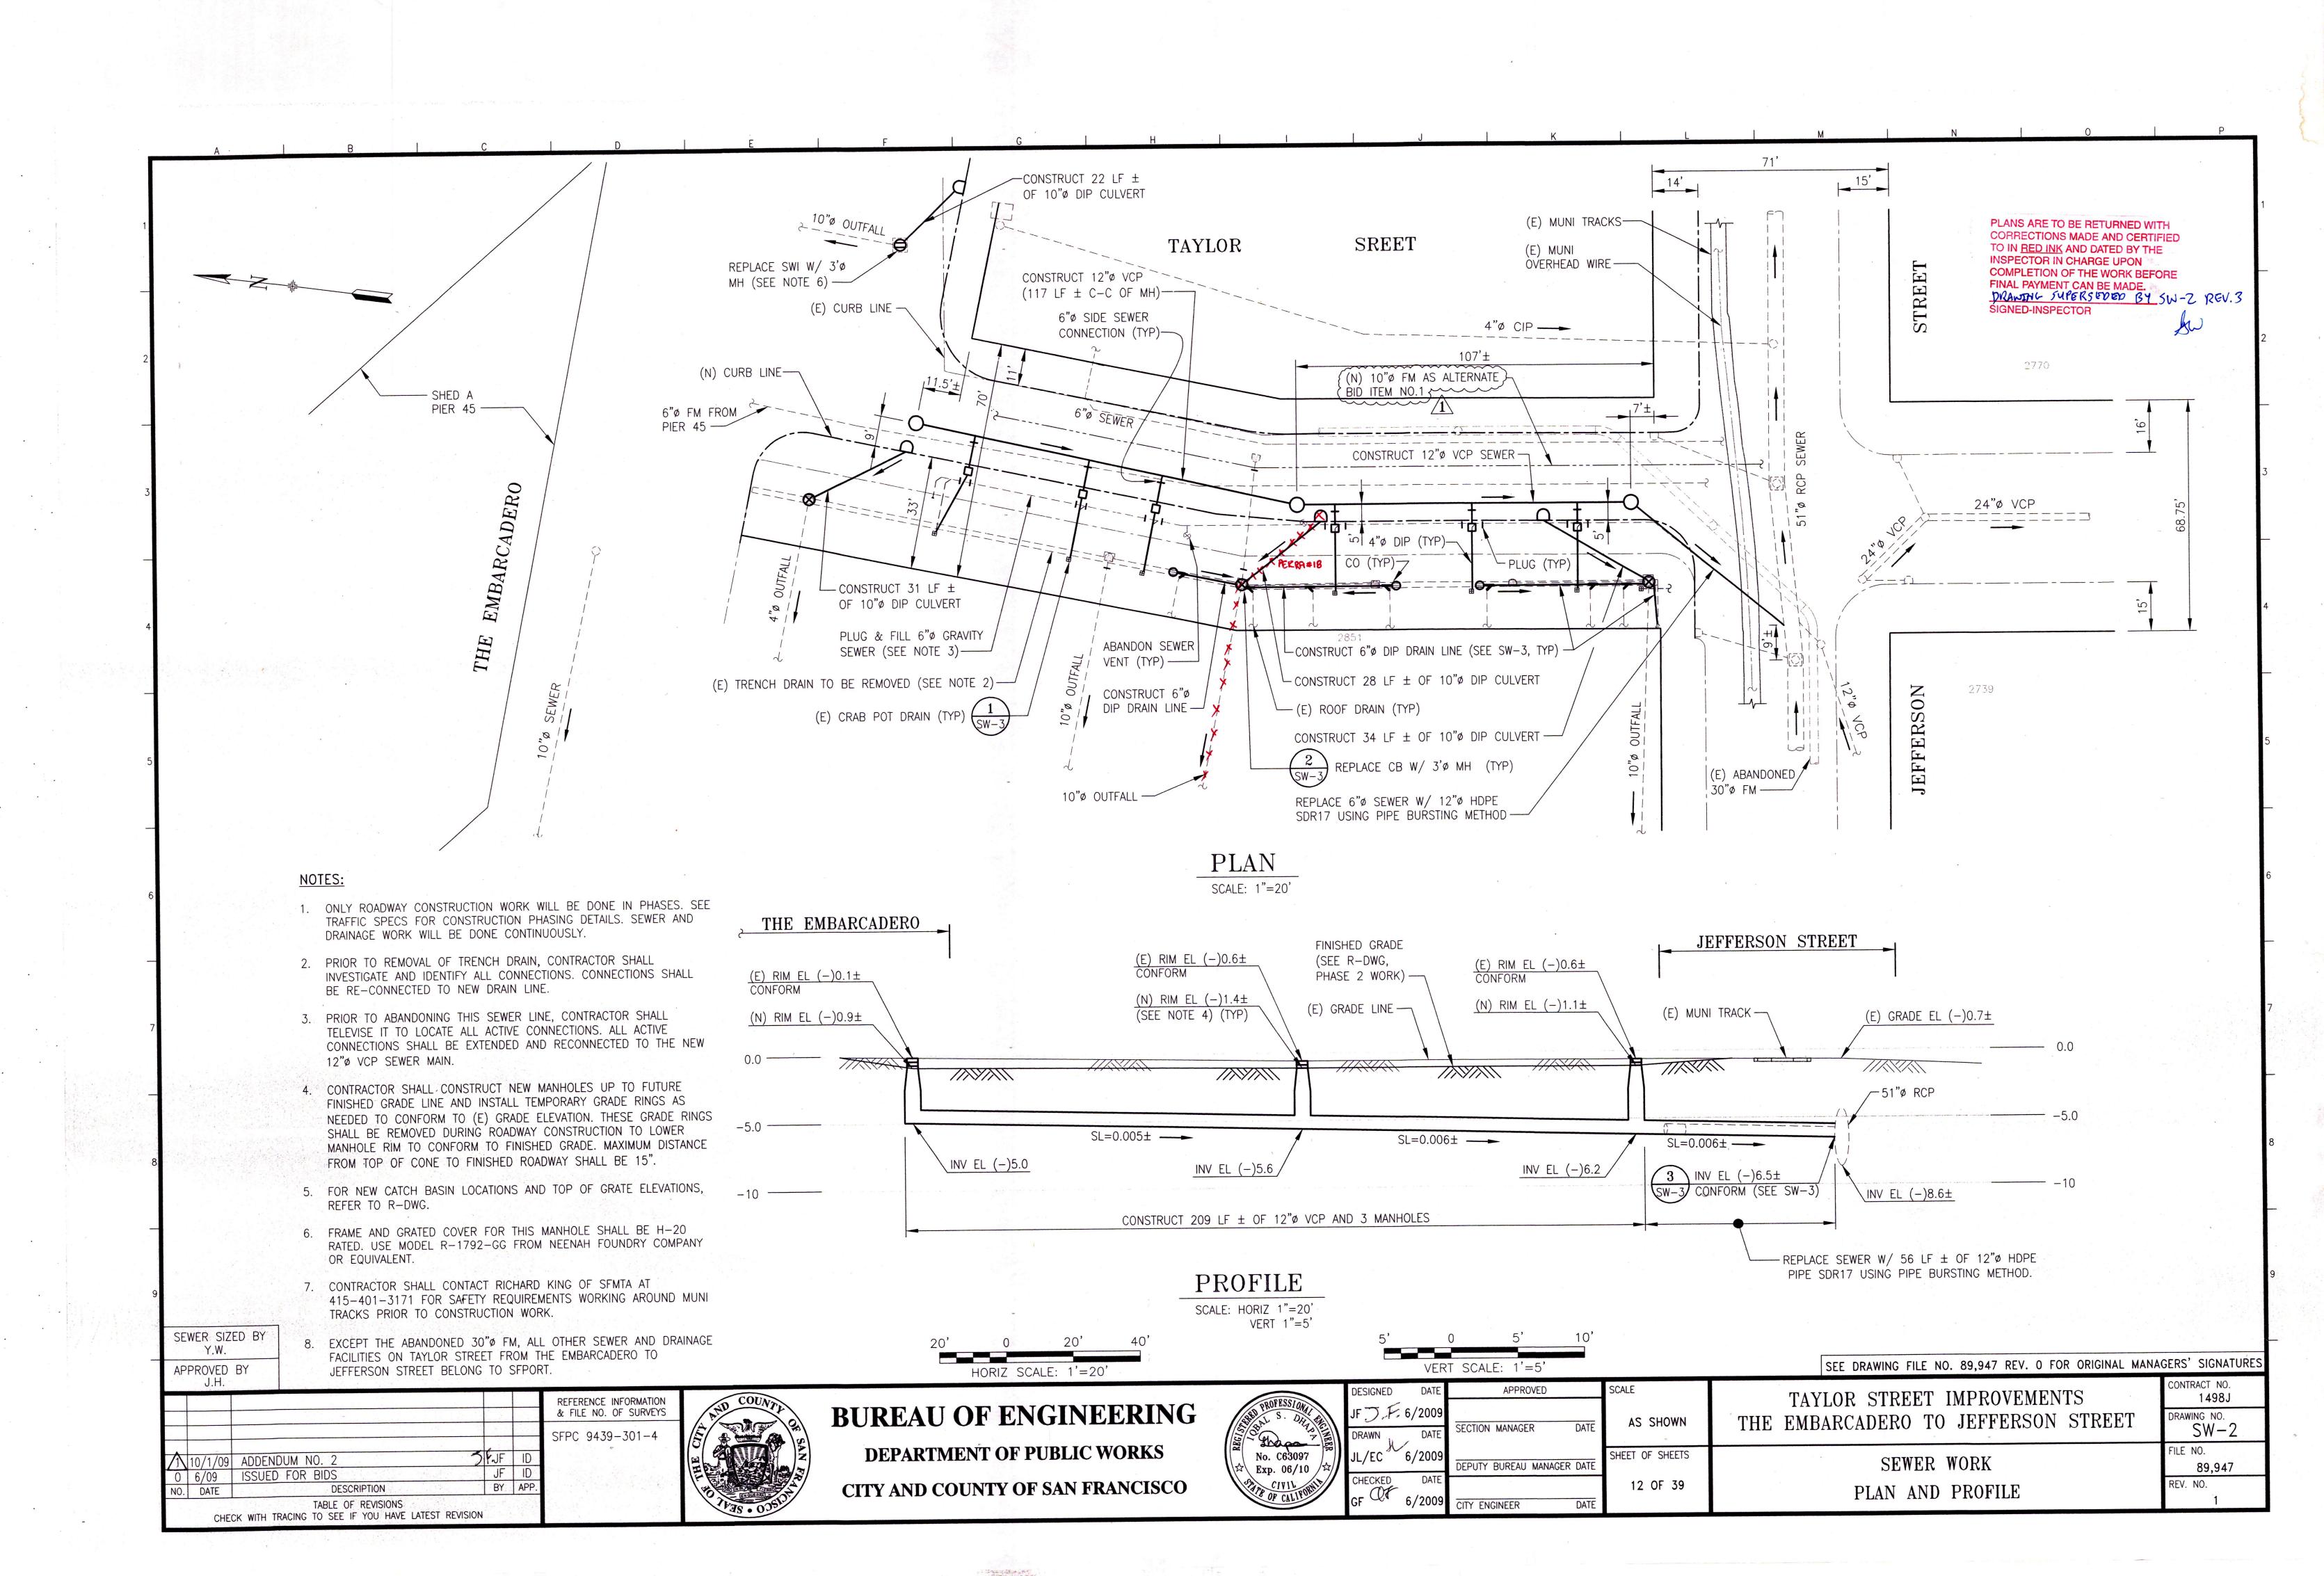




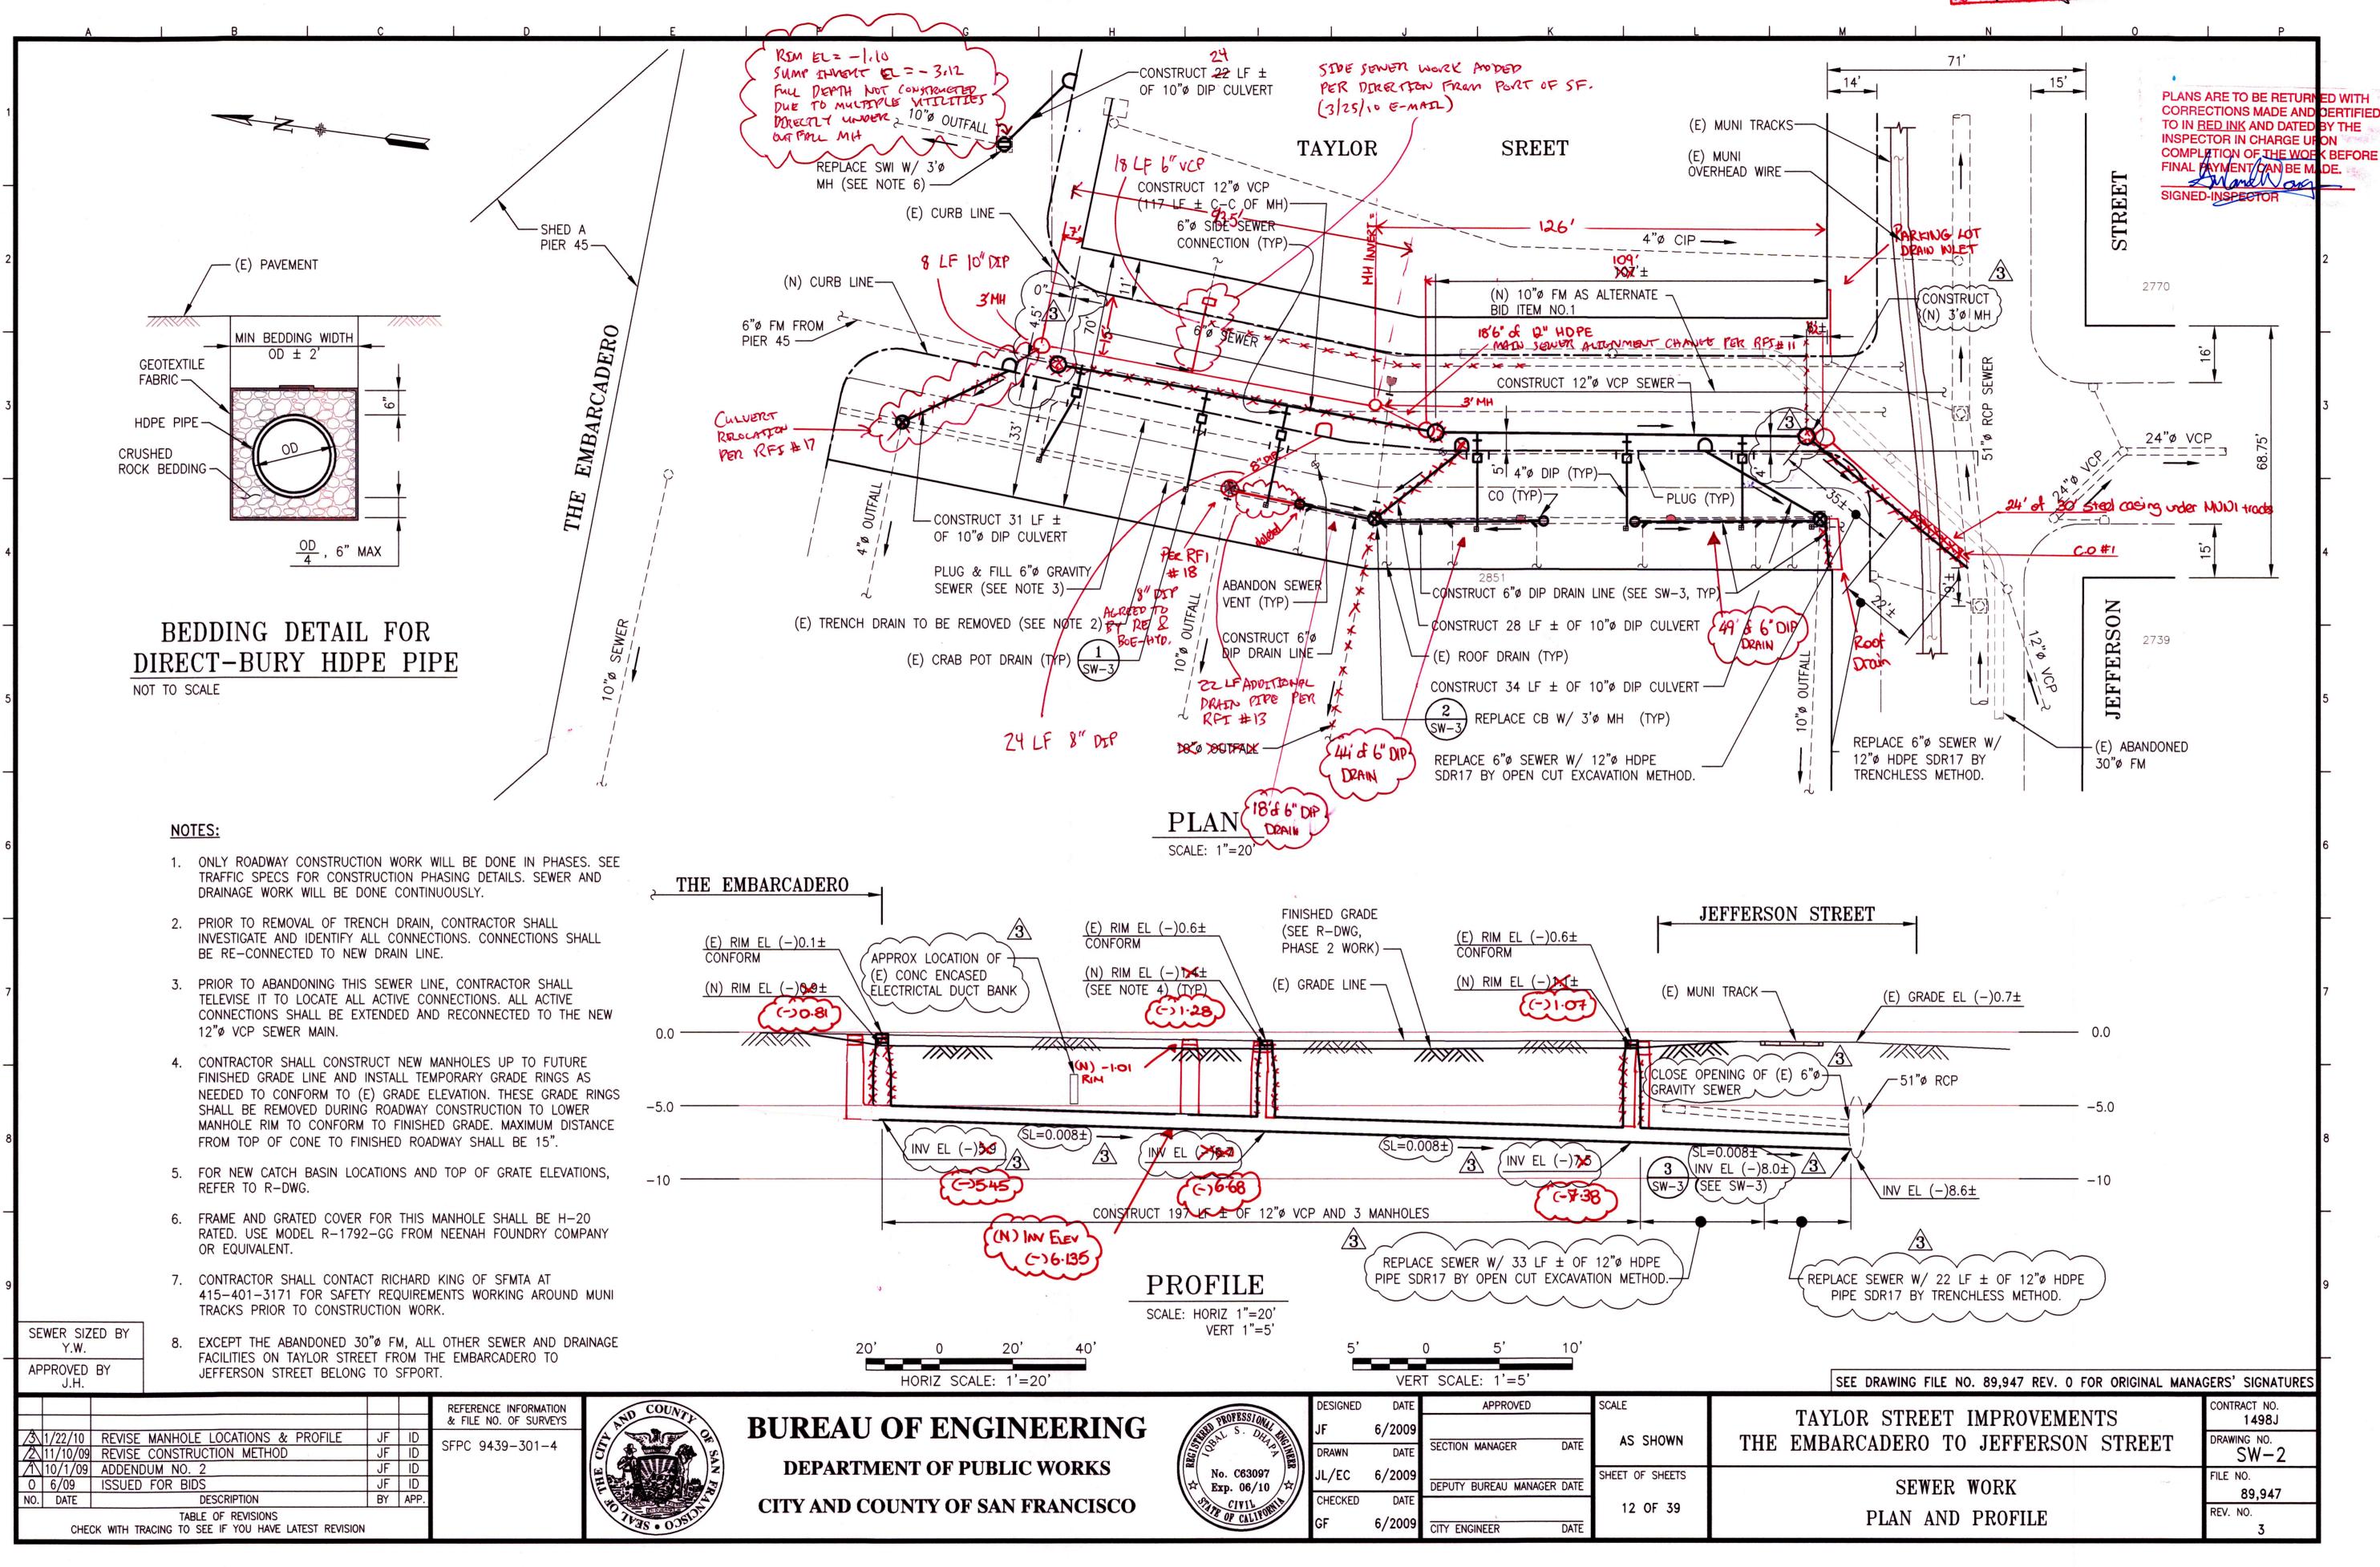

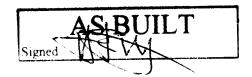


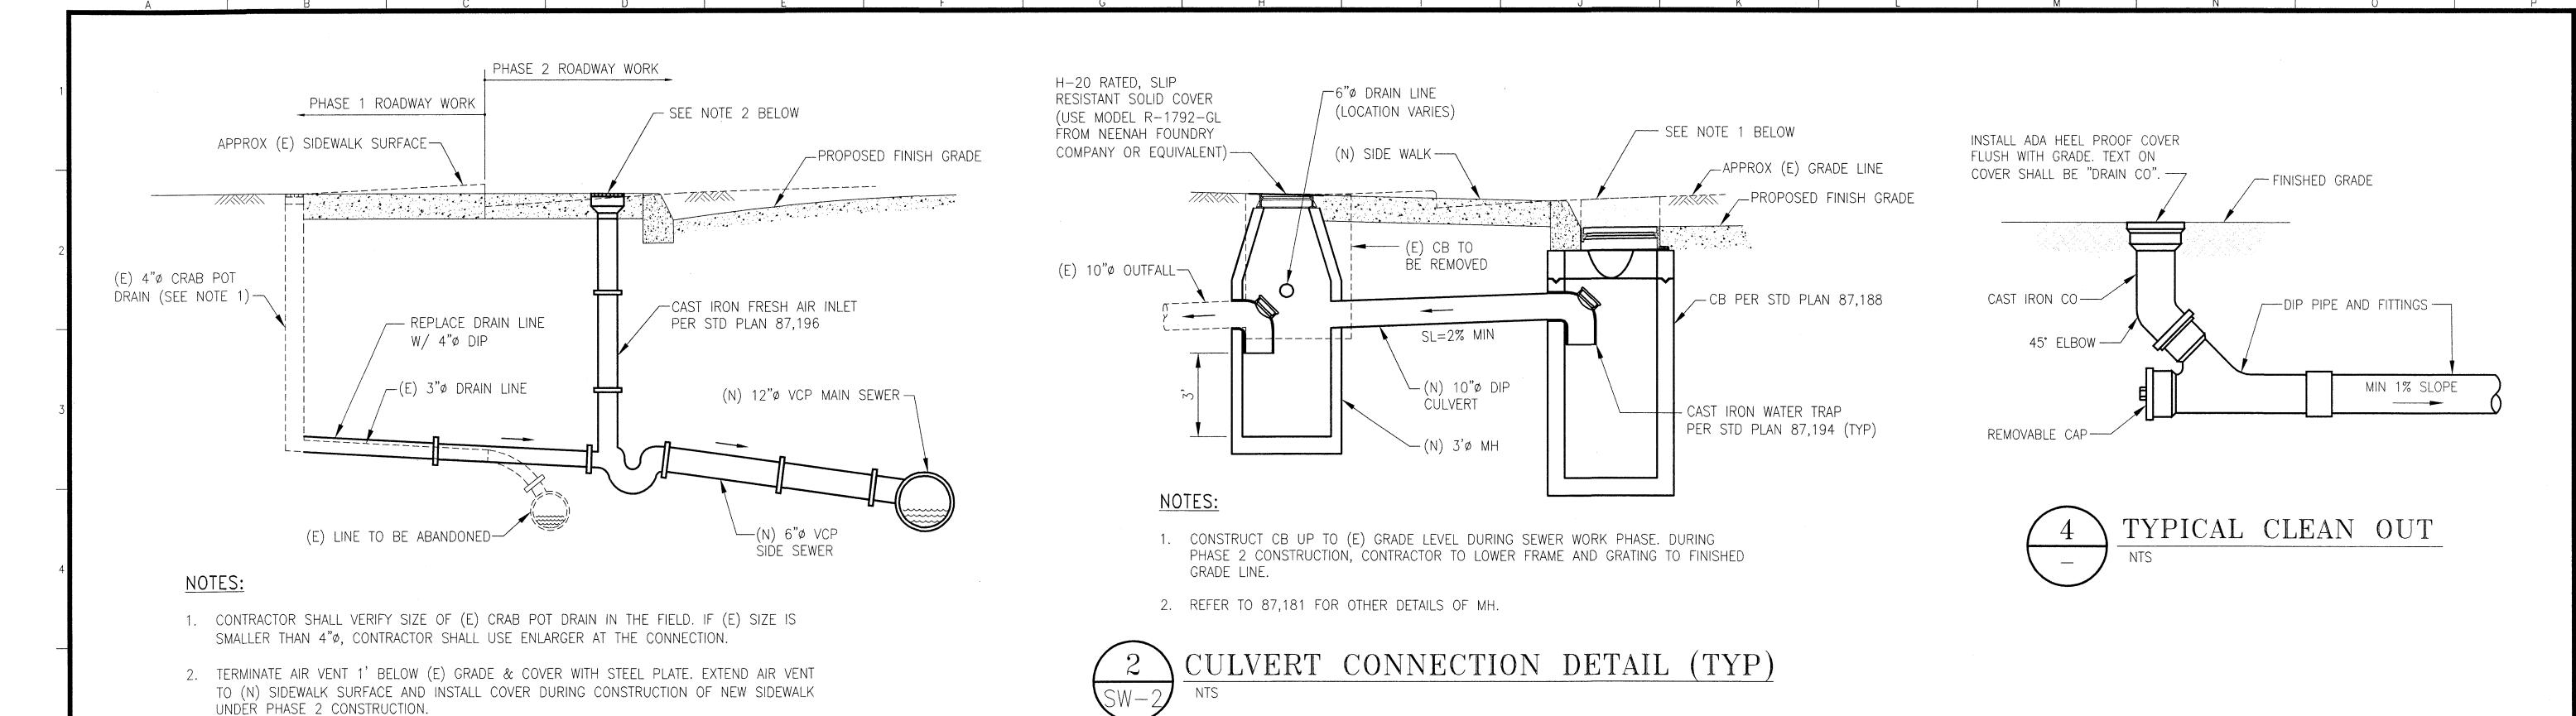

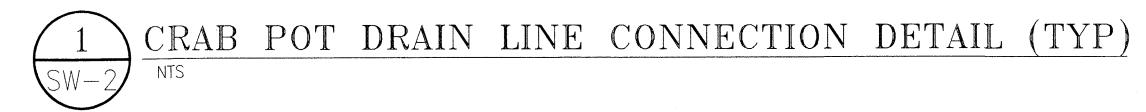


CONNECTION OF THE EXISTING PIPE TO NEW DIP.

SCALE: 1"=10'

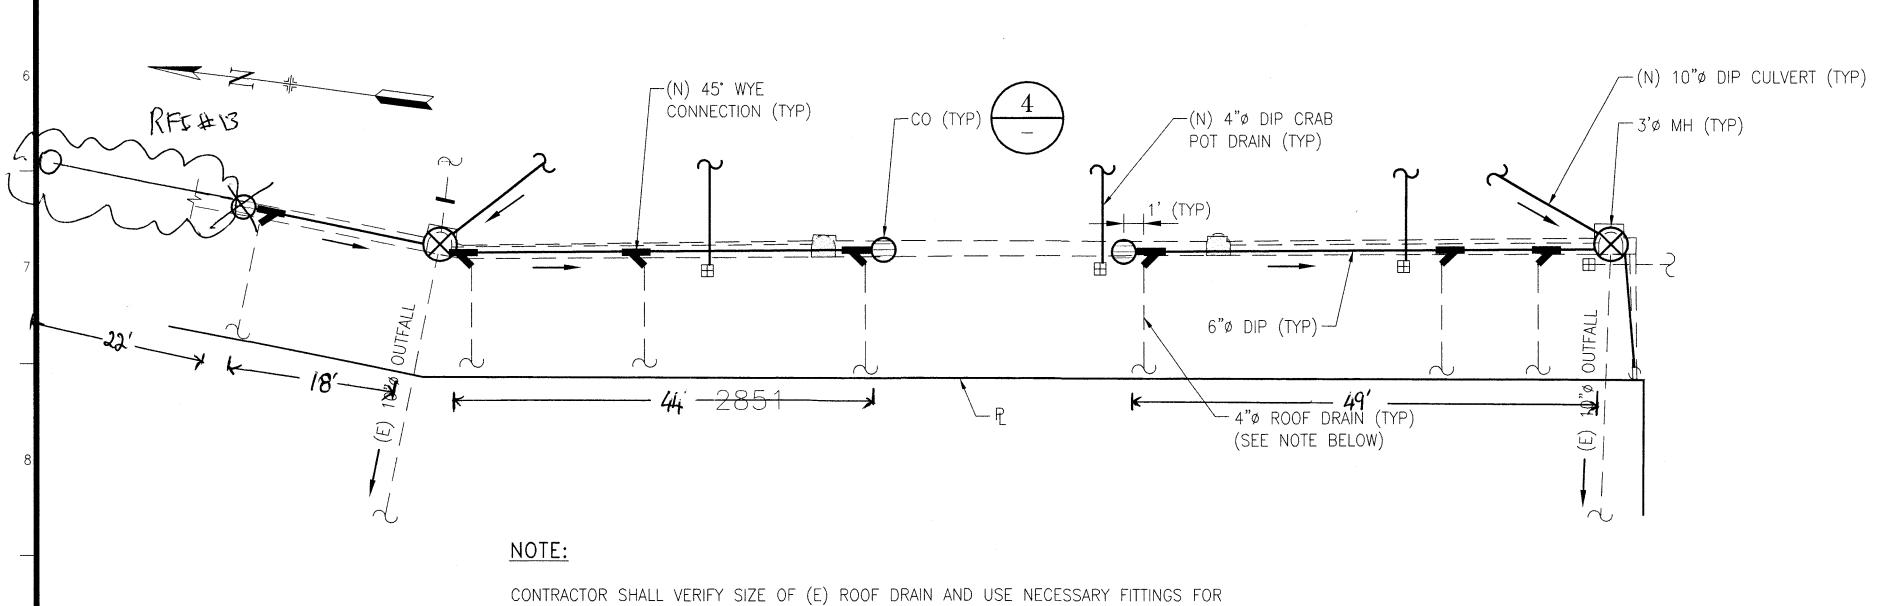


ENLARGED 6"Ø DIP DRAIN LAYOUT PLAN

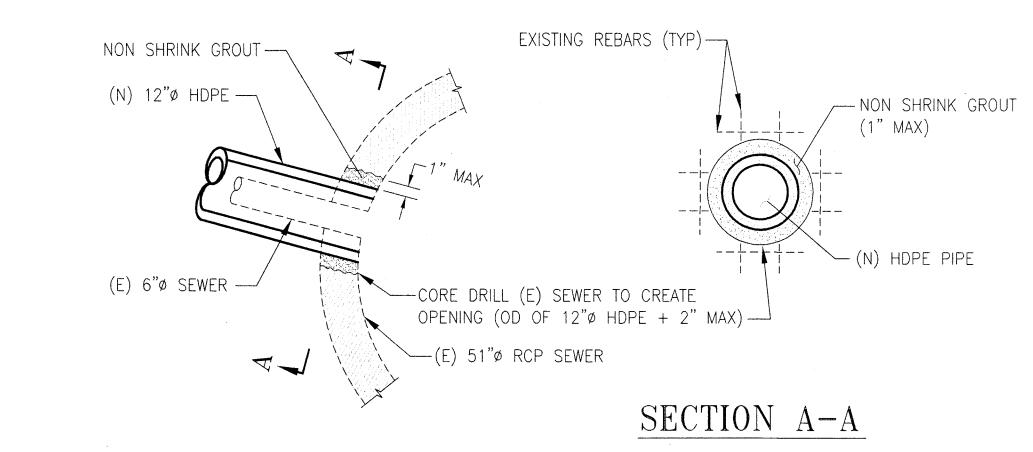


SW-2 CONNECTION DETAIL TO (E) RCP SEWER

0	6/09	ISSUED FOR BIDS	JF	ID.				
NO.	DATE	DESCRIPTION	BY	APP.				
	TABLE OF REVISIONS CHECK WITH TRACING TO SEE IF YOU HAVE LATEST REVISION							

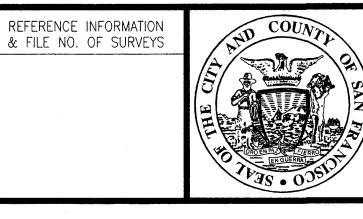

BUREAU OF ENGINEERING DEPARTMENT OF PUBLIC WORKS CITY AND COUNTY OF SAN FRANCISCO

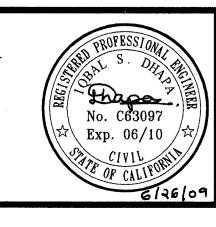

DESIGNED	DATE	APPROVED
JF 5 1	6/2009	Zon Dapo 61
DRAWN	DATE	SECTION MANAGER
JL/ EC	6/2009	11th 4
,	0.475	DEPUTY BUREAU MANAGER
CHECKED	DATE	M HOM.
GF UF	6/2009	CITY ENGINEER O

D	SCALE
DATE	AS N
LATO 1/09 NAGER DATE	SHEET OF
Die 1/169	13 0

AS NOTED THI
EET OF SHEETS

13 OF 39

TAYLOR STREET IMPROVEMENTS
THE EMBARCADERO TO JEFFERSON STREET

DETAILS AND

6"ø DIP LAYOUT PLAN


CONTRACT NO.
1498J

DRAWING NO.
SW-3

FILE NO.
89,948

REV. NO.



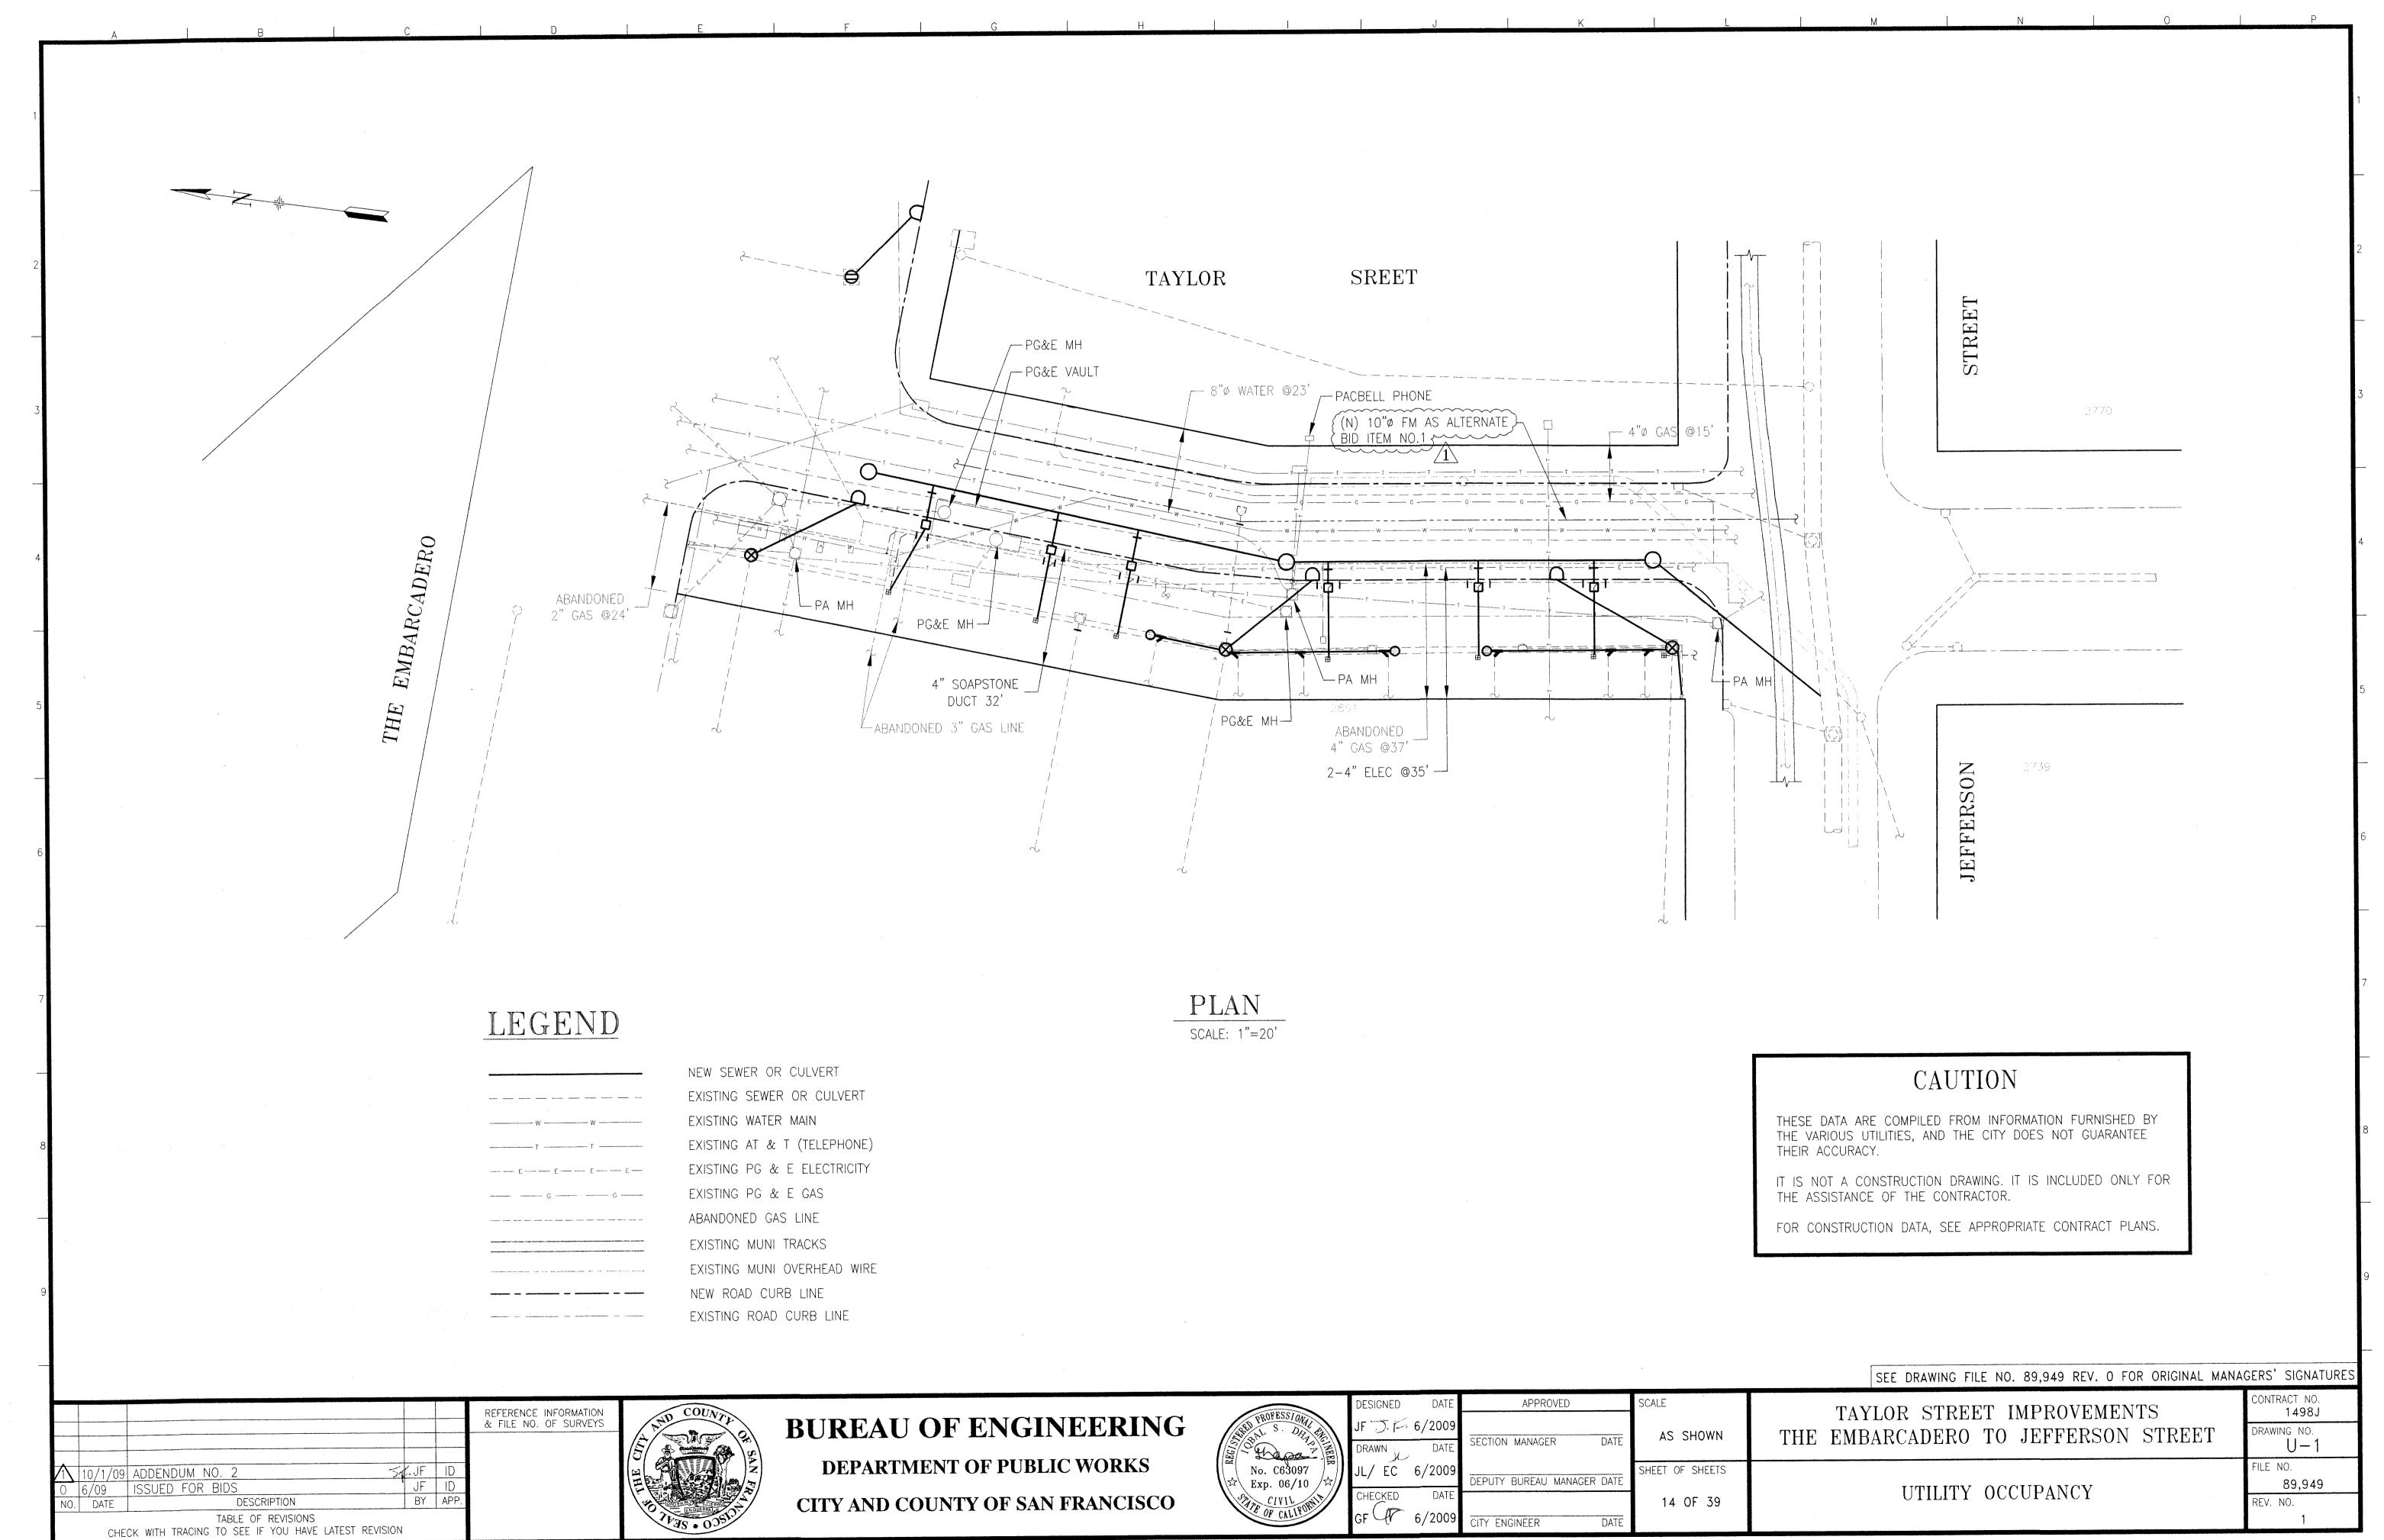



CITY AND COUNTY OF SAN FRANCISCO

BY APP.

DESCRIPTION

TABLE OF REVISIONS
CHECK WITH TRACING TO SEE IF YOU HAVE LATEST REVISION

NO. DATE

COMMUNICATION SECURITY SECU	FURNISH : INSTALL	EXISTING TO REMAIN	EXISTING TO BE REMOVED	DESCRIPTION	AWG	AMERICAN WIRE GAUGE SIGNAL BACKPLATE	R R/C	RED REMOVE FROM SITE OF WORK AS	WT	WHITE "T" YELLOW
## 15	·					BARE STRANDED COPPER WIRE	,	CONTRACTOR'S PROPERTY	SV-X	VEHICLE AND PEDESTRIAN SIGNAL POLE MOUNTING DESIGNATIONS. SEE CTSP ES-3A,
March Marc				TRAFFIC SIGNAL, SL, OR OTHER UTILITY CONDUIT		STATE OF CALIFORNIA, DEPARTMENT OF	R/R	· · · · · · · · · · · · · · · · · · ·	SP-X /	
To 100	- X			LOCATION AS SHOWN. R/C (E) WIRE TO NEAREST SPLICE	F C155	STANDARD SPECIFICATIONS,	,	PROPERTY	WB NB SB	WEST BOUND, NORTH BOUND AND
10 10 10 10 10 10 10 10				POINT. F/T (N) WIRES PER CONDUIT & WIRING SCHEDULE.			,		NM (NORTHWEST
10 10 10 10 10 10 10 10						FURNISH AND INSTALL UNDER THIS	SCGW			SOUTHWEST CALTRANS TYPE OF SIGNAL STANDARD.
Company Comp								STANDARD PLAN, DEPARTMENT OF PUBLIC	12/C, 12C	
*** O CATHER OF THE STORY AND CONTROL TO CATHER OF			+ >	12" (300mm) VEHICLE SIGNAL FACE WITH BACKPLATE	G	GREEN	SSDPWSF	APRIL 2007.		
Committee Comm				OC IVIOUNTHING LIVAIVIEVVOIVIN	GO	GENERAL ORDER		WORKS, CITY AND COUNTY OF SAN FRANCISCO, APRIL 2007.		PEDESTRIAN SIGNAL
CS							T	TUNNEL VISOR	3S8"	
11.1		\bowtie		"M" I/C CABINET FOUNDATION & CABINET			TS	TRAFFIC SIGNAL		
US NAME OF SHAPE (25) AND CONTROL COMPANION OF COMPANION OF CONTROL COMPANION OF C				STREETLIGHT WITH COBRA HEAD LUMINAIRE					258 1	2 SECTION 8 , RED I , WHITE I
FAMOUR SIGNAL STREETURST PLAY SECURISHON POINT OF THE STREETURST SIGNAL STREETURST PLAY SECURISH POINT OF THE STREETURS SIGNAL STREETURST PLAY SECURISH PRODUCT OF THE STREETURS SIGNAL AS A SECURISH PLAY SECURISH AND A SECURISH PLAY SECURISH AND A SECURISH AND A SECURISH PLAY SECURISH AND A SECURISH AND A SECURISH PLAY SECURISH AND A SECURISH PLAY		~								
□□□□□□□□□□□□□□□□□□□□□□□□□□□□□□□□□□□□□	•	0	©	TRAFFIC SIGNAL-STREETLIGHT POLE, OR COMBINATION		, ,				
THE DIES AND CONCASTS AND CONCASTS AND CONCASTS AND SALE BY DEFERRACE IN THE FOLLOWING SAND SALE BY DEFERRACE ON THE FOLLOWING SALE BY DEFERRACE FOR SALE BY DEFERRACE					GE	NERAL NOTES				
2. STYGOLS, ABBREMATIONS AND GENERAL NOTES APPLY TO ALL TIST DRAWINGS. NOT ALL SYMBOLS ARE USED. 3. SPECIAL INSTRUCTION TO THE CONTRACTOR IT IS DIPPORTED THAT AN LITERISECT, CONTRACTOR SHALL BY ARIJE TO INTERPORT THE POSSION TO SAFET PLANS AND DIPPORTED THAT AN LITERISECT SHALL BE ARIJE TO INTERPORT THE POSSION TO SAFET PLANS AND DIPPORTED THAT AND AND PROBLEM FRAIL THAT IT IS DIPPORTED THAT AND AND PROBLEM FRAIL THAT IS DIPPORTED THAT INTERPORT THAT AND	111	III III		PULL BOX TYPE III	POLES	S, PULL BOXES, AND CONDUIT ROUTING MAY \	VARY DEPENDING ON	SITE CONDITIONS AND SHALL BE DETERMINED IN		
NERWEET HE DESIGNED TRAFFIC PHASING AND THE WHANG SHOWN ON THE PLANS AND ENSURE HIST THE NET RESULT WILL OPERATE CORRECTLY, ANY IRREGULARITIES SPALL BE BROUGHT TO WORK AREA, THESE "ACLITES INCLUDE BUT ARE NOT HE DID HAVE NOT HE FOLLOWING HORANDS, AND JILTY POLES. SEE SHEET NOTE 5, TYP ON DUT RUIN NUMBER #1, TYP CONDUIT RUIN NUMBER 2, TYP F/S (E) FACILITES TO NOLUDE: PULL BOXES, POLES, INTERSECT ON CONTROLLERS, ETC. MODITY (N) SAME LOCATION AS SHOWN FACILITES TO NOLUDE: PULL BOXES, POLES, INTERSECT ON CONTROLLERS, ETC. MODITY (E) CONDUITS AND F/I (N) FACILITY IN SAME LOCATION AS SHOWN FOR THE EDGEN OF CONDUIT. SHE PROVIDED CLEARANCE FROM OTHER UTILITIES PER C.C. 128. (V) POLES AND OVERHEAD WRRES SHALL MAINTAIN THE REQUIRED CLEARANCE FROM OTHER UTILITIES PER C.C. 128. (V) POLES AND OVERHEAD WRRES SHALL MAINTAIN THE REQUIRED CLEARANCE FROM OTHER UTILITIES PER C.C. 128. (V) POLES AND OVERHEAD WRRES SHALL MAINTAIN THE REQUIRED CLEARANCE FROM OTHER UTILITIES PER CO. 95. NEW CONDUITS RUINING IN THE SAME DIRECTION MAY BE JOINT TRENCHED. 10. (E) POLES TO BE REMOVED: R/S OR R/C THE POLE PER DPT ENGINEER. R/C FOUNDATION 3' FROM GRADE FOR	— III	111								
LIMITED TO THE FOLLOWING: TREES, LANDSCAPING, HYDRAMIS, AND UTILITY POLES. 5. COORDINATE WITH RESIDENT ENGINEER TO RETERENCE (E) SURVEY MONUMENTS BEFORE CONSTRUCTION: 48 HOURS ADVANCE NOTICE IS REQUIRED. 6. MAINTAIN AND KEEP TRAFFIC SIGNALS IN OPERATION AT ALL TIMES DURING CONSTRUCTION. 7. ALL CALTRANS TYPE STANDARDS SHALL BE IN ACCORDANCE WITH SECT. 86—2.04 OF CITSS WITH THE HOLLOWING EXCEPTION: MAST ARM POLE HANDHOLES ARE 180° AWAY FROM THE CURB AND SLIPOLE HANDHOLES ARE 90° AWAY FROM THE CURB AND OPPOSITE THE DIRECTION OF ONCOMING TRAFFIC. 8. (N) UNDERFORCION CONTROLLERS, ETC. MODIFY (F) CONDUITS AND F/I WRES PER CONDUIT & WIRING SCHEDULE. 9. NEW CONDUITS RUNNING IN THE SAME DIRECTION MAY BE JOINT TRENCHED. 10. F/I CROUND WIRES IN ALL TRAFFIC SIGNAL, STREETLIGHT, AND SERVICE CONDUIT. SEE CONTRACT SPECS. 11. (E) POLES TO BE REMOVED: R/S OR R/C THE POLE PER OPIL ENSINEER. R/C FOUNDATION 3' FROM GRADE FOR		\Box_{P}		PG&E SERVICE PULL BOX	INTER WILL	PRET THE DESIGNED TRAFFIC PHASING AND THOOPERATE CORRECTLY. ANY IRREGULARITIES SH	HE WIRING SHOWN O ALL BE BROUGHT TO	N THE PLANS AND ENSURE THAT THE NET RESULT O THE ATTENTION OF THE DPT ENGINEER IMMEDIATELY.		
ADVANCE NOTICE IS REQUIRED. SEE SHEET NOTE 5, TYP 6. MANTAIN AND KEEP TRAFFIC SIGNALS IN OPERATION AT ALL TIMES DURING CONSTRUCTION. 7. ALL CALITANS TYPE STANDARDS SHALL BE IN ACCORDANCE WITH SECT. 86—2.04 OF CTSS WITH THE FOLLOWING EXCEPTION: MAST ARM POLE HANDHOLES ARE 180 AWAY FROM THE CURB AND SL POLE HANDHOLES ARE 90' AWAY FROM THE CURB AND OPPOSITE THE DIRECTION OF ONCOMING TRAFFIC. 8. (N) UNDERGROUND CONDUITS SHALL MAINTAIN THE REQUIRED CLEARANCE FROM OTHER UTILITIES PER G.O. 128. (N) POLES AND OVERHEAD WIRES SHALL MAINTAIN THE REQUIRED CLEARANCE FROM OTHER UTILITIES PER G.O. 95. 8. (N) UNDERGROUND CONDUITS SHALL MAINTAIN THE REQUIRED CLEARANCE FROM OTHER UTILITIES PER G.O. 95. 9. NEW CONDUITS RUNNING IN THE SAME DIRECTION MAY BE JOINT TRENCHED. 10. F/I GROUND WIRES IN ALL TRAFFIC SIGNAL, STREETLIGHT, AND SERVICE CONDUIT. SEE CONTRACT SPECS. 11. (E) POLES TO BE REMOVED: R/S OR R/C THE POLE PER DPT ENGINEER. R/C FOUNDATION 3' FROM GRADE FOR					LIMITE	D TO THE FOLLOWING: TREES, LANDSCAPING,	HYDRANTS, AND UTIL	LITY POLES.		
CONDUIT RUN NUMBER 2, TYP CONDUIT RUN NUMBER 2, TYP R/S (E) FACILITY AND F/I (N) FACILITY IN SAME LOCATION AS SHOWN. FACILITIES TO INCLUDE: PULL BOXES, POLES, INTERSECTION CONTROLLERS, ETC. MODIFY (E) CONDUITS AND F/I WIRES PER CONDUIT & WIRING SCHEDULE. BAST ARM POLE HANDHOLES ARE 180° AWAY FROM THE CURB AND SL POLE HANDHOLES ARE 90° AWAY FROM THE CURB AND OPPOSITE THE DIRECTION OF ONCOMING TRAFFIC. 8. (N) UNDERGROUND CONDUITS SHALL MAINTAIN THE REQUIRED CLEARANCE FROM OTHER UTILITIES PER G.O. 128. (N) POLES AND OVERHEAD WIRES SHALL MAINTAIN THE REQUIRED CLEARANCE FROM OTHER UTILITIES PER G.O. 95. 9. NEW CONDUITS RUNNING IN THE SAME DIRECTION MAY BE JOINT TRENCHED. 10. F/I GROUND WIRES IN ALL TRAFFIC SIGNAL, STREETLIGHT, AND SERVICE CONDUIT. SEE CONTRACT SPECS. 11. (E) POLES TO BE REMOVED: R/S OR R/C THE POLE PER DPT ENGINEER. R/C FOUNDATION 3' FROM GRADE FOR	</td <td>5></td> <td>SEE SHEET NO</td> <td>OTE 5, TYP</td> <td>ADVAN</td> <td>NCE NOTICE IS REQUIRED.</td> <td>, ,</td> <td></td> <td></td> <td></td>	5>	SEE SHEET NO	OTE 5, TYP	ADVAN	NCE NOTICE IS REQUIRED.	, ,			
CONDUIT RUN NUMBER 2, TYP R/S (E) FACILITY AND F/I (N) FACILITY IN SAME LOCATION AS SHOWN. FACILITIES TO INCLUDE: PULL BOXES, POLES, INTERSECTION CONTROLLERS, ETC. MODIFY (E) CONDUITS AND F/I WIRES PER CONDUIT & WIRING SCHEDULE. 8. (N) UNDERGROUND CONDUITS SHALL MAINTAIN THE REQUIRED CLEARANCE FROM OTHER UTILITIES PER G.O. 128. (N) POLES AND OVERHEAD WIRES SHALL MAINTAIN THE REQUIRED CLEARANCE FROM OTHER UTILITIES PER G.O. 95. 9. NEW CONDUITS RUNNING IN THE SAME DIRECTION MAY BE JOINT TRENCHED. 10. F/I GROUND WIRES IN ALL TRAFFIC SIGNAL, STREETLIGHT, AND SERVICE CONDUIT. SEE CONTRACT SPECS. 11. (E) POLES TO BE REMOVED: R/S OR R/C THE POLE PER DPT ENGINEER. R/C FOUNDATION 3' FROM GRADE FOR		1)	POLE NUMBER	R #1, TYP	MAST	ARM POLE HANDHOLES ARE 180° AWAY FROM	THE CURB AND SL			
INTERSECTION CONTROLLERS, ETC. MODIFY (E) CONDUITS AND 9. NEW CONDUITS RUNNING IN THE SAME DIRECTION MAY BE JOINT TRENCHED. 10. F/I GROUND WIRES IN ALL TRAFFIC SIGNAL, STREETLIGHT, AND SERVICE CONDUIT. SEE CONTRACT SPECS. 11. (E) POLES TO BE REMOVED: R/S OR R/C THE POLE PER DPT ENGINEER. R/C FOUNDATION 3' FROM GRADE FOR			R/S (E) FACIL	LITY AND F/I (N) FACILITY IN SAME LOCATION AS	8. (N) U	UNDERGROUND CONDUITS SHALL MAINTAIN THE	REQUIRED CLEARANG			
	INTERSECTION CONTROLLERS, ETC. MODIFY (E) CONDUITS AND		CONTROLLERS, ETC. MODIFY (E) CONDUITS AND							
					1	·		,		

SHEET OF SHEETS


23 OF **3**9

TRAFFIC SIGNAL LEGEND

SYMBOLS, ABBREVIATIONS & GENERAL NOTES

89,956


REV. NO.

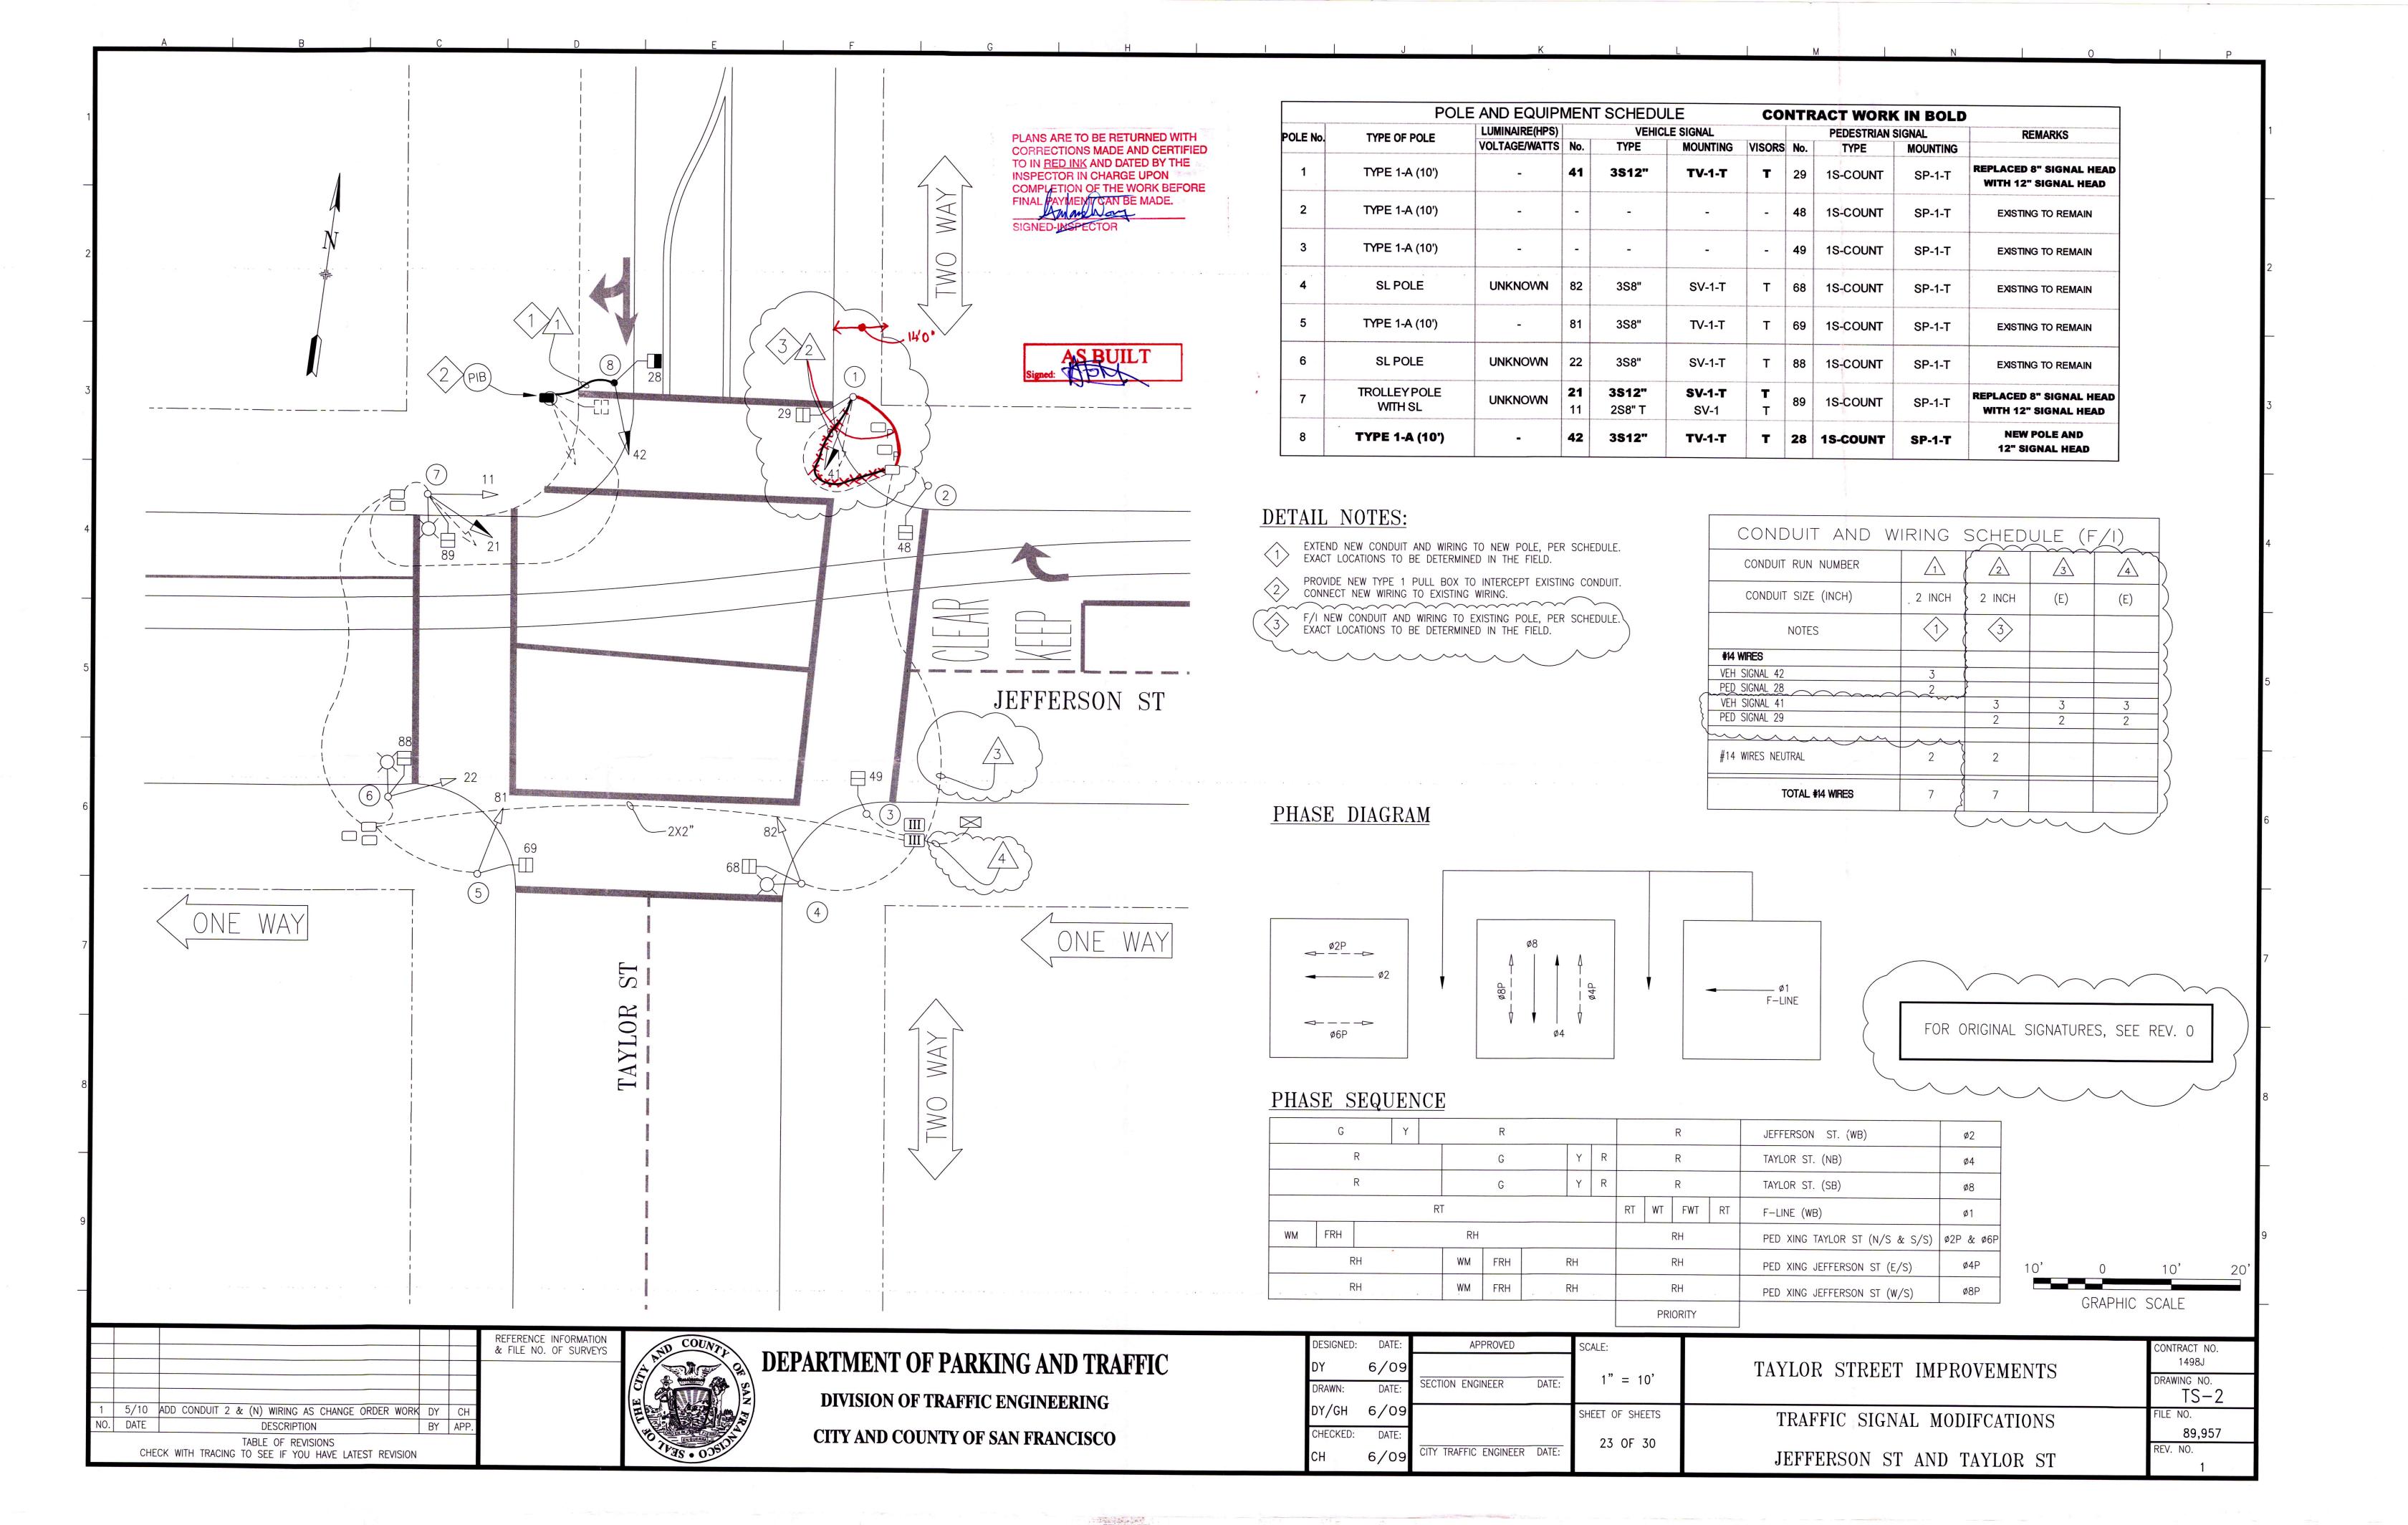




PLANS ARE TO BE RETURNED WITH CORRECTIONS MADE AND CERTIFIED TO IN RED INK AND DATED BY THE INSPECTOR IN CHARGE UPON COMPLETION OF THE WORK BEFORE FINAL PAYMENT CAN BE MADE.

PRANDIC SWEKSON OF BY TS-2 REV. 1

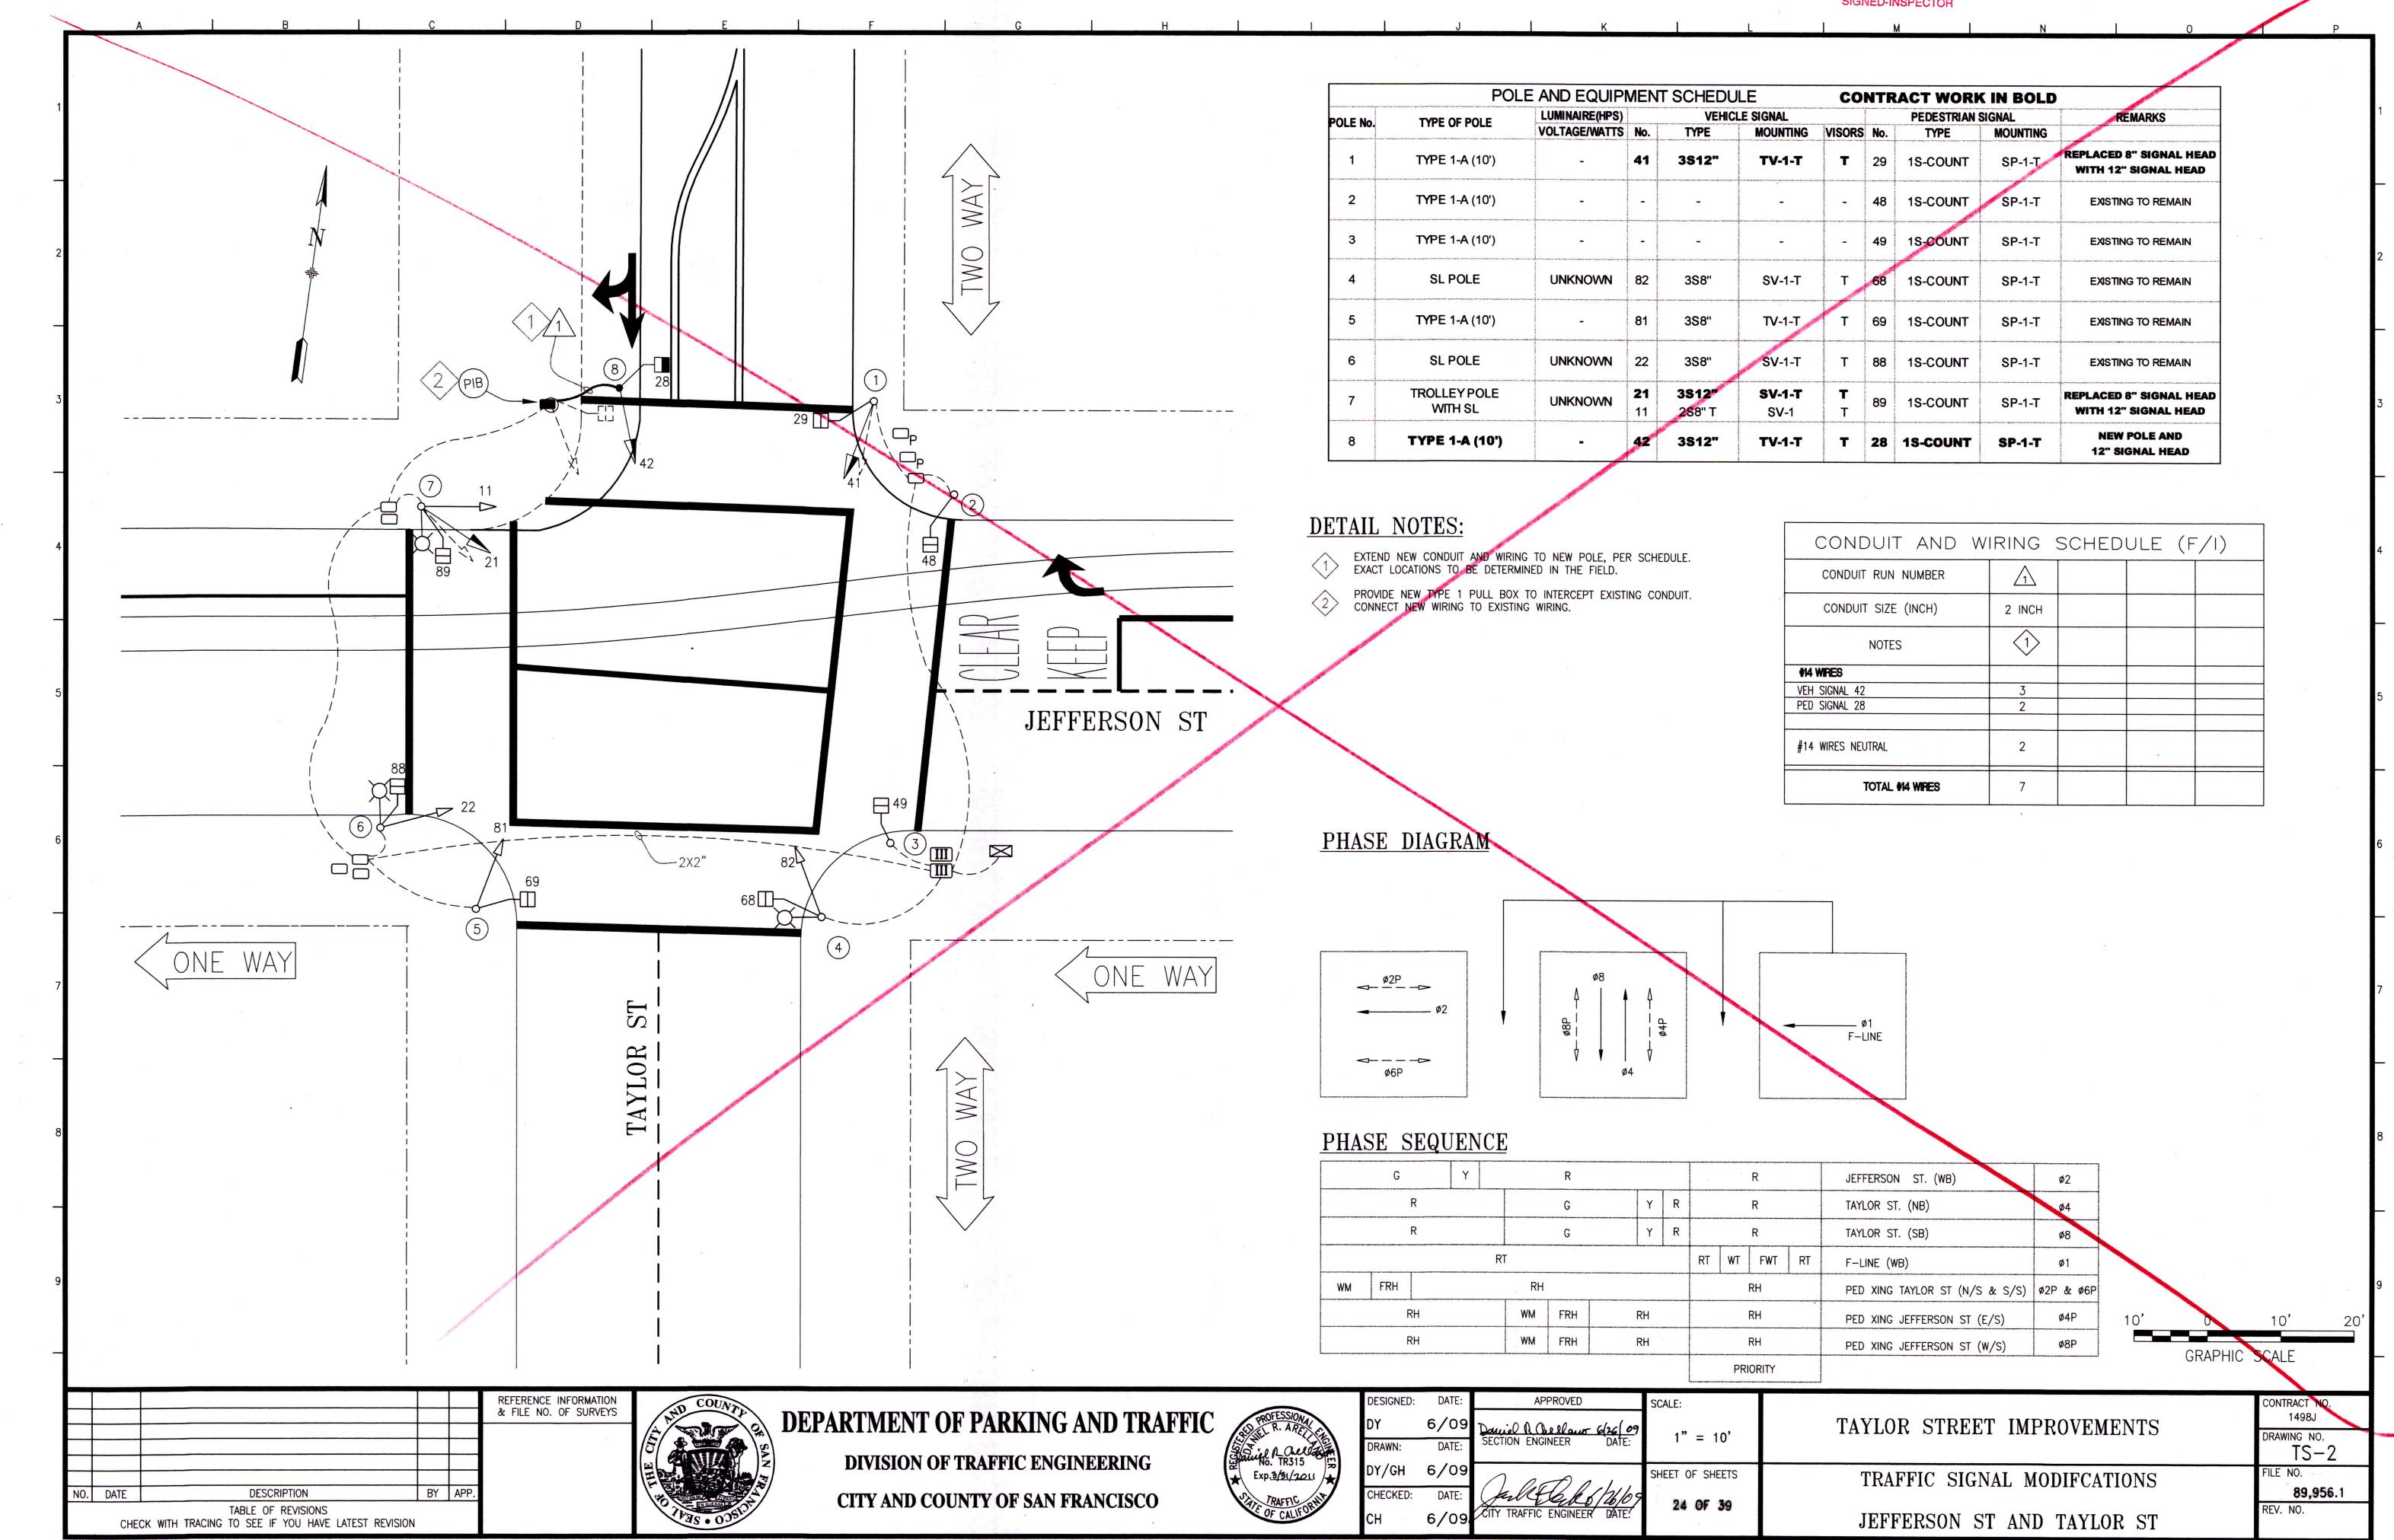

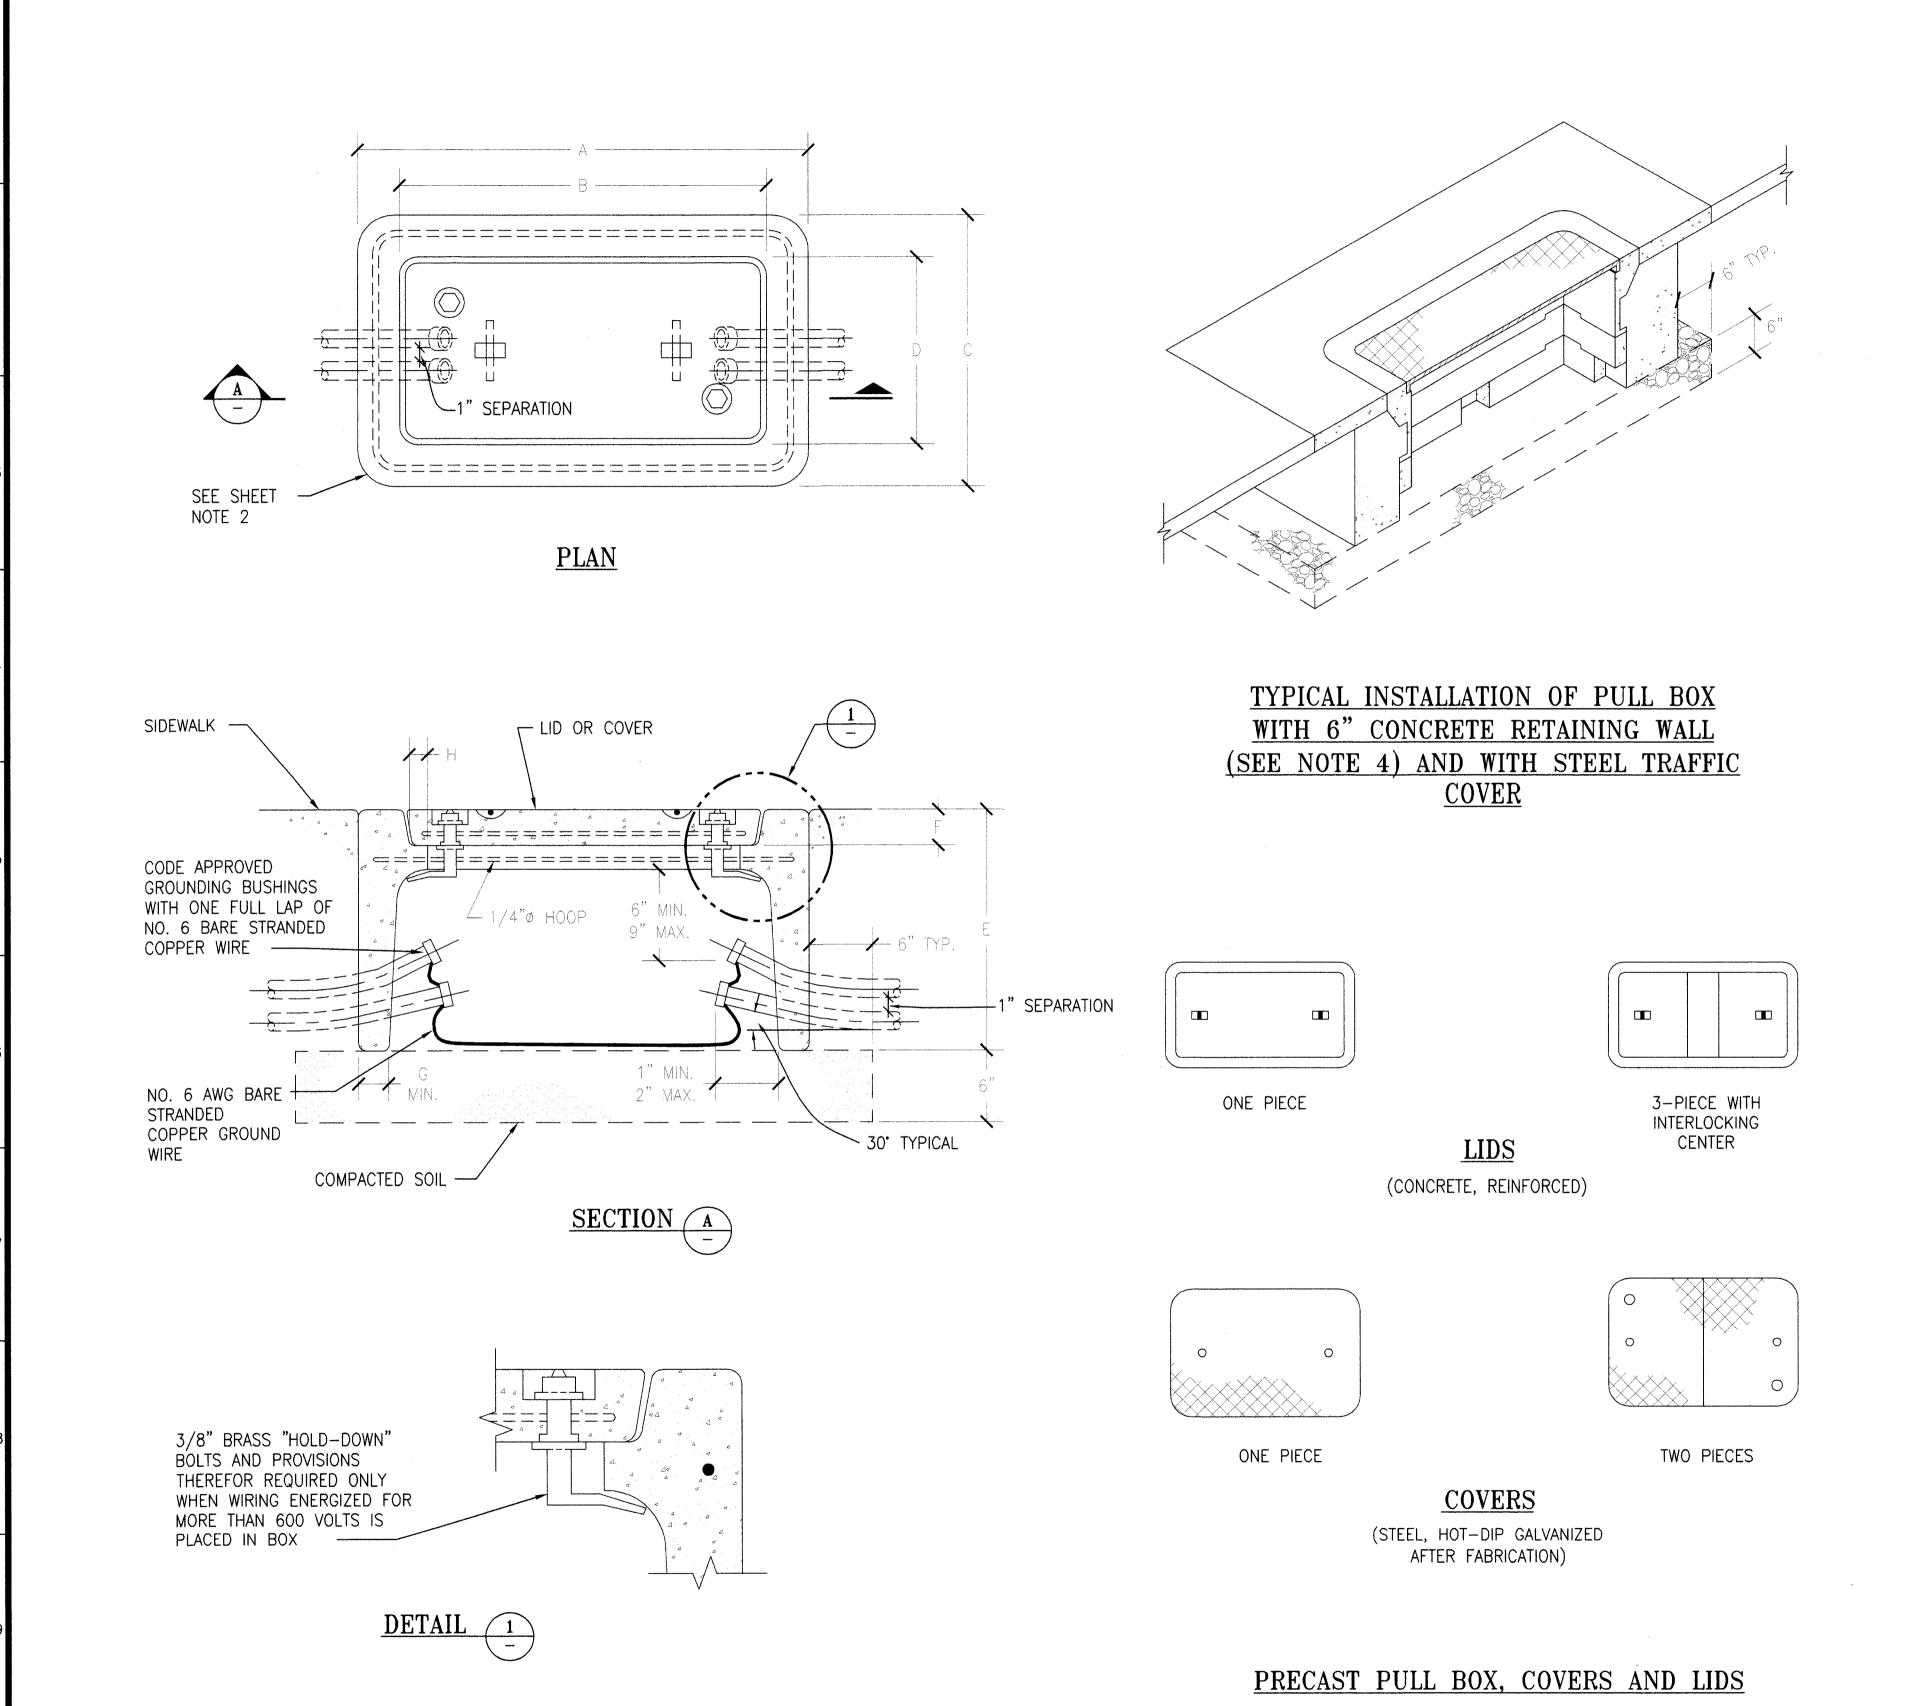

TYPE		The second consistence of the second consistency of the second consistence of the second consist	DI	DEMADEC						
TIFE	A	В	С	D	E	F	G	H MIN. MAX.		REMARKS
I	25 1/4	21	15 ¾	11	12	2	1	5/8	MAX. 3/4	FURNISH WITH LID OR COVER, AS APPLICABLE. SEE SHEET NOTES.
II	27 ½	23 ½	18	14	12	2	1 1/4	5/8	7/8	FURNISH WITH LID OR COVER, AS APPLICABLE. SEE SHEET NOTES.
III	35 1/4	31	22 1/4	18	12	2	1 1/4	5/8	7/8	FURNISH WITH LID OR COVER, AS APPLICABLE. SEE SHEET NOTES.
IV	64 1/4	60 ¼	35	30 ½	14	3	1 ½	1 1/8	1 %	FURNISH WITH THREE PIECE LID OR TWO PIECE STEEL COVER, AS APPLICABLE. SEE SHEET NOTES.

SHEET NOTES:

- 1. ALL EXPOSED METALLIC PORTIONS OF THE PULL BOXES SHALL BE CONSTRUCTED WITH FERROUS MATERIALS AND SUCH MATERIALS SHALL BE HOT—DIP GALVANIZED AFTER FABRICATION.
- 2. PULL BOXES, COVERS AND EXTENSIONS SHALL BE PRECAST REINFORCED CONCRETE. PULL BOXES SHALL HAVE ETCHED POLYETHYLENE FACE ANCHORED IN CONCRETE AND ULTRAVIOLET INHIBITOR.
- 3. LIDS AND COVERS FURNISHED WITH PULL BOXES ENCLOSING WIRING ENERGIZED WITH VOLTAGES GREATER THAN 600 VOLTS SHALL BE PROVIDED WITH "HOLD-DOWN" BOLTS FABRICATED FROM BRASS.
- 4. PULL BOXES PLACED IN ROADWAYS OR IN AREAS SUBJECT TO VEHICLE AND HEAVY MACHINERY TRAFFIC SHALL BE FURNISHED WITH STEEL CHECKER PLATE TRAFFIC COVERS. IN ADDITION, A 6-INCH WIDE BY 12-INCH HIGH CONCRETE RETAINING WALL SHALL BE CONSTRUCTED ALL AROUND EACH PULL BOX INSTALLED IN SUCH AREAS.
- 5. A 12-INCH WIDE BY 3 1/2-INCH DEEP (MINIMUM) CONCRETE SLAB SHALL BE CONSTRUCTED ALL AROUND EACH PULL BOX (INCLUDING BOXES PROVIDED WITH THE 6-INCH THICK RETAINING WALL SET FORTH IN NOTE 4 ABOVE) INSTALLED IN UNPAVED OR ASPHALT CONCRETE PAVED AREAS.
- 6. LIDS AND COVERS SHALL BE PROVIDED WITH THE FOLLOWING LEGENDS, AS APPLICABLE:

FIRST LINE :	ELECTRICAL—DPW	ELECTRICAL-DPW	ELECTRICAL	TRAFFIC
SECOND LINE:	120/240 VOLT	IRR SYS	R & P	SIGNALS
FIRST LINE :	ELECTRICAL-DPW	STREET LIGHTING	ELECTRICAL HIGH VOLTAGE	

- LETTERS SHALL BE 1-INCH AND MADE WITH 1/4-INCH WIDE STROKES. LETTERS INSCRIBED IN CONCRETE LIDS OR COVERS SHALL BE MADE WITH 1/8-INCH (MINIMUM) DEEP IMPRINTS. LEGENDS IN STEEL COVERS SHALL BE MADE WITH WELD BEAD LETTERS.
- 7. PROVIDE BONDING JUMPER (3' LONG, MINIMUM) FOR STEEL COVERS TO BE BONDED TO CONDUIT.
- 8. CONDUIT TO PULLBOXES SHALL NOT BE OVERLAPPED OR CROSSED ONE ANOTHER. PROVIDE AT LEAST 1" SPACE BETWEEN CONDUITS.
- 9. PROVIDE 95% COMPACTION PRIOR TO LEVELING AND INSTALLATION OF PULLBOX.

		REFERENCE INFORMATION & FILE NO. OF SURVEYS	COUNT			DESIGNED:	DATE:	APPROVED	SCALE:		CONTRACT NO.
		& FILE NO. OF SURVETS		DEPARTMENT OF PARKING AND TRAFFIC	PROFESSIONAL R. A.R.	DW	6/09	Daniel & Prellow 6/26/09		TAYLOR STREET IMPROVEMENTS	1498J
		1			Think of all the	DRAWN:	DATE:	SECTION ENGINEER DATE:	1" = 10"		DRAWING NO. TS-3
				DIVISION OF TRAFFIC ENGINEERING	No. TR315 Exp. 3/31/2011	DW	6/09		SHEET OF SHEETS	TOARRIC CICNAL DILLIDOV DETAIL	FILE NO.
NO. DATE	DESCRIPTION BY APP	0		CHEN AND COUNTRY OF CAN ED ANGECO	\frac{1}{2}	CHECKED:	DATE:	() Oftood this		TRAFFIC SIGNAL PULLBOX DETAIL	89,95 6.2
	TABLE OF REVISIONS		THE PROPERTY OF THE PARTY OF TH	CITY AND COUNTY OF SAN FRANCISCO	PAFFIC PALIFORNIA	SI	6/09	CITY TRAFFIC ENGINEER DATE:	25 OF 39	TYPE I-IV PULL BOX, COVER AND CONDUIT	REV. NO.
CHECK WITH TRA	CING TO SEE IF YOU HAVE LATEST REVISION		138 • 035				0,00	//	·	TITE I IV TOLL BOX, COVER AND CONDOIL	

SHEET OF SHEETS

27 OF 39


CONSTRUCTION PHASING PLAN

PHASE 1

89,957

REV. NO.

AS BUILT

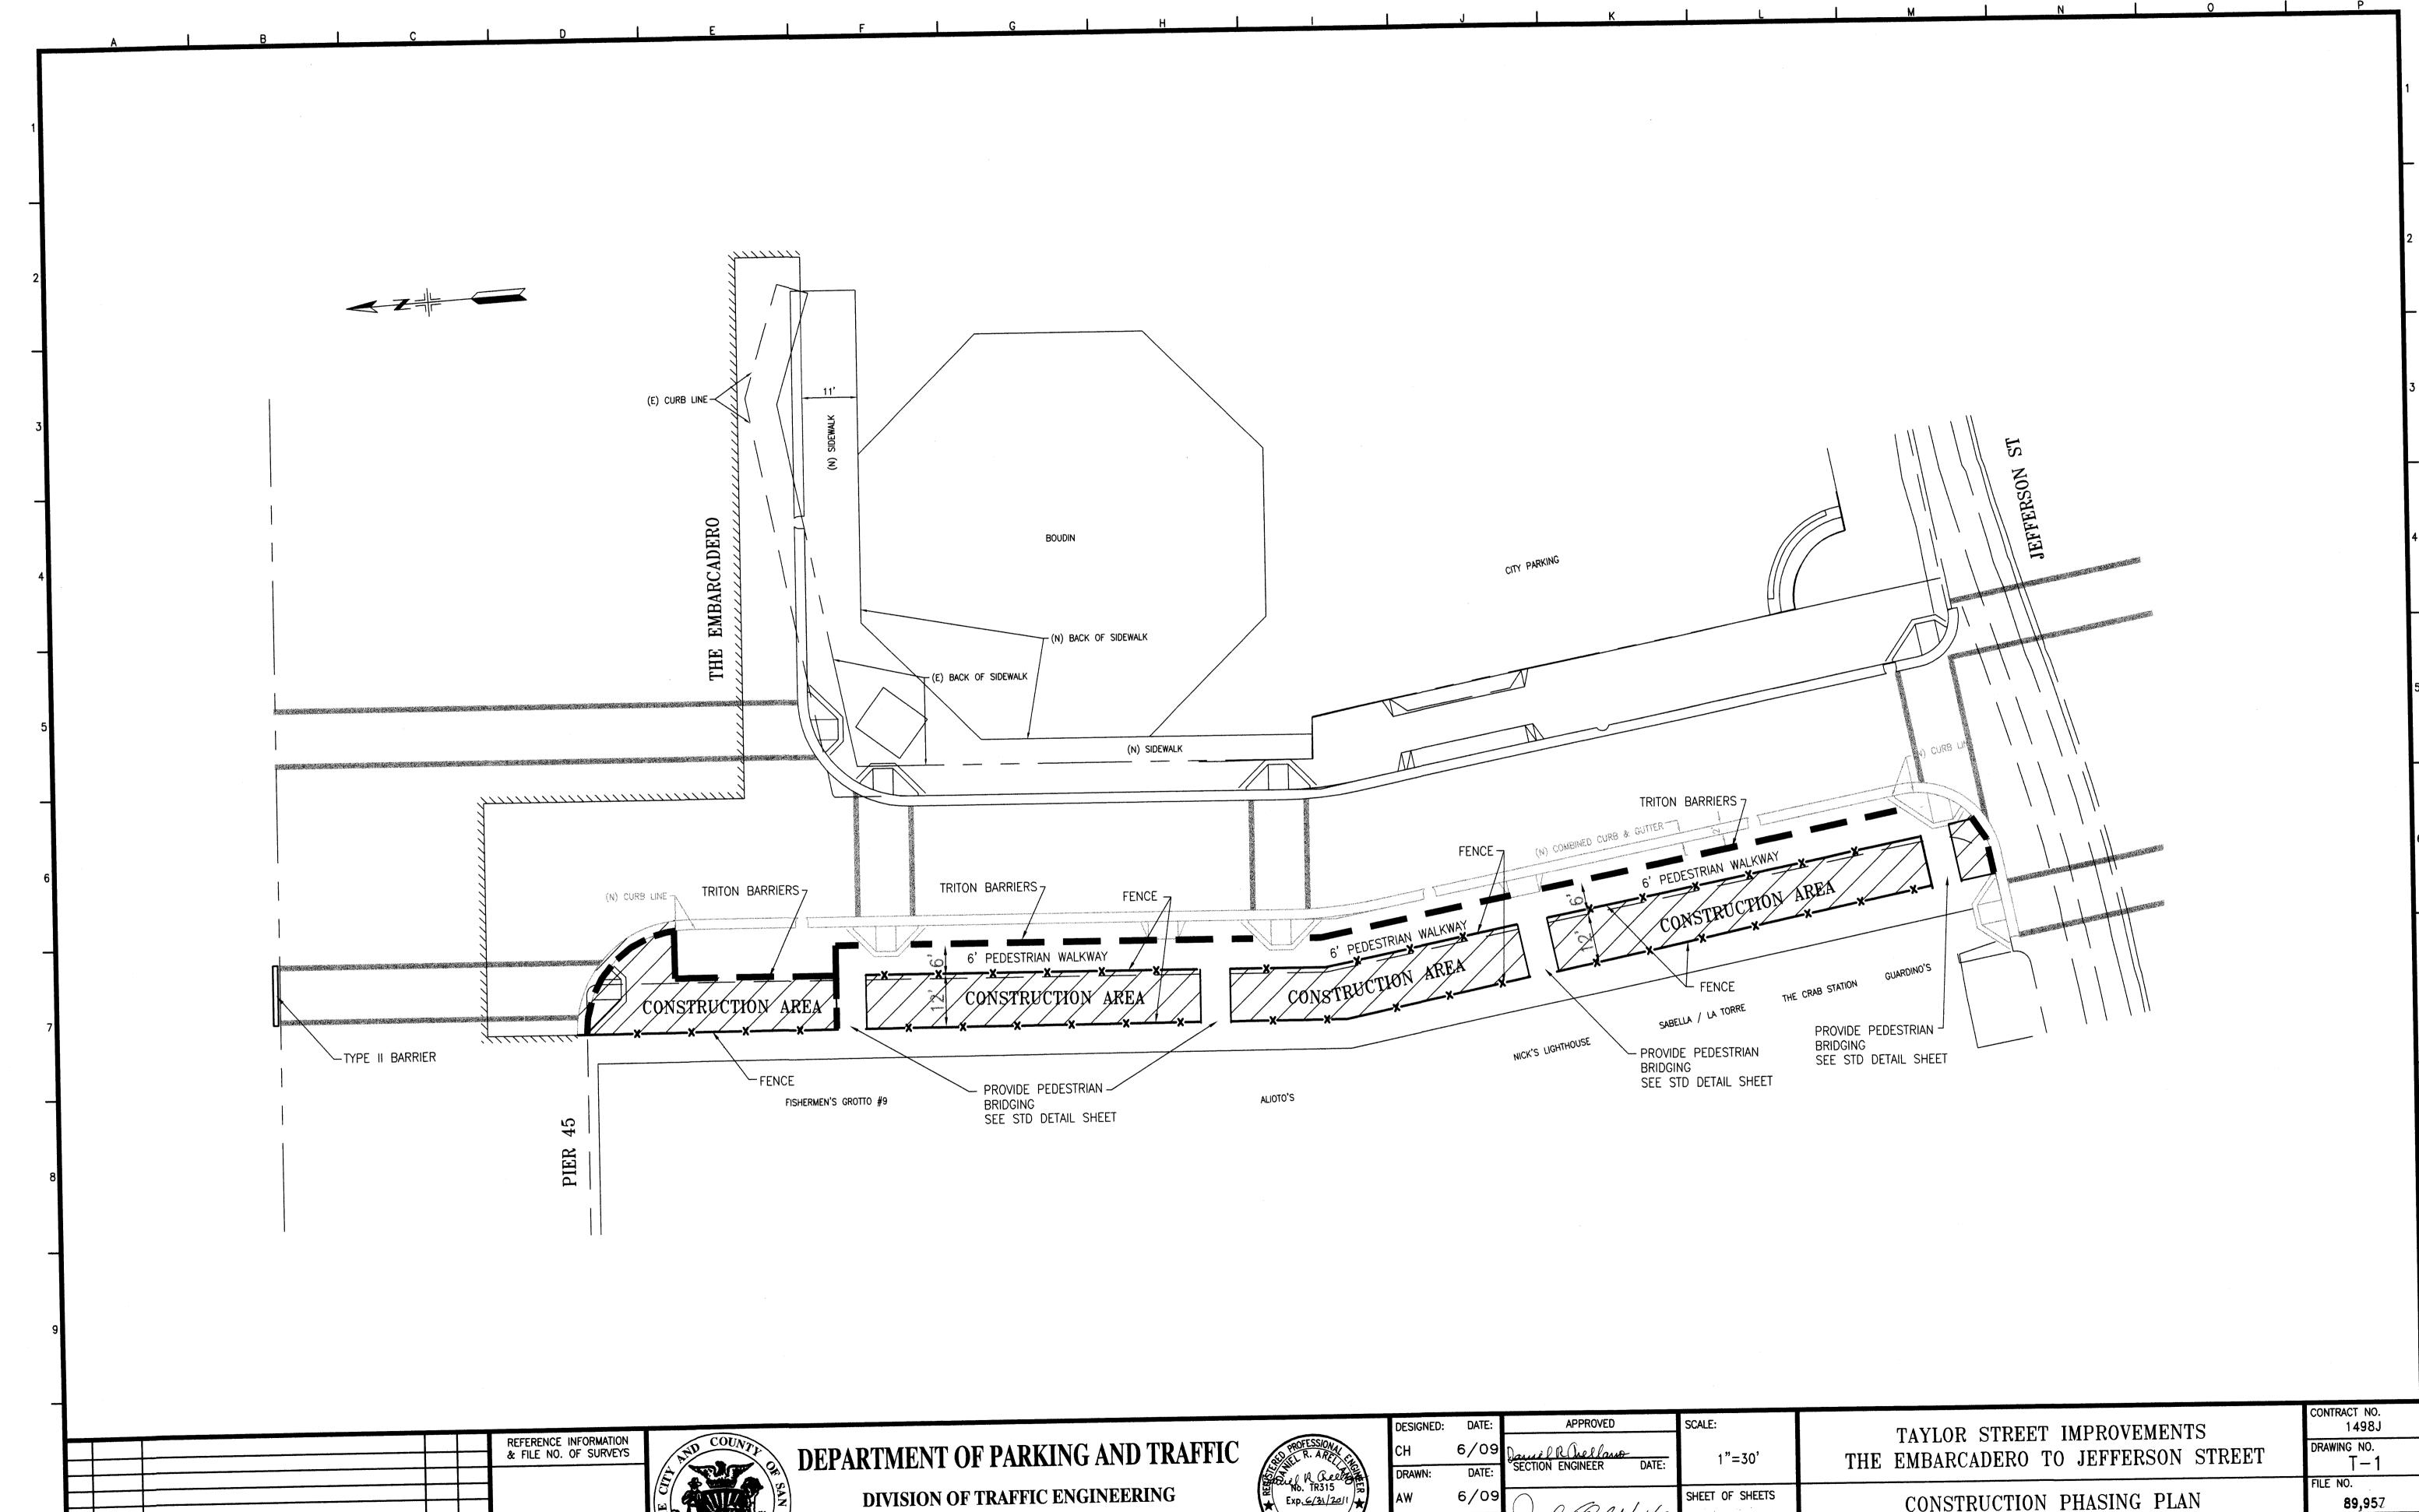

CITY AND COUNTY OF SAN FRANCISCO

BY APP.

NO. DATE

TABLE OF REVISIONS
CHECK WITH TRACING TO SEE IF YOU HAVE LATEST REVISION


NO. DATE

TABLE OF REVISIONS
CHECK WITH TRACING TO SEE IF YOU HAVE LATEST REVISION

PLANS ARE TO BE RETURNED WITH COPRECTIONS WADE AND CEPTIFIED TO IN RED INK AND DATED BY THE INSPECTOR IN CHARGE UPON COMPLETION OF THE WORK BEFORE FINAL PAYMENT/CAN BE MADE SIGNED-INSPECTOR

REV. NO.

PHASE 2

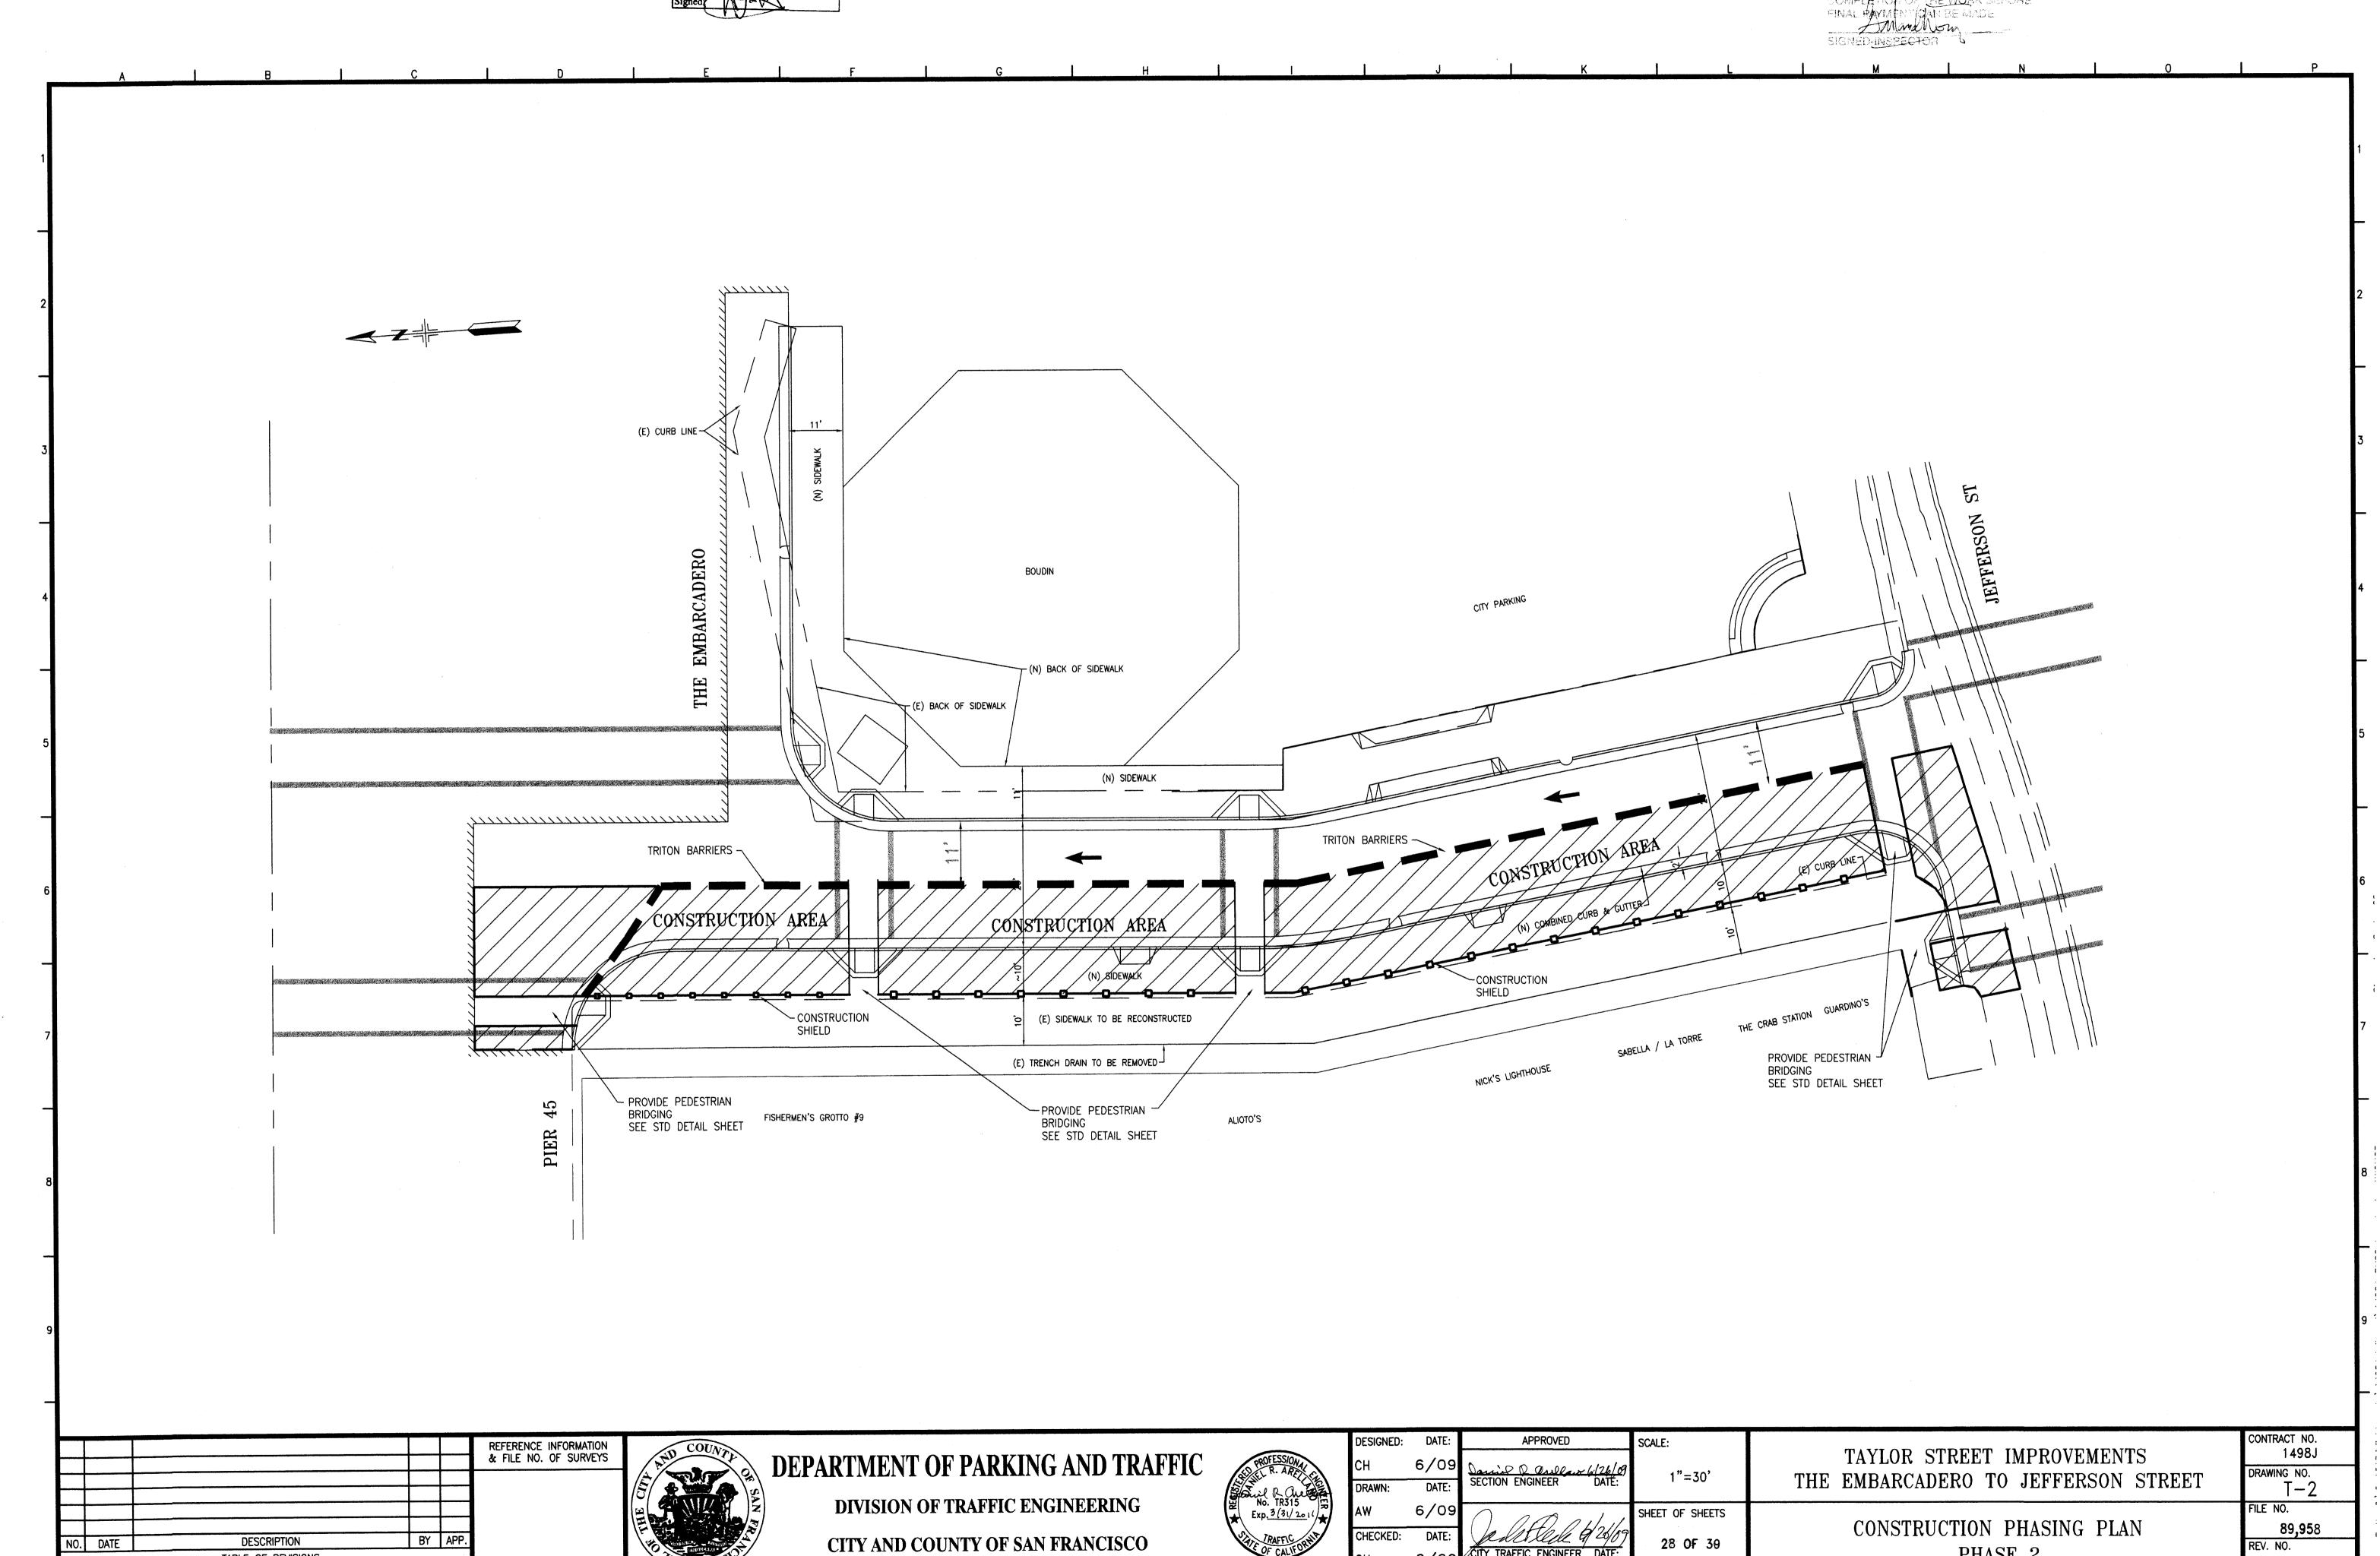

SHEET OF SHEETS

29 OF 39

CHECKED:

FILE NO.


REV. NO.

89,959

CONSTRUCTION PHASING PLAN

PHASE 3

Signed: AS BIJILT

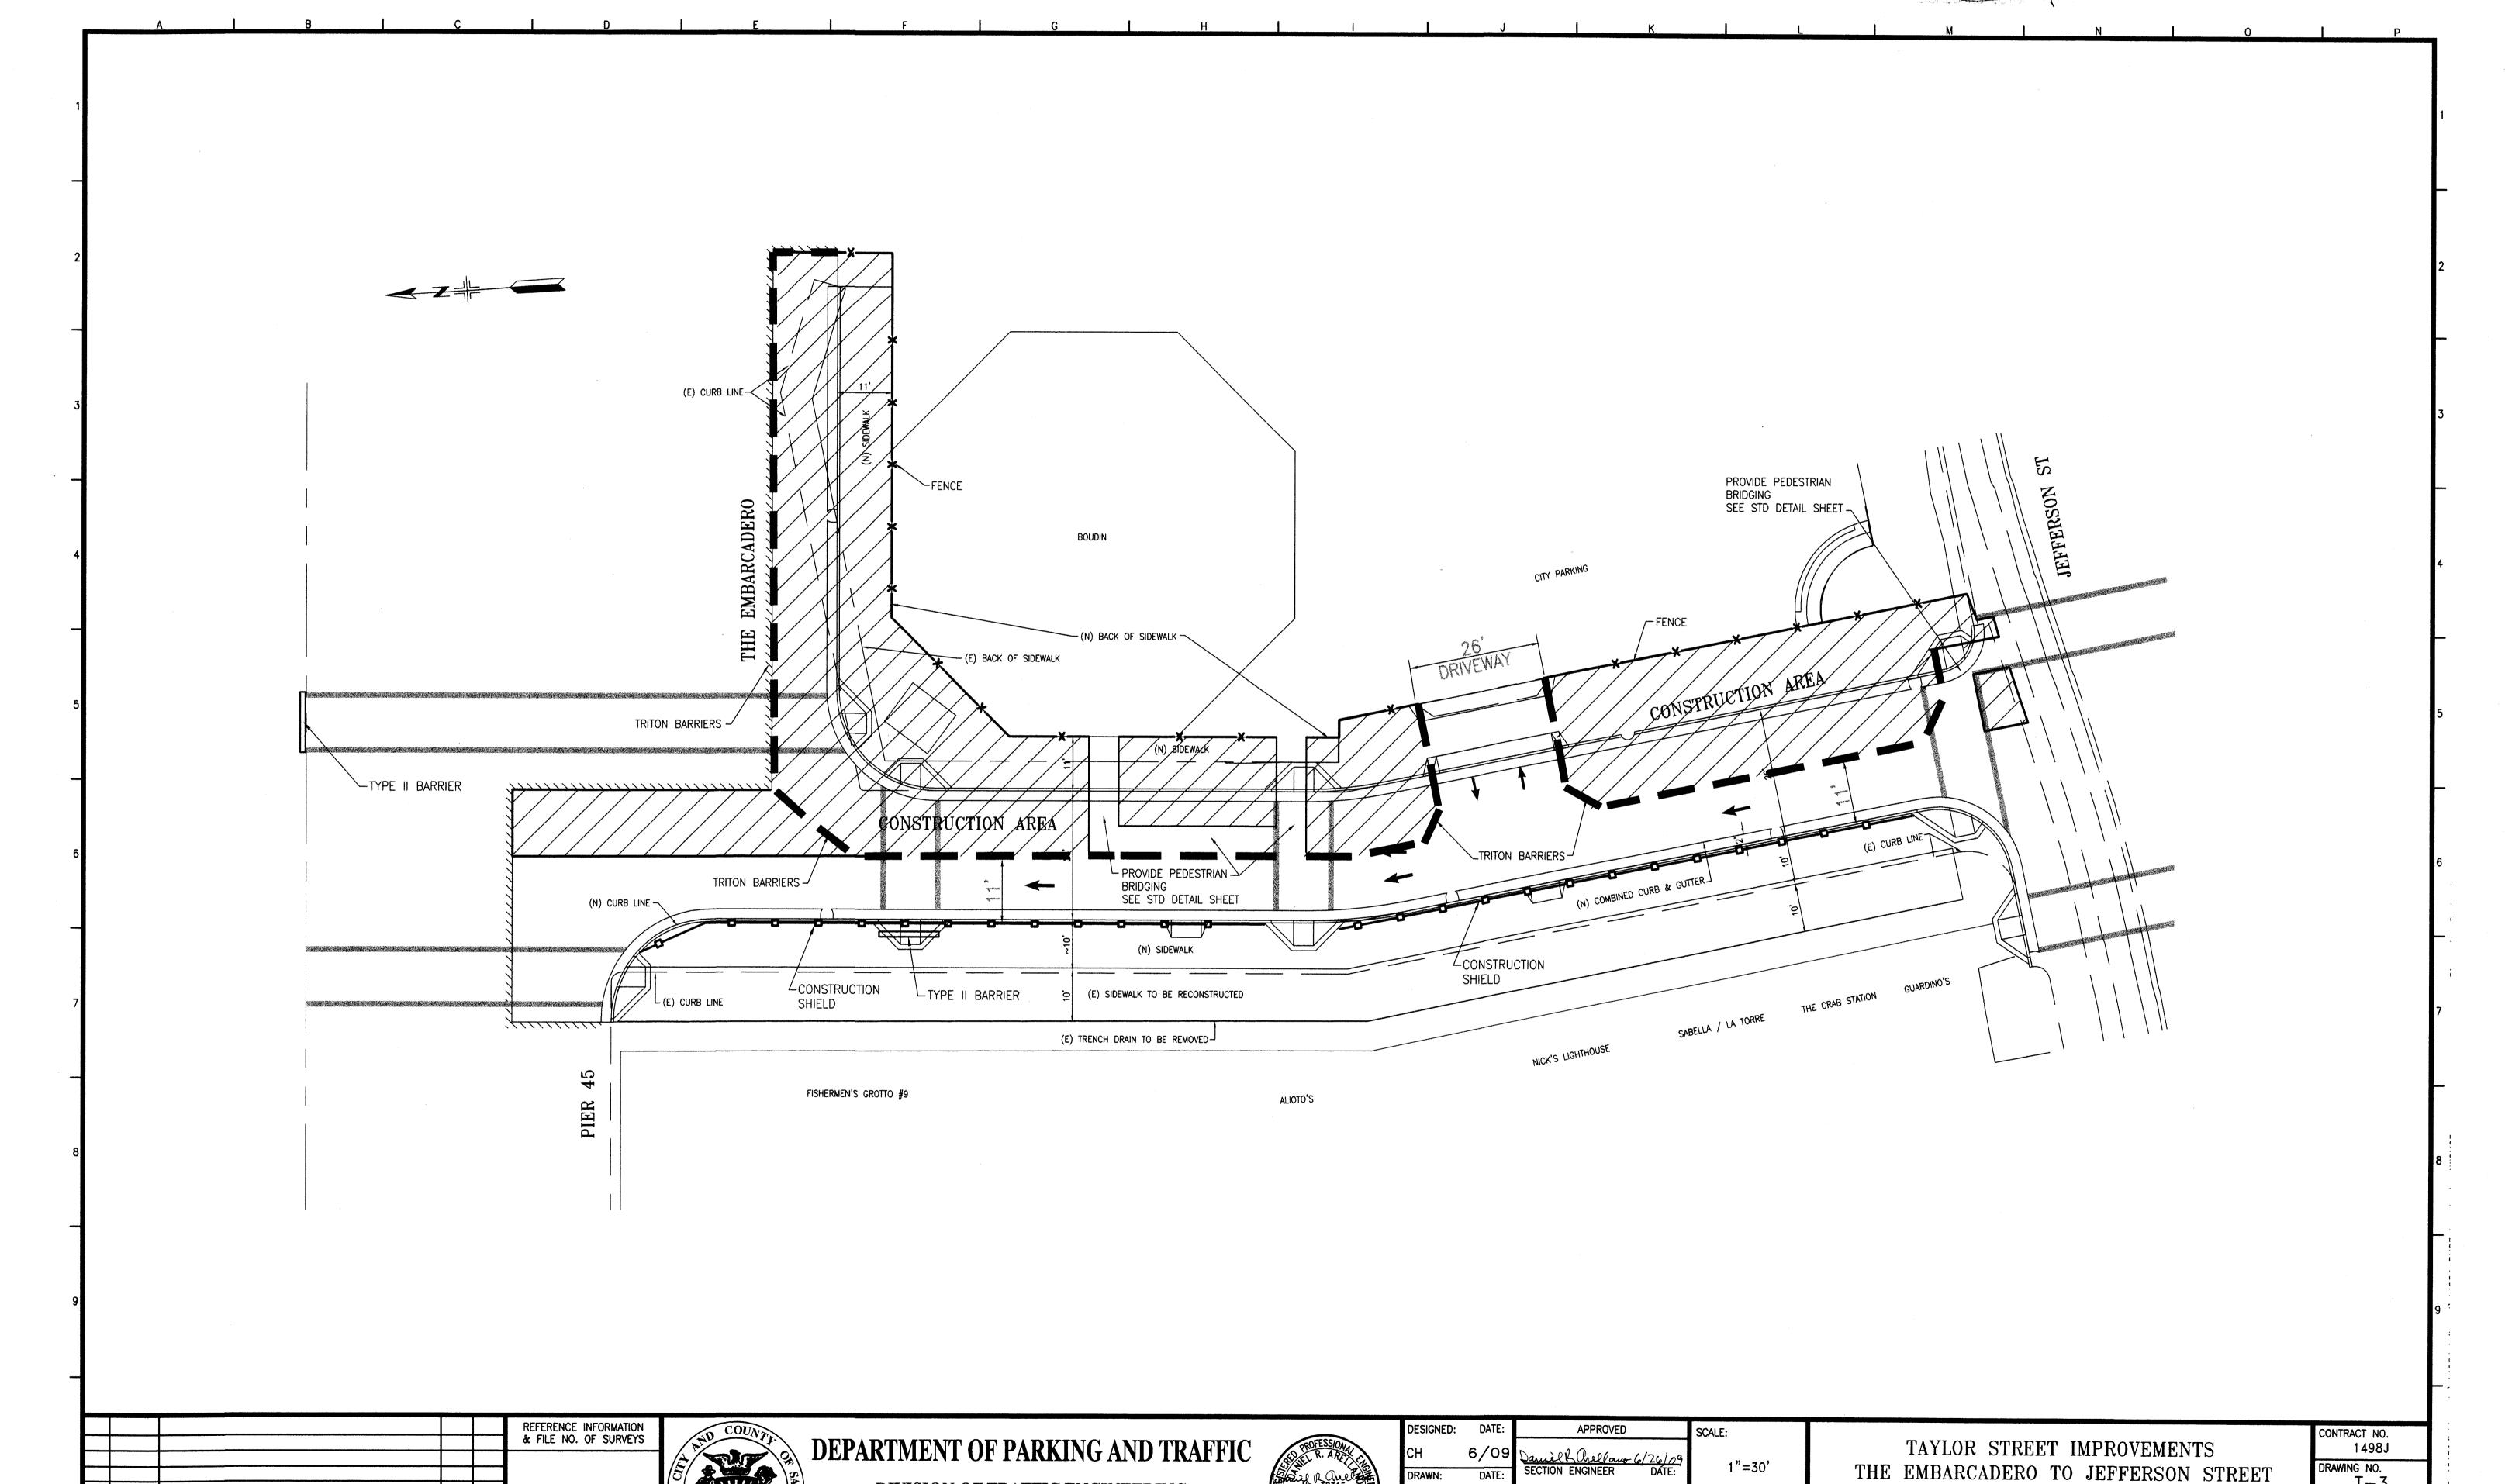


DIVISION OF TRAFFIC ENGINEERING


CITY AND COUNTY OF SAN FRANCISCO

NO. DATE

DESCRIPTION

TABLE OF REVISIONS
CHECK WITH TRACING TO SEE IF YOU HAVE LATEST REVISION

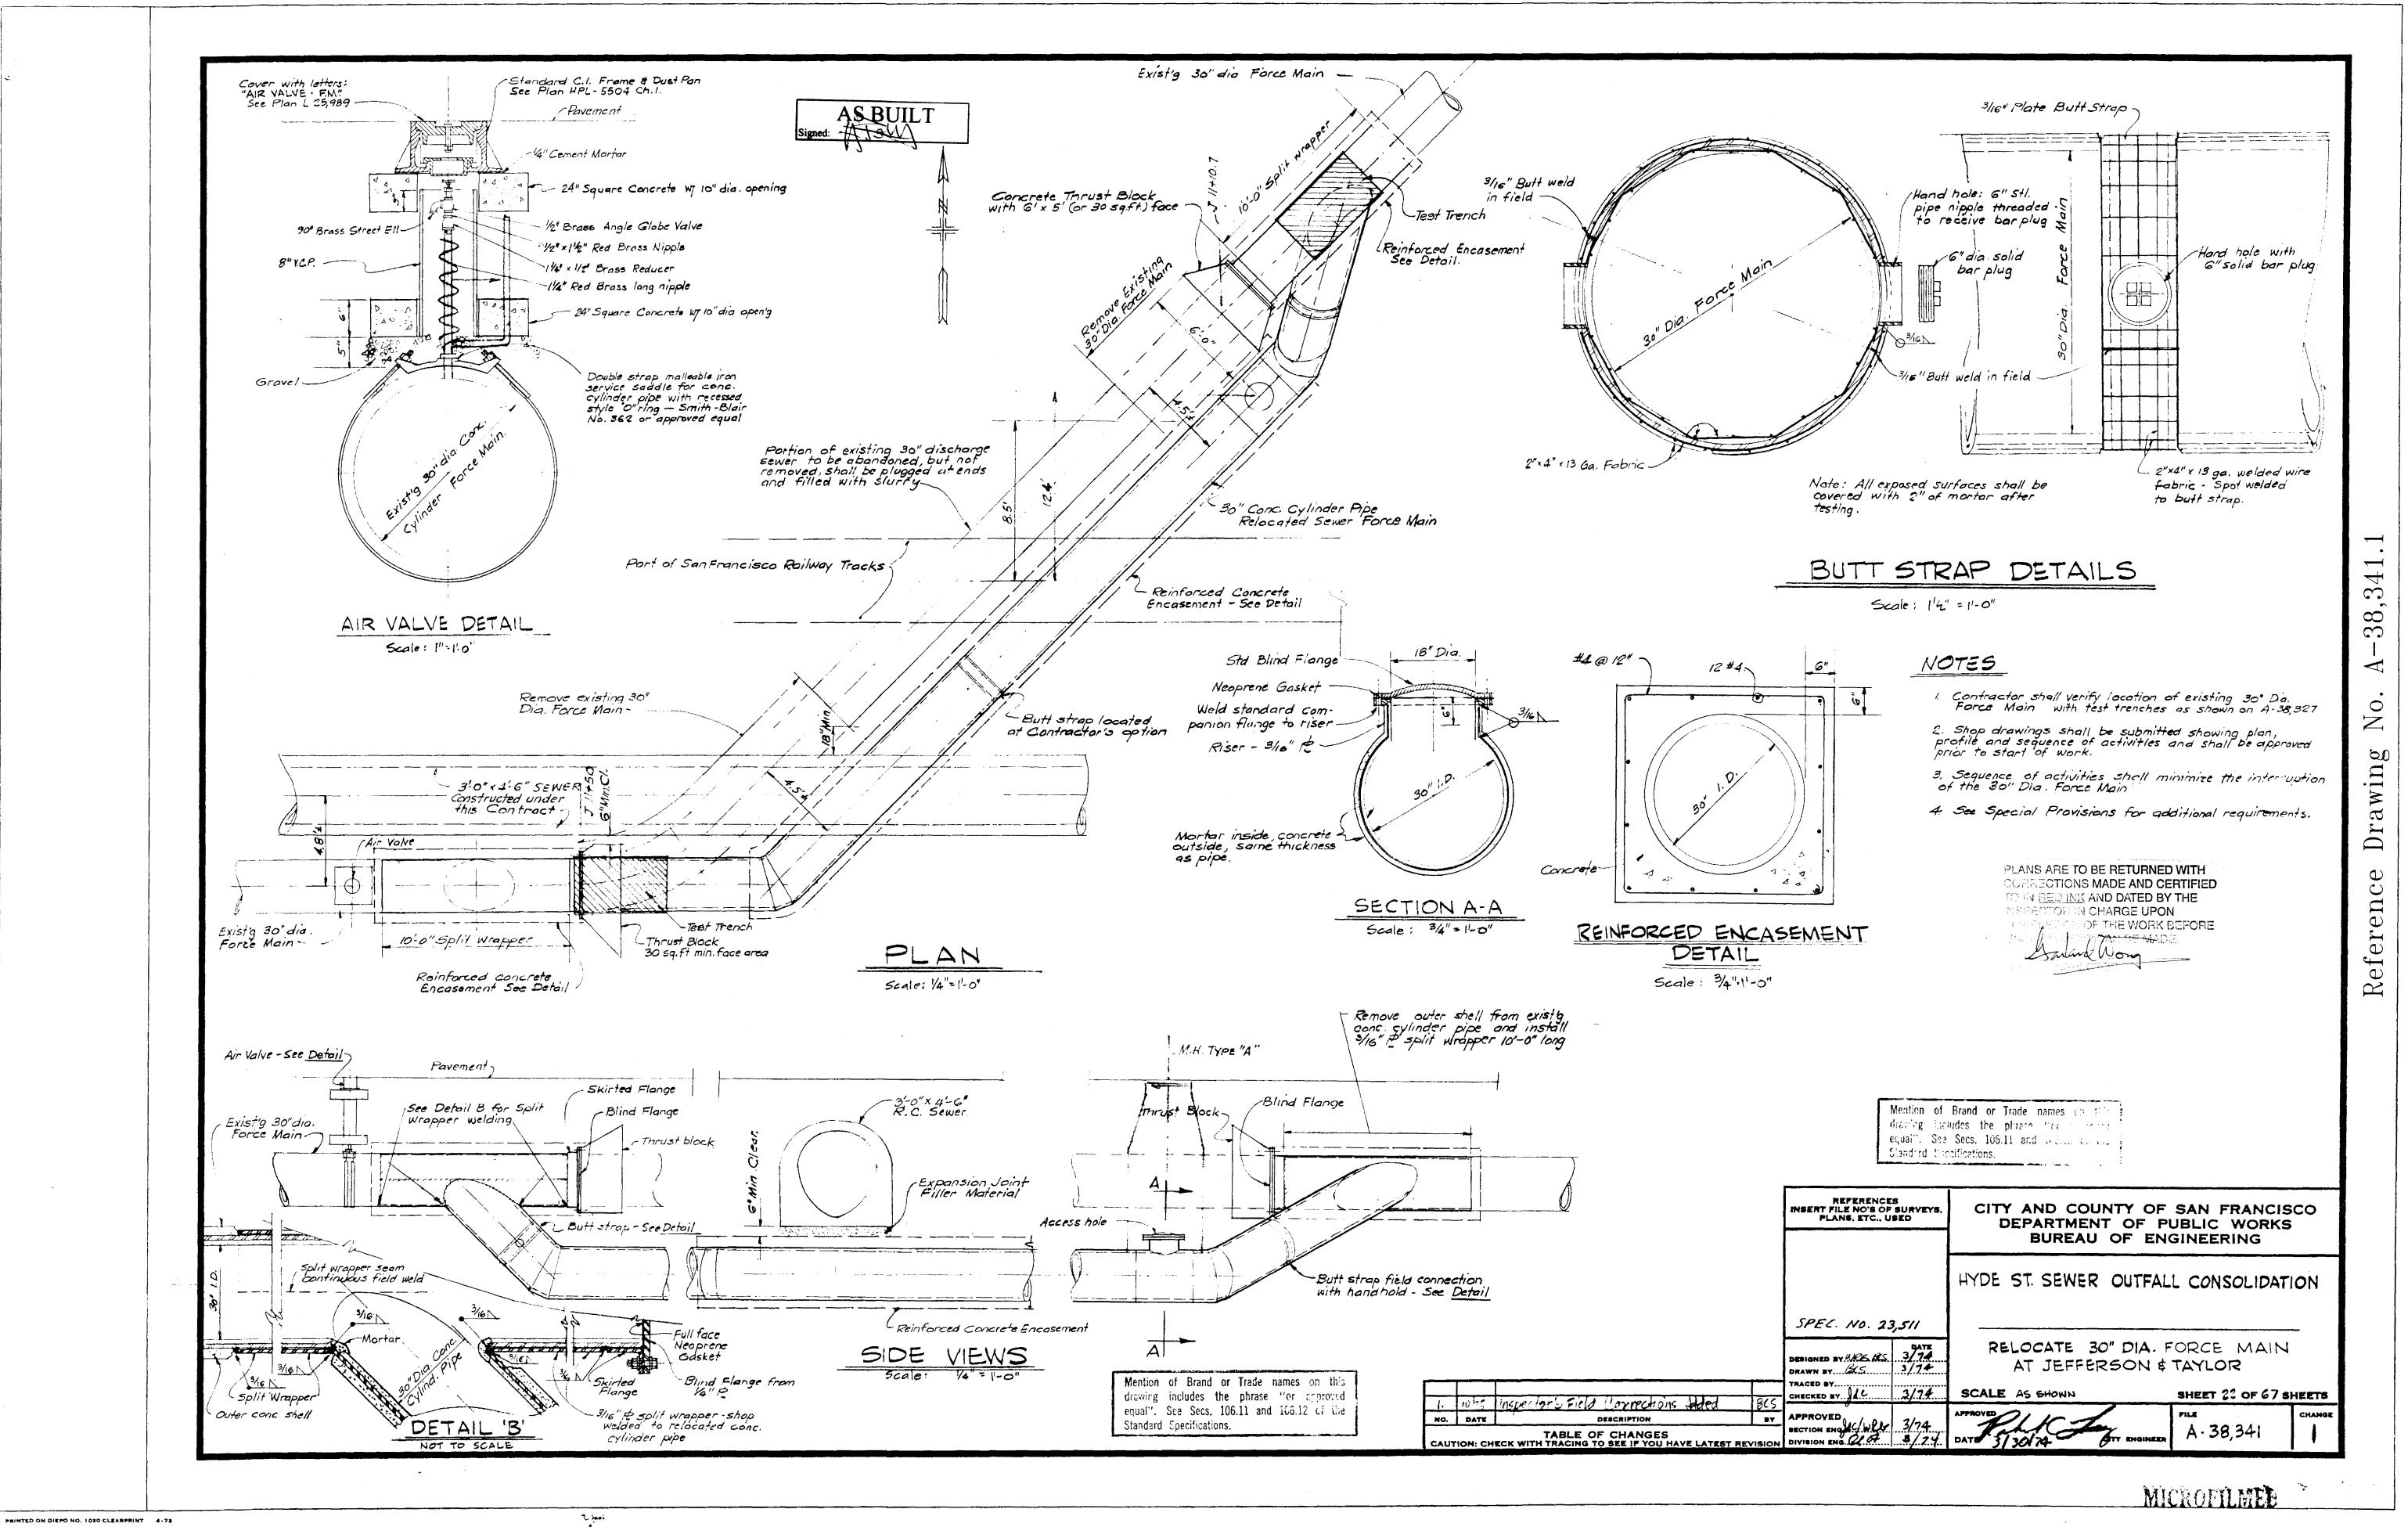

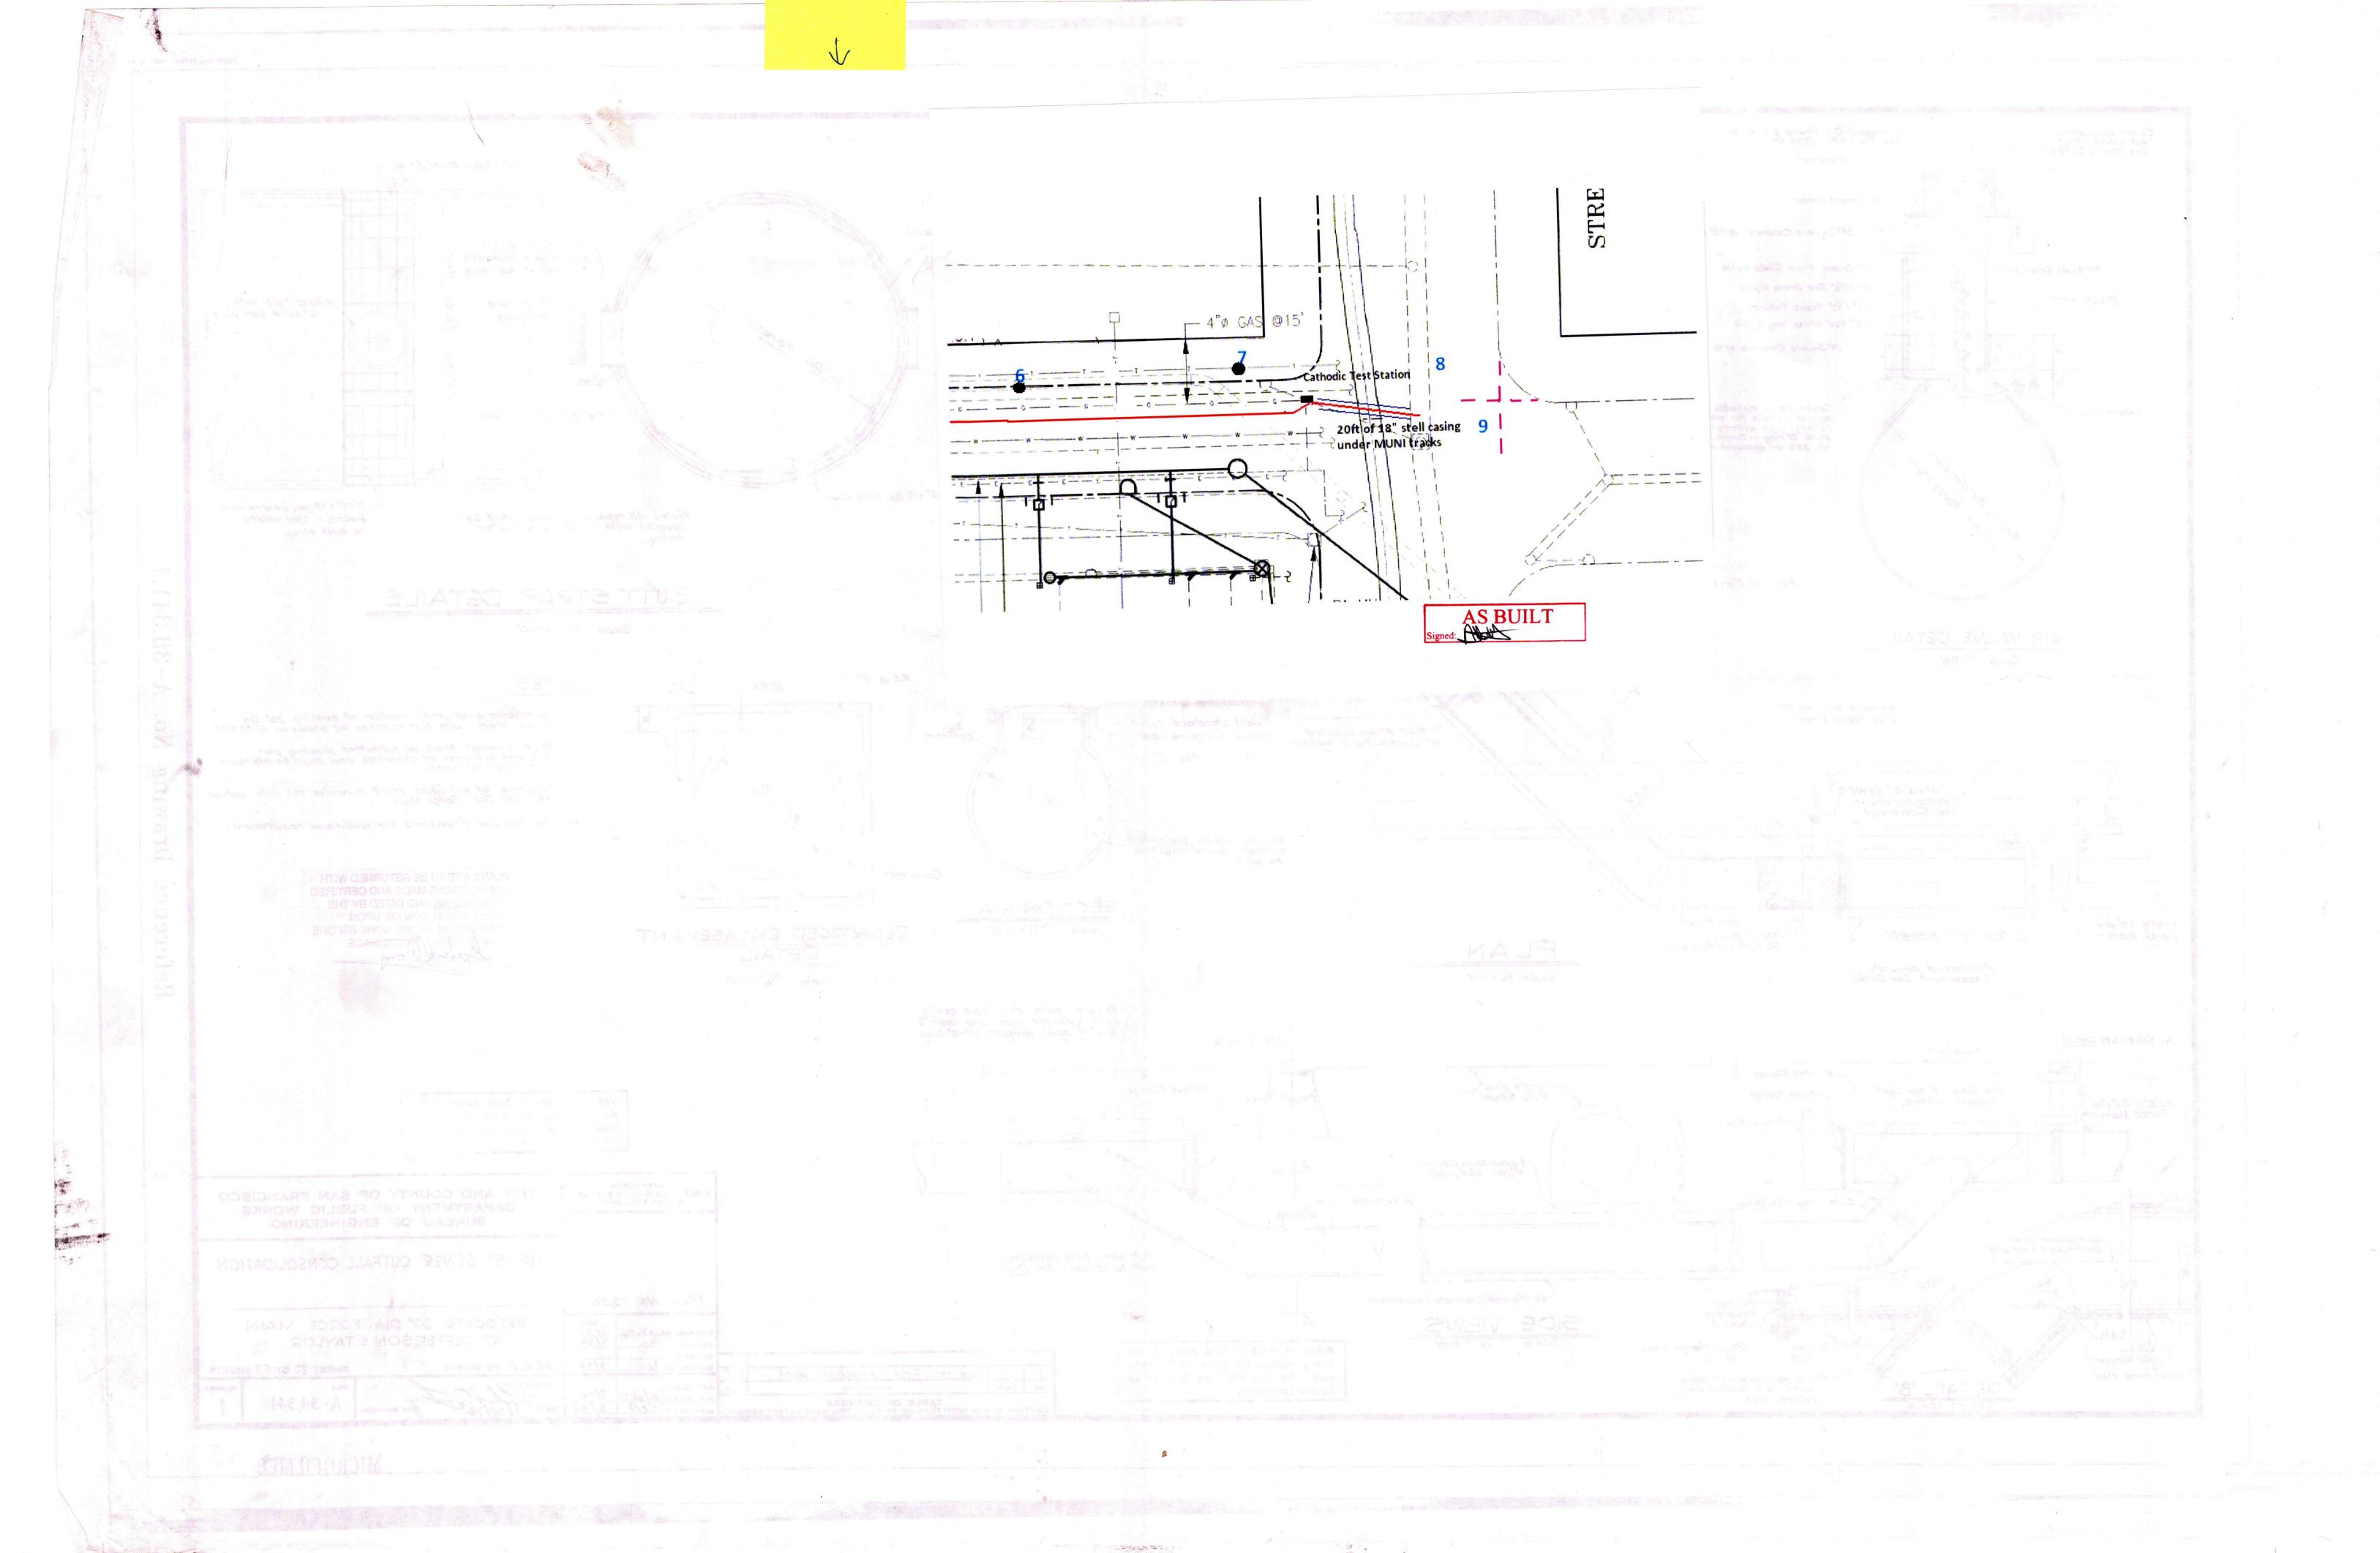



PLANS ARE TO BE RETURNED WITH CORRECTIONS MADE AND CERTIFIED TO IN RED INK AND DATED BY THE INSPECTOR IN CHARGE UPON COMPLETION OF THE WORK BEFORE
FINAL HAYMENT GAN: BE MADE.

SIGNED-INSPECTOR

GENERAL NOTES

- THE WORK INCLUDES THE FURNISHING OF ALL LABOR AND MATERIALS FOR THE COMPLETE INSTALLATION OF ALL ELECTRICAL SYSTEMS AND EQUIPMENT SPECIFIED, REFERRED TO, IMPLIED OR SHOWN ON THE DRAWINGS EXCEPT SUCH MATERIALS AND EQUIPMENT AS MAY BE SPECIFIED OR INDICATED TO BE PROVIDED BY OTHERS.
- THE ELECTRICAL CONTRACTOR SHALL VISIT JOB SITE AND VERIFY FIELD CONDITIONS BEFORE BIDDING AND SHALL INCLUDE IN HIS BID THE NECESSARY COSTS TO CONSTRUCT THIS PROJECT IN ACCORDANCE WITH THE SPECIFICATIONS, INTENT OF THE ELECTRICAL DRAWINGS AND ALL APPLICABLE CODES. ELECTRICAL CONTRACTOR SHALL ALLOW FOR DEMOLITION WORK NECESSARY FOR A COMPLETE INSTALLATION
- THE ELECTRICAL CONTRACTOR SHALL PERFORM HIS WORK IN ACCORDANCE WITH ALL CODES, RULES AND REGULATIONS OF GOVERNING AGENCIES HAVING JURISDICTION, ALL OF WHICH ARE HEREBY MADE A PART OF THE PLANS. THE CONTRACTOR SHALL OBTAIN NECESSARY PERMITS, HAVE WORK INSPECTED AND PAY FOR THE SAME.
- LOCATION OF ALL EQUIPMENT AND OUTLETS AS SHOWN ON THE DRAWINGS ARE APPROXIMATE ONLY, EXCEPT WHERE DIRECTED BY
- THE SIZE AND LOCATION OF EQUIPMENT IS SHOWN TO SCALE WHENEVER POSSIBLE, BUT THE CONTRACTOR SHALL MAKE USE OF ALL DATA IN ALL THE CONTRACT DOCUMENTS AND SHALL VERIFY THIS INFORMATION.
- IT SHALL BE THE RESPONSIBILITY OF THE CONTRACTOR TO INSTALL THE CONDUITS WITH MINIMUM NUMBER OF BENDS IN SUCH A MANNER AS TO CONFORM TO THE STRUCTURES, AVOID OBSTRUCTIONS, MAINTAIN HEAD ROOM, DEEP OPENINGS AND PASSAGEWAYS CLEAR, BE COMPATIBLE WITH LATEST CONSTRUCTION METHOD, AND MEET ALL STRUCTURAL CODE REQUIREMENTS. FURNISH AND INSTALL PULL BOX AS NECESSARY FOR LONG CONDUIT RUNS.
- CONTRACTOR TO BE RESPONSIBLE FOR ALL ELECTRICAL GROUNDING AND BRACING REQUIREMENTS FOR EQUIPMENT.
- THE COMPLETE INSTALLATION, INCLUDING THE NEUTRAL CONDUCTOR, METALLIC CONDUIT AND RACEWAYS, BOXES, CABINETS AND EQUIPMENT, SHALL BE PERMANENTLY AND EFFECTIVELY GROUNDED IN ACCORDANCE WITH ALL CODE REQUIREMENTS, WHETHER OR NOT SUCH CONNECTIONS ARE SPECIFICALLY SHOWN AND/OR SPECIFIED.
- ALL PARTS OF THE ELECTRICAL SYSTEM SHALL BE GUARANTEED TO PERFORM THE REQUIRED FUNCTION IN ACCORDANCE WITH THE PERFORMANCE REQUIREMENTS WHICH ARE INDICATED OR WHERE SUCH PARTICULAR REQUIREMENTS ARE NOT STATED, THEY SHALL PERFORM IN ACCORDANCE WITH THE PREVAILING RECOGNIZED TRADE STANDARDS OF PERFORMANCE. DURING THE PERIOD OF ONE YEAR REPAIRS OR REPLACEMENTS NECESSARY TO ACCOMPLISH THE REQUIRED PERFORMANCE.
- IN THE EVENT OF FAILURE OF ANY WORK, EQUIPMENT OR SERVICE DURING THE LIFE OF THE GUARANTEE, CONTRACTOR SHALL REPAIR OR REPLACE THE DEFECTIVE WORK AND SHALL REMOVE, REPLACE OR RESTORE, AT NO COST TO OWNER, ANY PART OF THE STRUCTURE OR BUILDING WHICH MAY BE DAMAGED AS THE DIRECT RESULT OF HIS DEFECTIVE WORK OR MATERIAL.
- ALL ELECTRICAL EQUIPMENT, FUSES AND CIRCUIT BREAKERS SHALL HAVE AN INTERRUPTING RATING NOT LESS THAN THE MAXIMUM SHORT CIRCUIT TO WHICH THEY MAY BE SUBJECTED.
- ELECTRICAL CONTRACTOR SHALL SEE THAT ALL CONDUIT, METALLIC RACEWAYS DO NOT MAKE CONTACT WITH PLUMBING LINES AND
- 13. THE CONTRACTOR SHALL BE LICENSED TO PERFORM THE WORK OUTLINED, TO BE FAMILIAR WITH ALL LOCAL CODES HAVING JURISDICTION AND TO HAVE REVIEWED THE DRAWINGS AND SPECIFICATIONS AND VERIFIED THAT ALL SYSTEMS CONTAINED THEREIN ARE IN COMPLIANCE WITH THOSE CODES HAVING JURISDICTION BY THE ACT OF SUBMITTING A BID. THE CONTRACTOR SHALL BE DEEMED TO HAVE ACCEPTED SUCH CONDITIONS AND RESPONSIBILITY AND TO HAVE MADE ALLOWANCES THEREFORE IN PREPARING HIS FIGURES SO THAT THERE WILL BE NO ADDITIONAL COSTS REQUESTED FOR ANY ADDITIONAL REQUIREMENTS MADE BY THOSE AGENCIES HAVING JURISDICTION.
- 14. ALL ELECTRICAL MATERIALS AND EQUIPMENT SHALL BE NEW UNLESS OTHERWISE NOTED ON DRAWINGS, AND LISTED BY UNDERWRITERS
- 15. ALL WIRES AND CABLES SHALL BE COPPER, RATED 600 VOLTS, TYPE THHN/THWN INSULATION, COLOR CODES PER INSPECTION AUTHORITY. ALL CONDUCTORS SHALL BE COPPER, NUMBER 12 AWG MINIMUM.
- ALL WIRES AND CABLES SHALL BE INSTALLED IN METAL CONDUIT, SURFACE METAL RACEWAY, TRENCH DUCT/FLOOR DUCT OR OTHER APPROVED RACEWAY SYSTEM. NO SURFACE RUNS IN FINISHED OFFICE SPACES.
- 17. MOUNTING, SUPPORTING, AND ANCHORING OF ALL ELECTRICAL EQUIPMENT SHALL BE IN STRICT COMPLIANCE WITH SEISMIC RESTRAINT REQUIREMENTS OF THE OFFICE OF THE STATE ARCHITECT.
- ALL BRANCH CIRCUITS SHOWN ON DRAWING ARE NEW. PANELBOARD CIRCUIT DIRECTORY SHALL BE LABELED (TYPEWRITTEN) AS PER
- ELECTRICAL CONTRACTOR SHALL FURNISH AS-BUILT DRAWINGS TO THE ENGINEER ON COMPLETION OF THE JOB.
- ELECTRICAL DEVICE MOUNTING HEIGHT SHALL BE PER ADA GUIDELINES.
- 21. ALL JUNCTION BOXES, PULL BOXES, CONDUITS ENTERING OR LEAVING AN AREA OR ROOM OR PASSING THROUGH A WALL OR FLOOR FOR BRANCH CIRCUITS SHALL BE CLEARLY MARKED WITH PERMANENT BLACK INK PEN IDENTIFYING THE BRANCH CIRCUIT CONTAINED.
- 22. ALL METALLIC RACEWAYS, INCLUDING THE EXISTING, SHALL BE SECURELY FASTENED IN PLACE WITH APPROVED HANGERS NOT MORE THAN 10 FEET APART AND WITHIN 3 FEET OF EACH OUTLET BOX, JUNCTION BOX, DEVICE BOX, CABINET, CONDUIT BODY, OR OTHER
- 23. ELECTRICAL CONTRACTOR SHALL FURNISH AS-BUILT DRAWINGS TO THE ENGINEER ON COMPLETION OF THE JOB.
- 24. ELECTRICAL DEVICE MOUNTING HEIGHT SHALL BE PER ADA GUIDELINES.
- 25. ALL DEVICES AND EQUIPMENT INSTALLED OUTDOORS OR EXPOSED TO THE WEATHER SHALL BE MARINE DUTY WEATHERPROOF
- 26. GROUNDING CONDUCTORS ARE GENERALLY NOT SHOWN. BOND AND GROUND ALL EQUIPMENT, RACEWAYS MOTORS, PANELBOARD AND EXPOSED CONDUCTIVE PARTS IN ACCORDANCE WITH THE SPECIFICATION AND THE NEC.
- COORDINATE LOCATION OF ALL EQUIPMENT, BELOW GROUND CONDUITS, PULLBOXES AND LIGHTING POLES WITH EXISTING BELOW GROUND SERVICES AND AGREE LOCATIONS WITH THE ENGINEER PRIOR TO INSTALLATION.

LEGEND AND SYMBOLS

PC EXTERNALLY MOUNTED LIGHTING CONTROL PHOTOCELL.

POLE MOUNTED LIGHTING FIXTURE. A INDICATES TIME SWITCH CHANNEL NO.

PULLBOX, CHRISTY N19 OR EQUAL.

 $\langle D \rangle$ LIGHTING FIXTURE TAG. D INDICATES FIXTURE TYPE.

CONDUIT UNDERGROUND OR ENCASED IN CONCRETE

CONDUIT CAPPED

ELECTRICAL ABBREVIATIONS

A	AMMETER, AMPERE	KVĄ	KILOVOLT AMPERE(S)
AFF	ABOVE FINISHED FLOOR	KW	KILOWATT(S)
AUX	AUXILIARY	(N)	NEW
AWG	AMERICAN WIRE GAGE	N,NEUT	NEUTRAL
BKR	BREAKER	NIC	NOT IN CONTRACT
С	CONDUIT	NC	NORMALLY CLOSED
СВ	CIRCUIT BREAKER	NO	NORMALLY OPEN
CKT	CIRCUIT	P,PNL	PANEL
СО	CONDUIT ONLY	PB	PULL BOX
СОММ	COMMUNICATIONS	PC	PHOTCELL
COND	CONDUCTOR	РН	PHASE
CONT	CONTROL	PUC	PUBLIC UTILITIES COMMISSION
CS	CONTROL STATION	PVC	POLY VINYL CHLORIDE
CU	COPPER	PWR	POWER
(E)	EXISTING	(R)	RELOCATED
ELEC	ELECTRICAL	RES	RESISTOR
EMT	ELECTRICAL METALLIC TUBING	SW	SWITCH
G,GND	GROUND	TL	TWISTLOCK
GFI	GROUND FAULT INTERRUPTER	UG	UNDERGROUND
НН	HANDHOLE	UNO	
HID	HIGH INTENSITY DISCHARGE	V	UNLESS NOTED OTHERWISE
J,JB	JUNCTION BOX	w _P	VOLTMETER, VOLT
SM.		***	WEATHERPROOF

GENERAL DEMOLITION NOTES:

- ELECTRICAL DEVICES SHOWN ON DEMOLITION DRAWINGS ARE BASED ON FIELD OBSERVATION AND EXISITNG RECORD DOCUMENTS. FIELD VERIFY FOR EXACT EXTENT OF WORK INVOLVED BEFORE BEGINNING DEMOLITION.
- REMOVE AND RELOCATE EXISTING CONDUITS CARRYING POWER, LIGHTING AND OTHER SYSTEMS. FIELD-VERIFY EXTENT OF WORK. NEW MATERIAL AND METHODS ADOPTED SHALL BE COMPATIBLE WITH EXISTING SYSTEM.
- C. REPAIR ANY FINISHES DAMAGED DURING DEMOLITION.
- MAINTAIN ACCESS TO EXISTING ELECTRICAL INSTALLATION WHICH REMAIN ACTIVE.
- REMOVED MATERIALS NOT REQUIRED FOR PRESENT OR FUTURE USE OF THE FACILITY, AND NOT CLAIMED BY THE PORT, BECOME PROPERTY OF THE CONTRACTOR AND REMOVE FROM PREMISES. VERIFY WITH OWNER BEFORE REMOVING ANY RE-USABLE MATERIALS FROM PREMISES. CAREFULLY REMOVE MATERIALS CLAIM BY THE PORT TO PREVENT DAMAGE AND DELIVER ON-SITE WHERE DIRECTED.

GENERAL NOTES

- LEGEND, ABBREVIATIONS, GENERAL NOTES AND DRAWING INDEX
- ELECTRICAL DEMOLITION PLAN AREA 1
- ELECTRICAL DEMOLITION PLAN AREA 2
- ELECTRICAL PLAN AREA 1
- ELECTRICAL PLAN AREA 2
- ELECTRICAL DETAILS

DPW FILE NO. 89,952 CONTRACT NO.

RAWING NO.

1498J

E-1


REFERENCE INFORMATION & FILE NO. OF SURVEYS NO. DATE DESCRIPTION BY APP TABLE OF REVISIONS CHECK WITH TRACING TO SEE IF YOU HAVE LATEST REVISION





SAN FRANCISCO PORT COMMISSION PORT OF SAN FRANCISCO DEPARTMENT OF ENGINEERING

PROFESSIONA PROFESSIONA No.E15415 EXP. 6-30-2009	
6/27/09	

DESIGNED: JJL	
DRAWN: JJL	
CHECKED:	

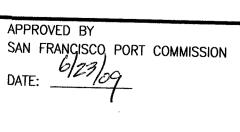

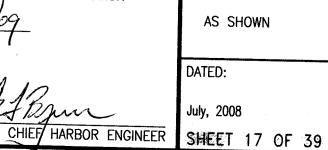

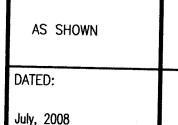

TAYLOR STREET IMPROVEMENTS THE EMBARCADERO TO JEFFERSON STREET LEGEND, ABBREVIATIONS, GENERAL NOTES


AND DRAWING INDEX

FILE NO. 13348-4006-E REV. NO.

G:\01 PROJECTS\PORTWIDE\TAYLOR ST\DRAWINGS\FLECTRICAL\E-1.DWG

PLANS ARE TO BE RETURNED WITH CORRECTIONS MADE AND CERTIFIED TO IN RED INK AND DATED BY THE INSPECTOR IN CHARGE UPON COMPLETION OF THE WORK BEFORE FINAL PAYMENT CAN BE MADE.


SIGNED-INSPECTOR

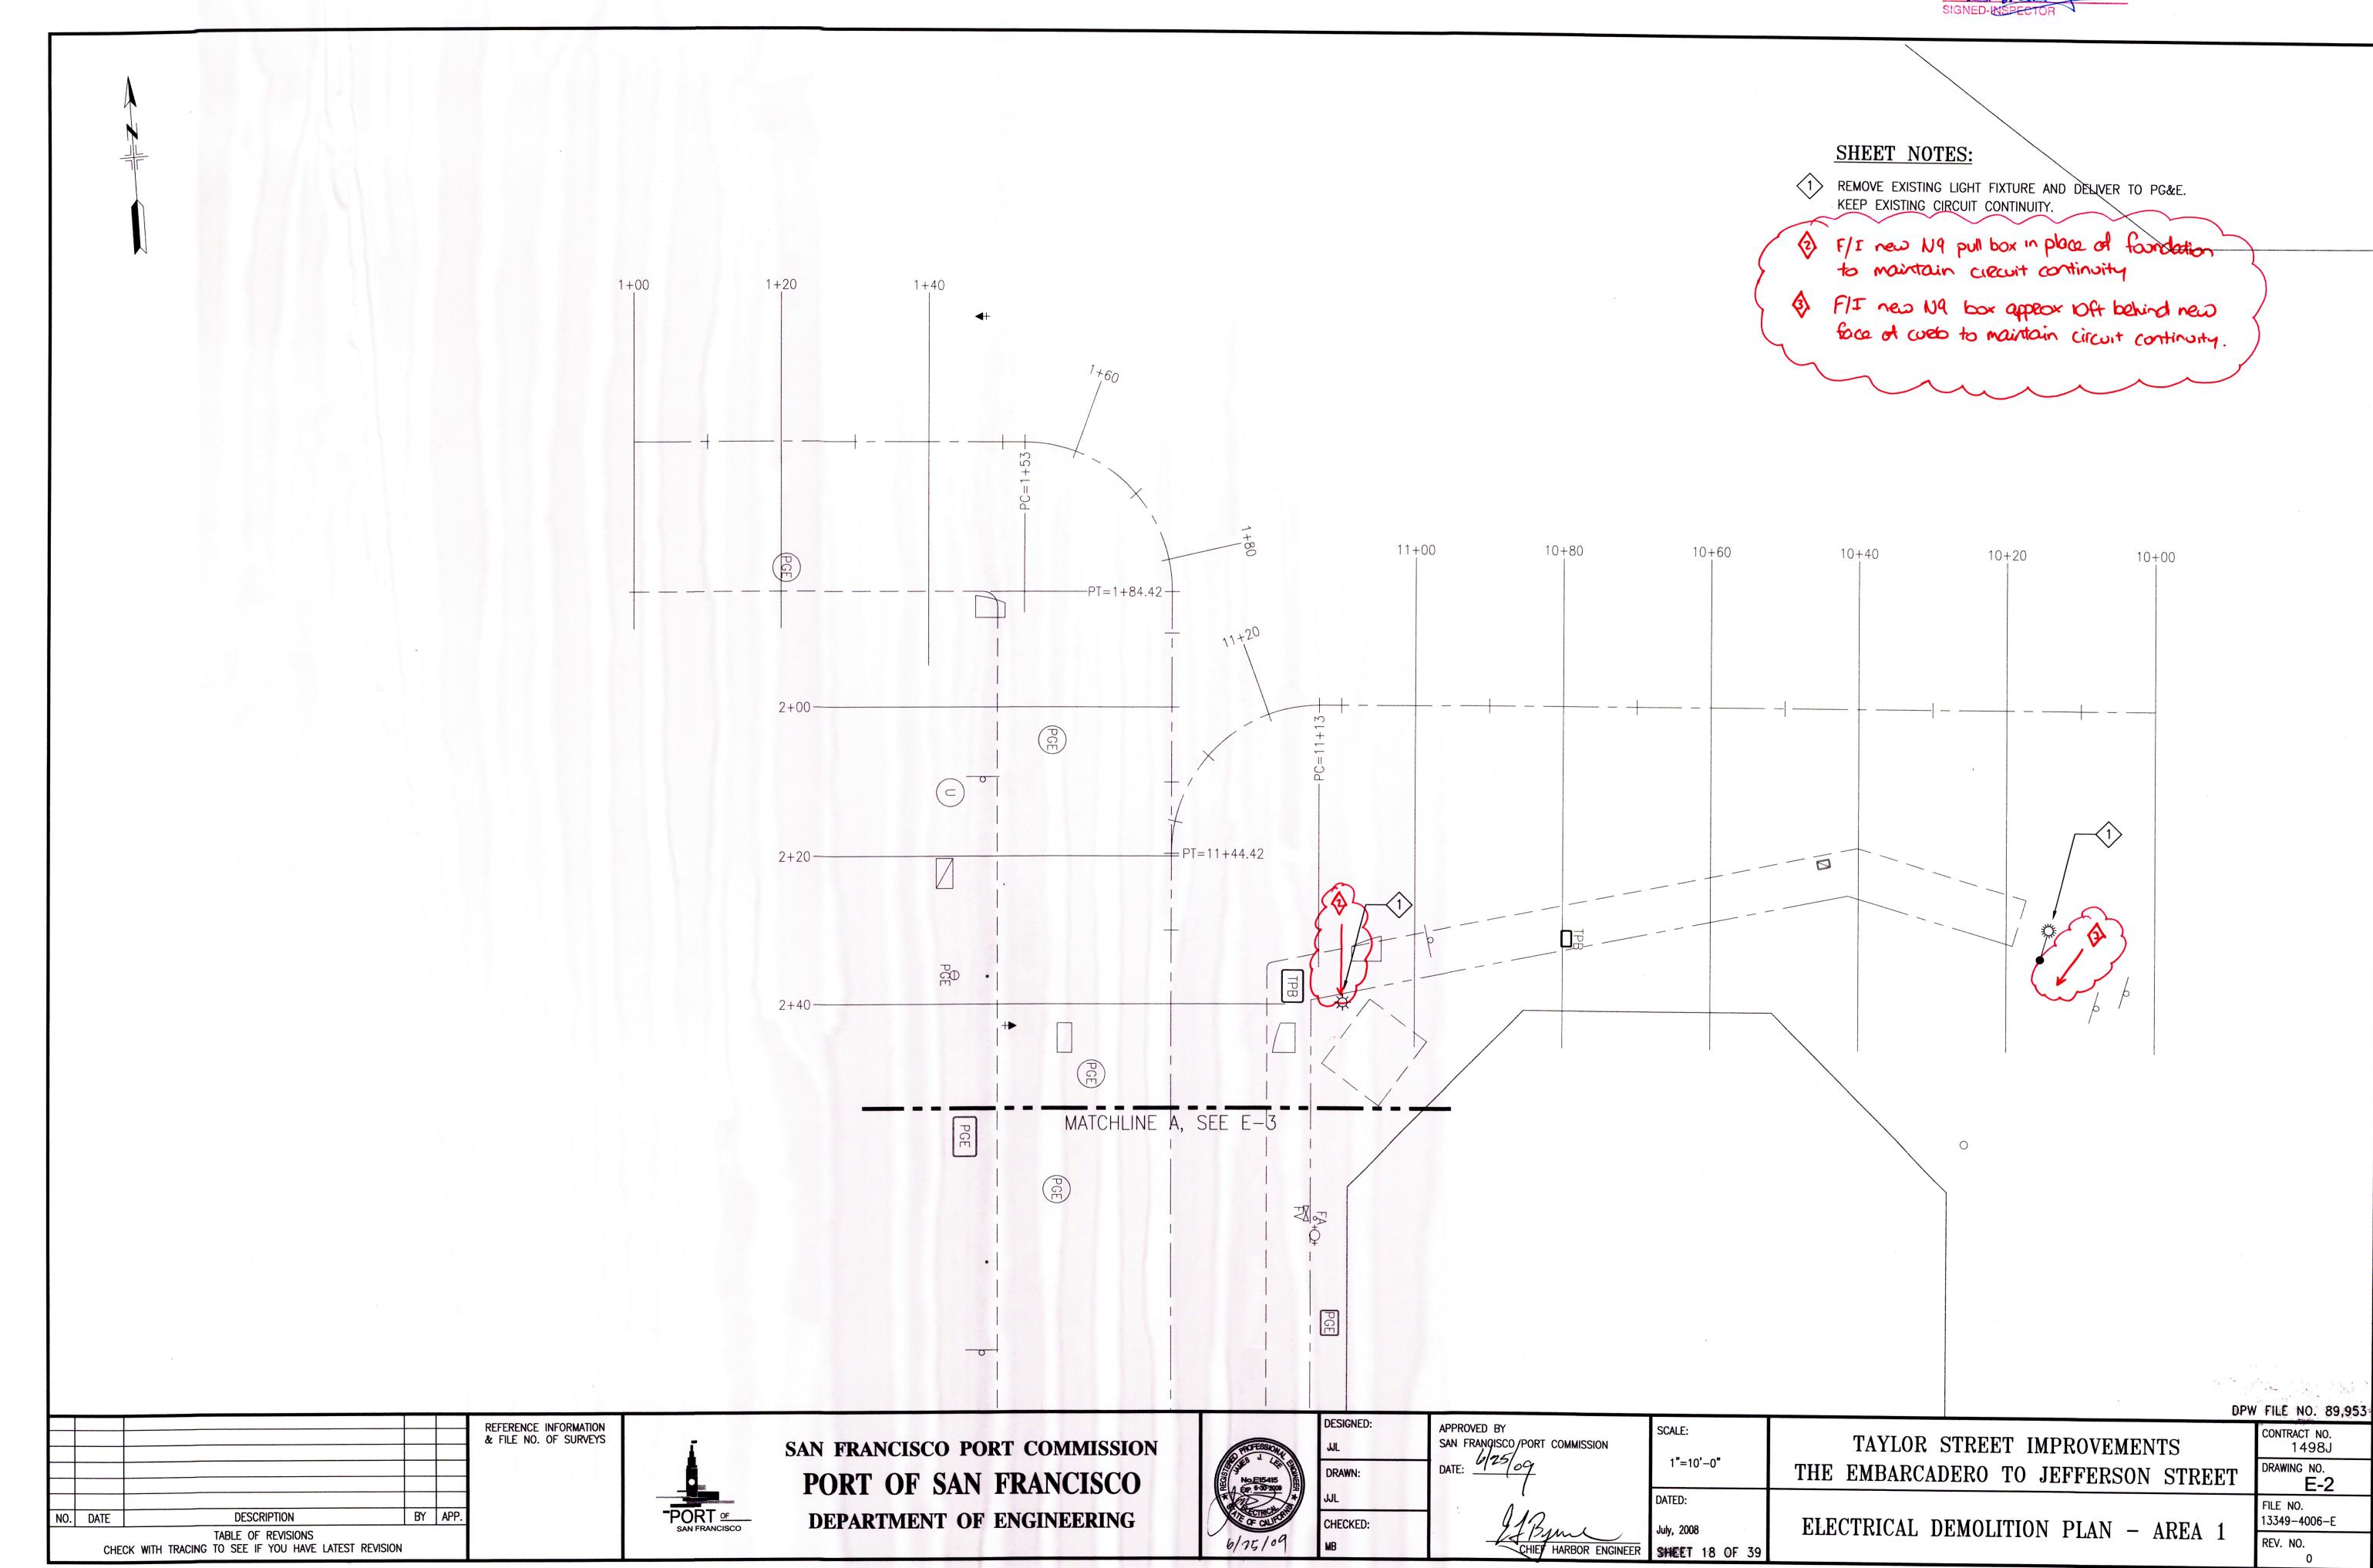




PLANS ARE TO BE RETURNED WITH CORRECTIONS MADE AND CERTIFIED TO IN RED INK AND DATED BY THE INSPECTOR IN CHARGE UPON COMPLETION OF THE WORK BEFORE FINAL PAYMENT CAN BE MADE.

SIGNED-INSPECTOR

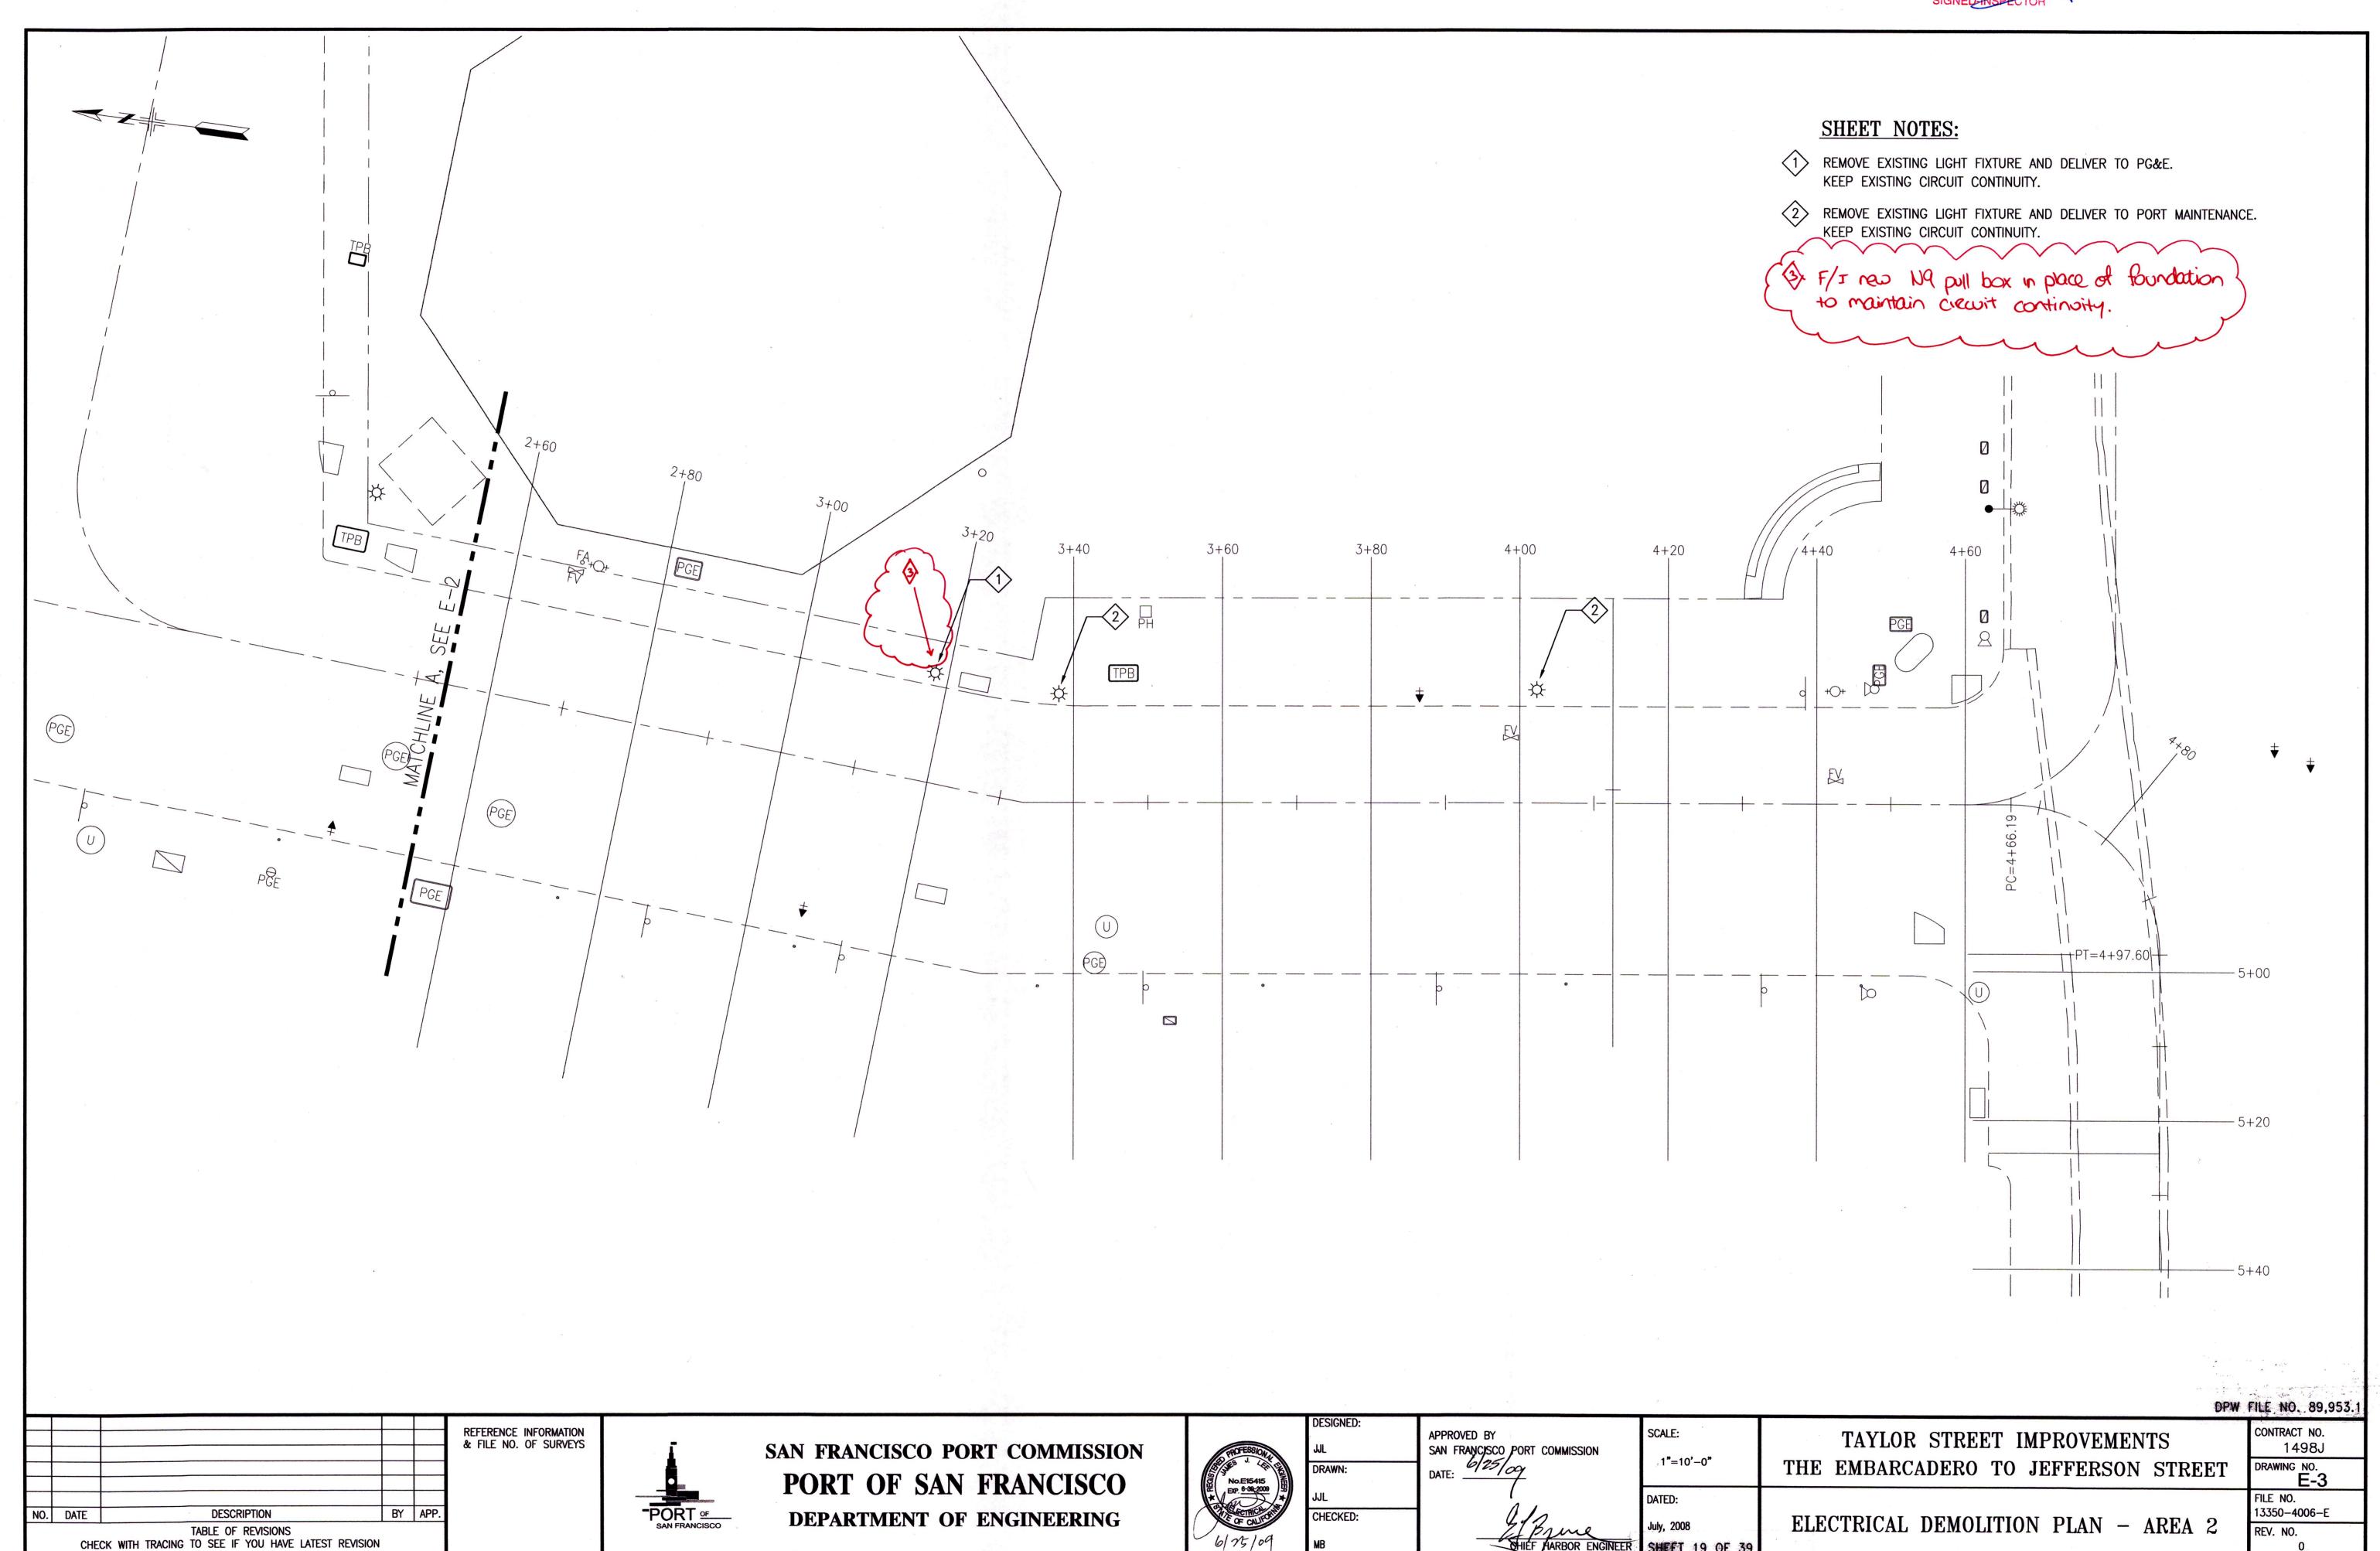



PLANS ARE TO BE RETURNED WITH CORRECTIONS MADE AND CERTIFIED TO IN RED INK AND DATED BY THE **INSPECTOR IN CHARGE UPON** COMPLETION OF THE WORK BEFORE FINAL PAYMENT OAN BE MADE.

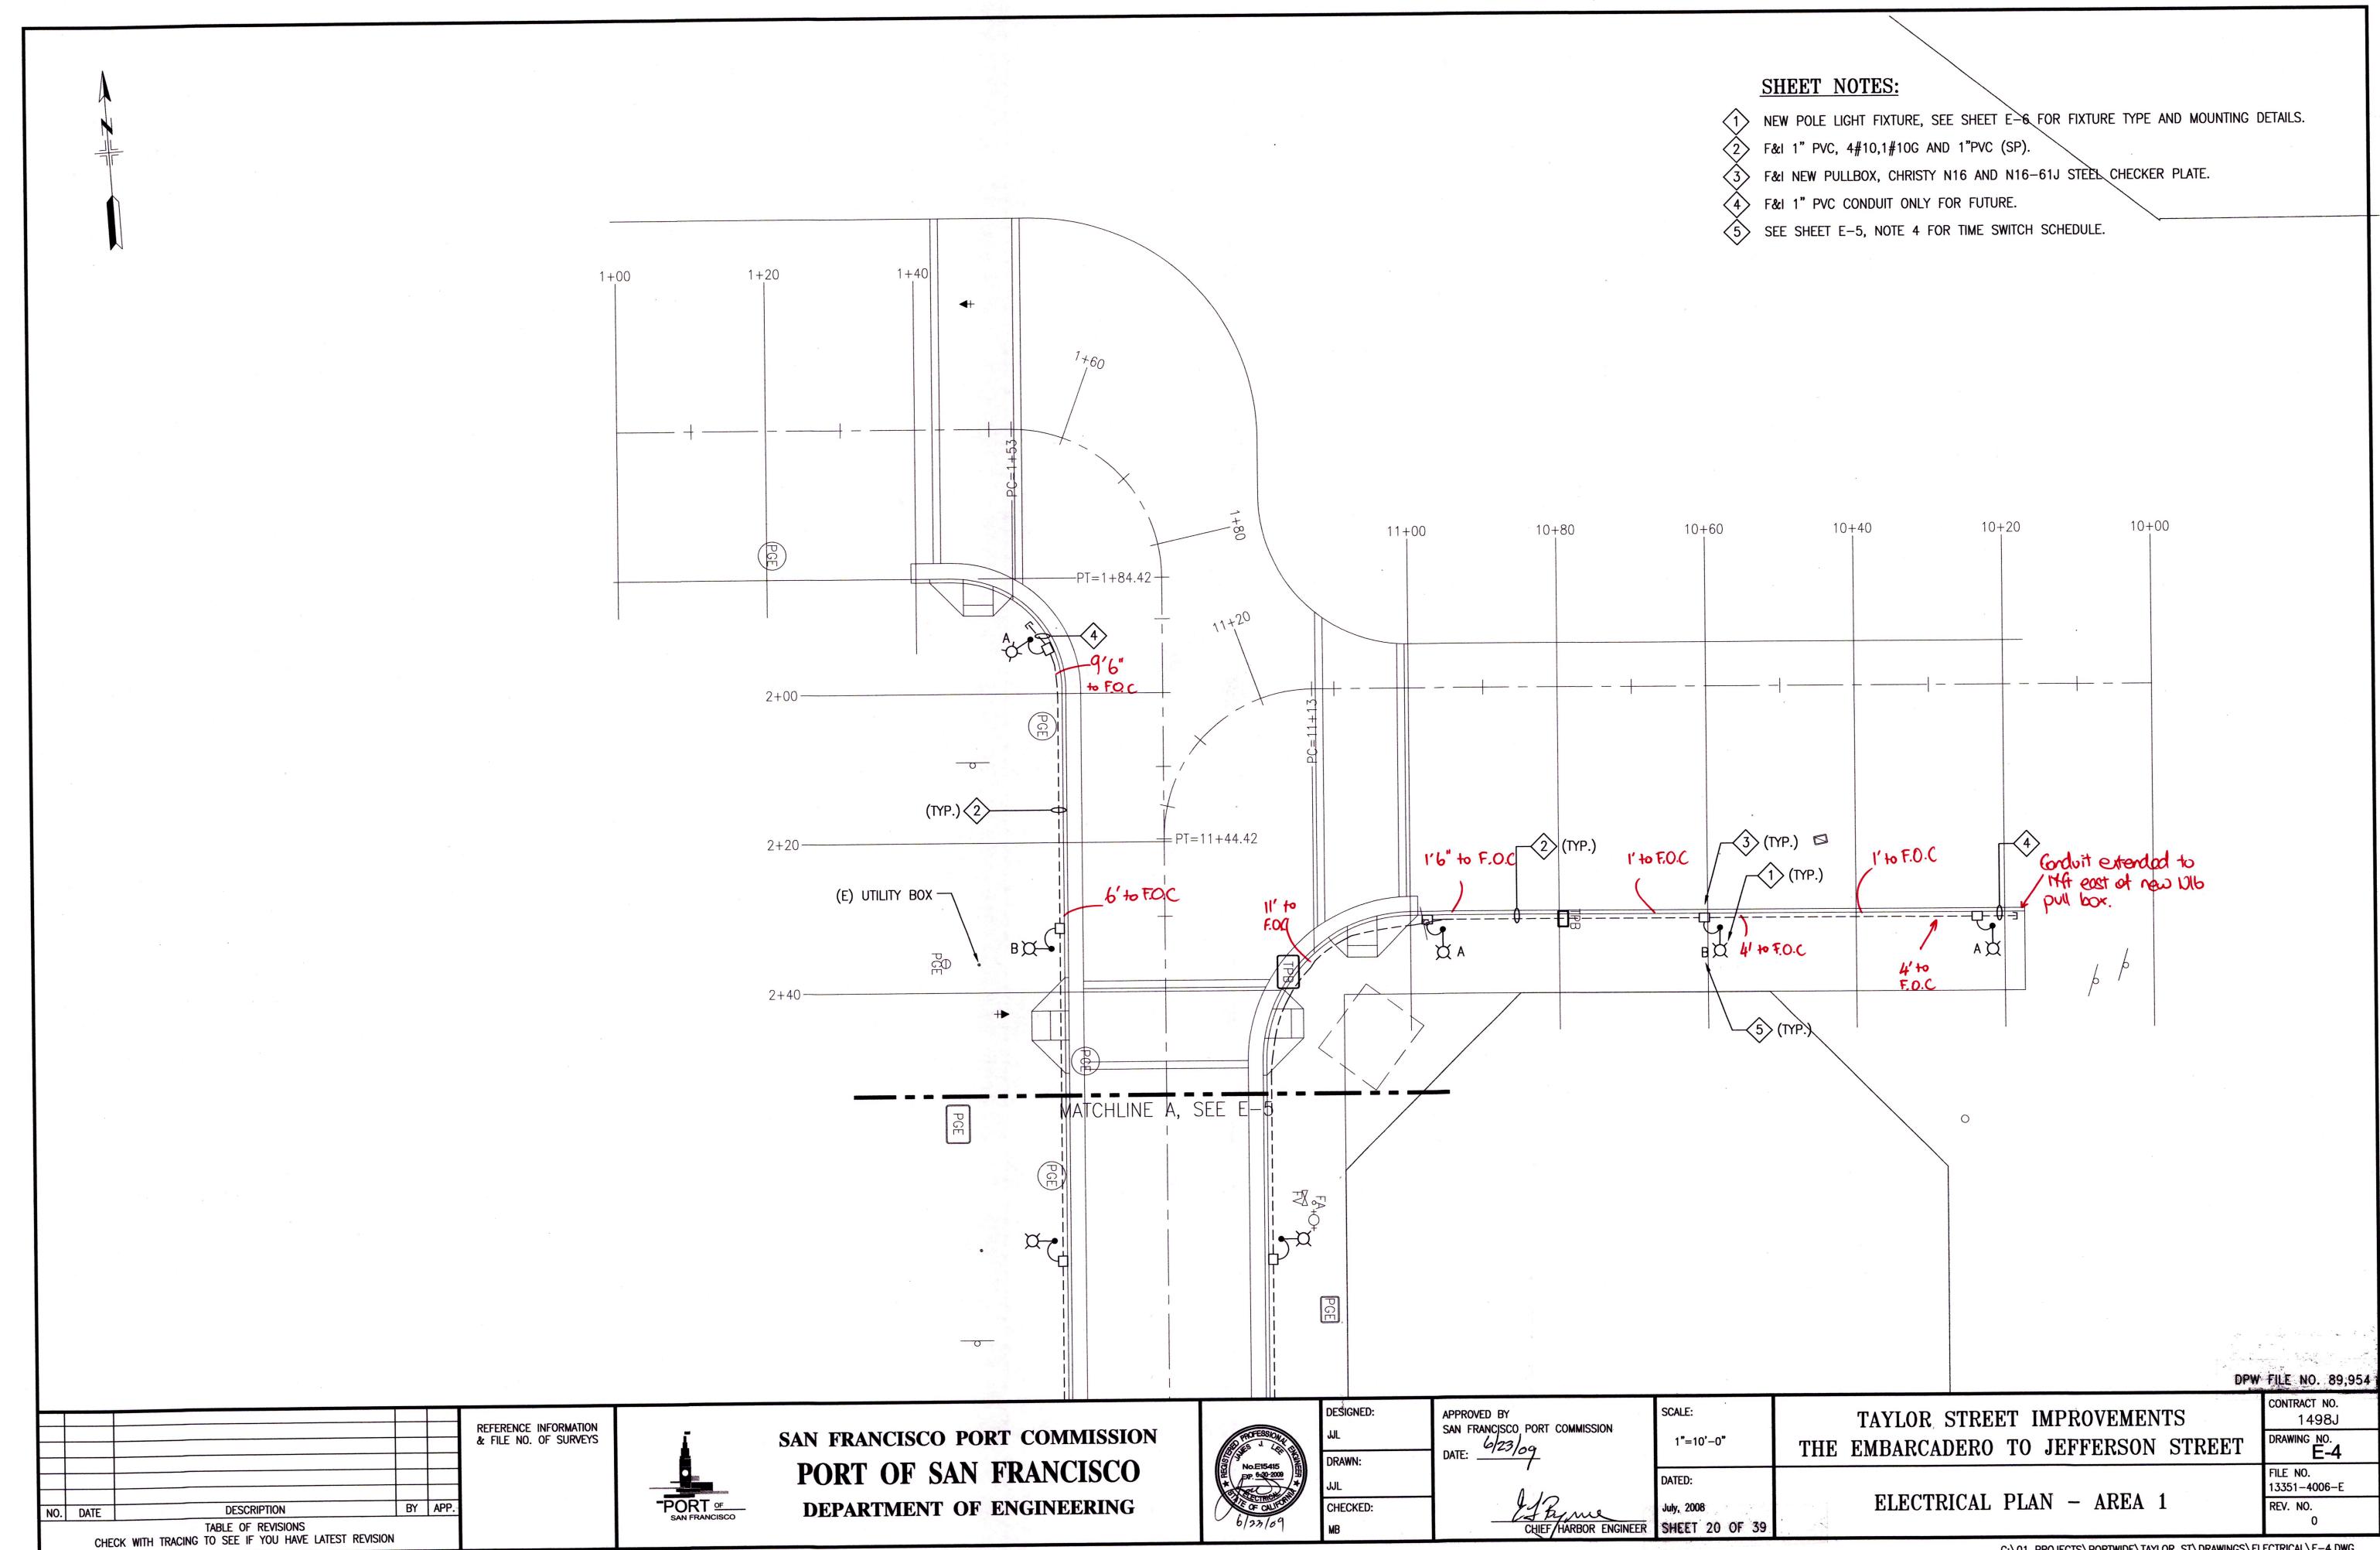

PLANS ARE TO BE RETURNED WITH CORRECTIONS MADE AND CERTIFIED TO IN RED INK AND DATED BY THE INSPECTOR IN CHARGE UPON COMPLETION OF THE WORK BEFORE FINAL PAYMENT ON BE MADE.

SIGNED-INSPECTOR


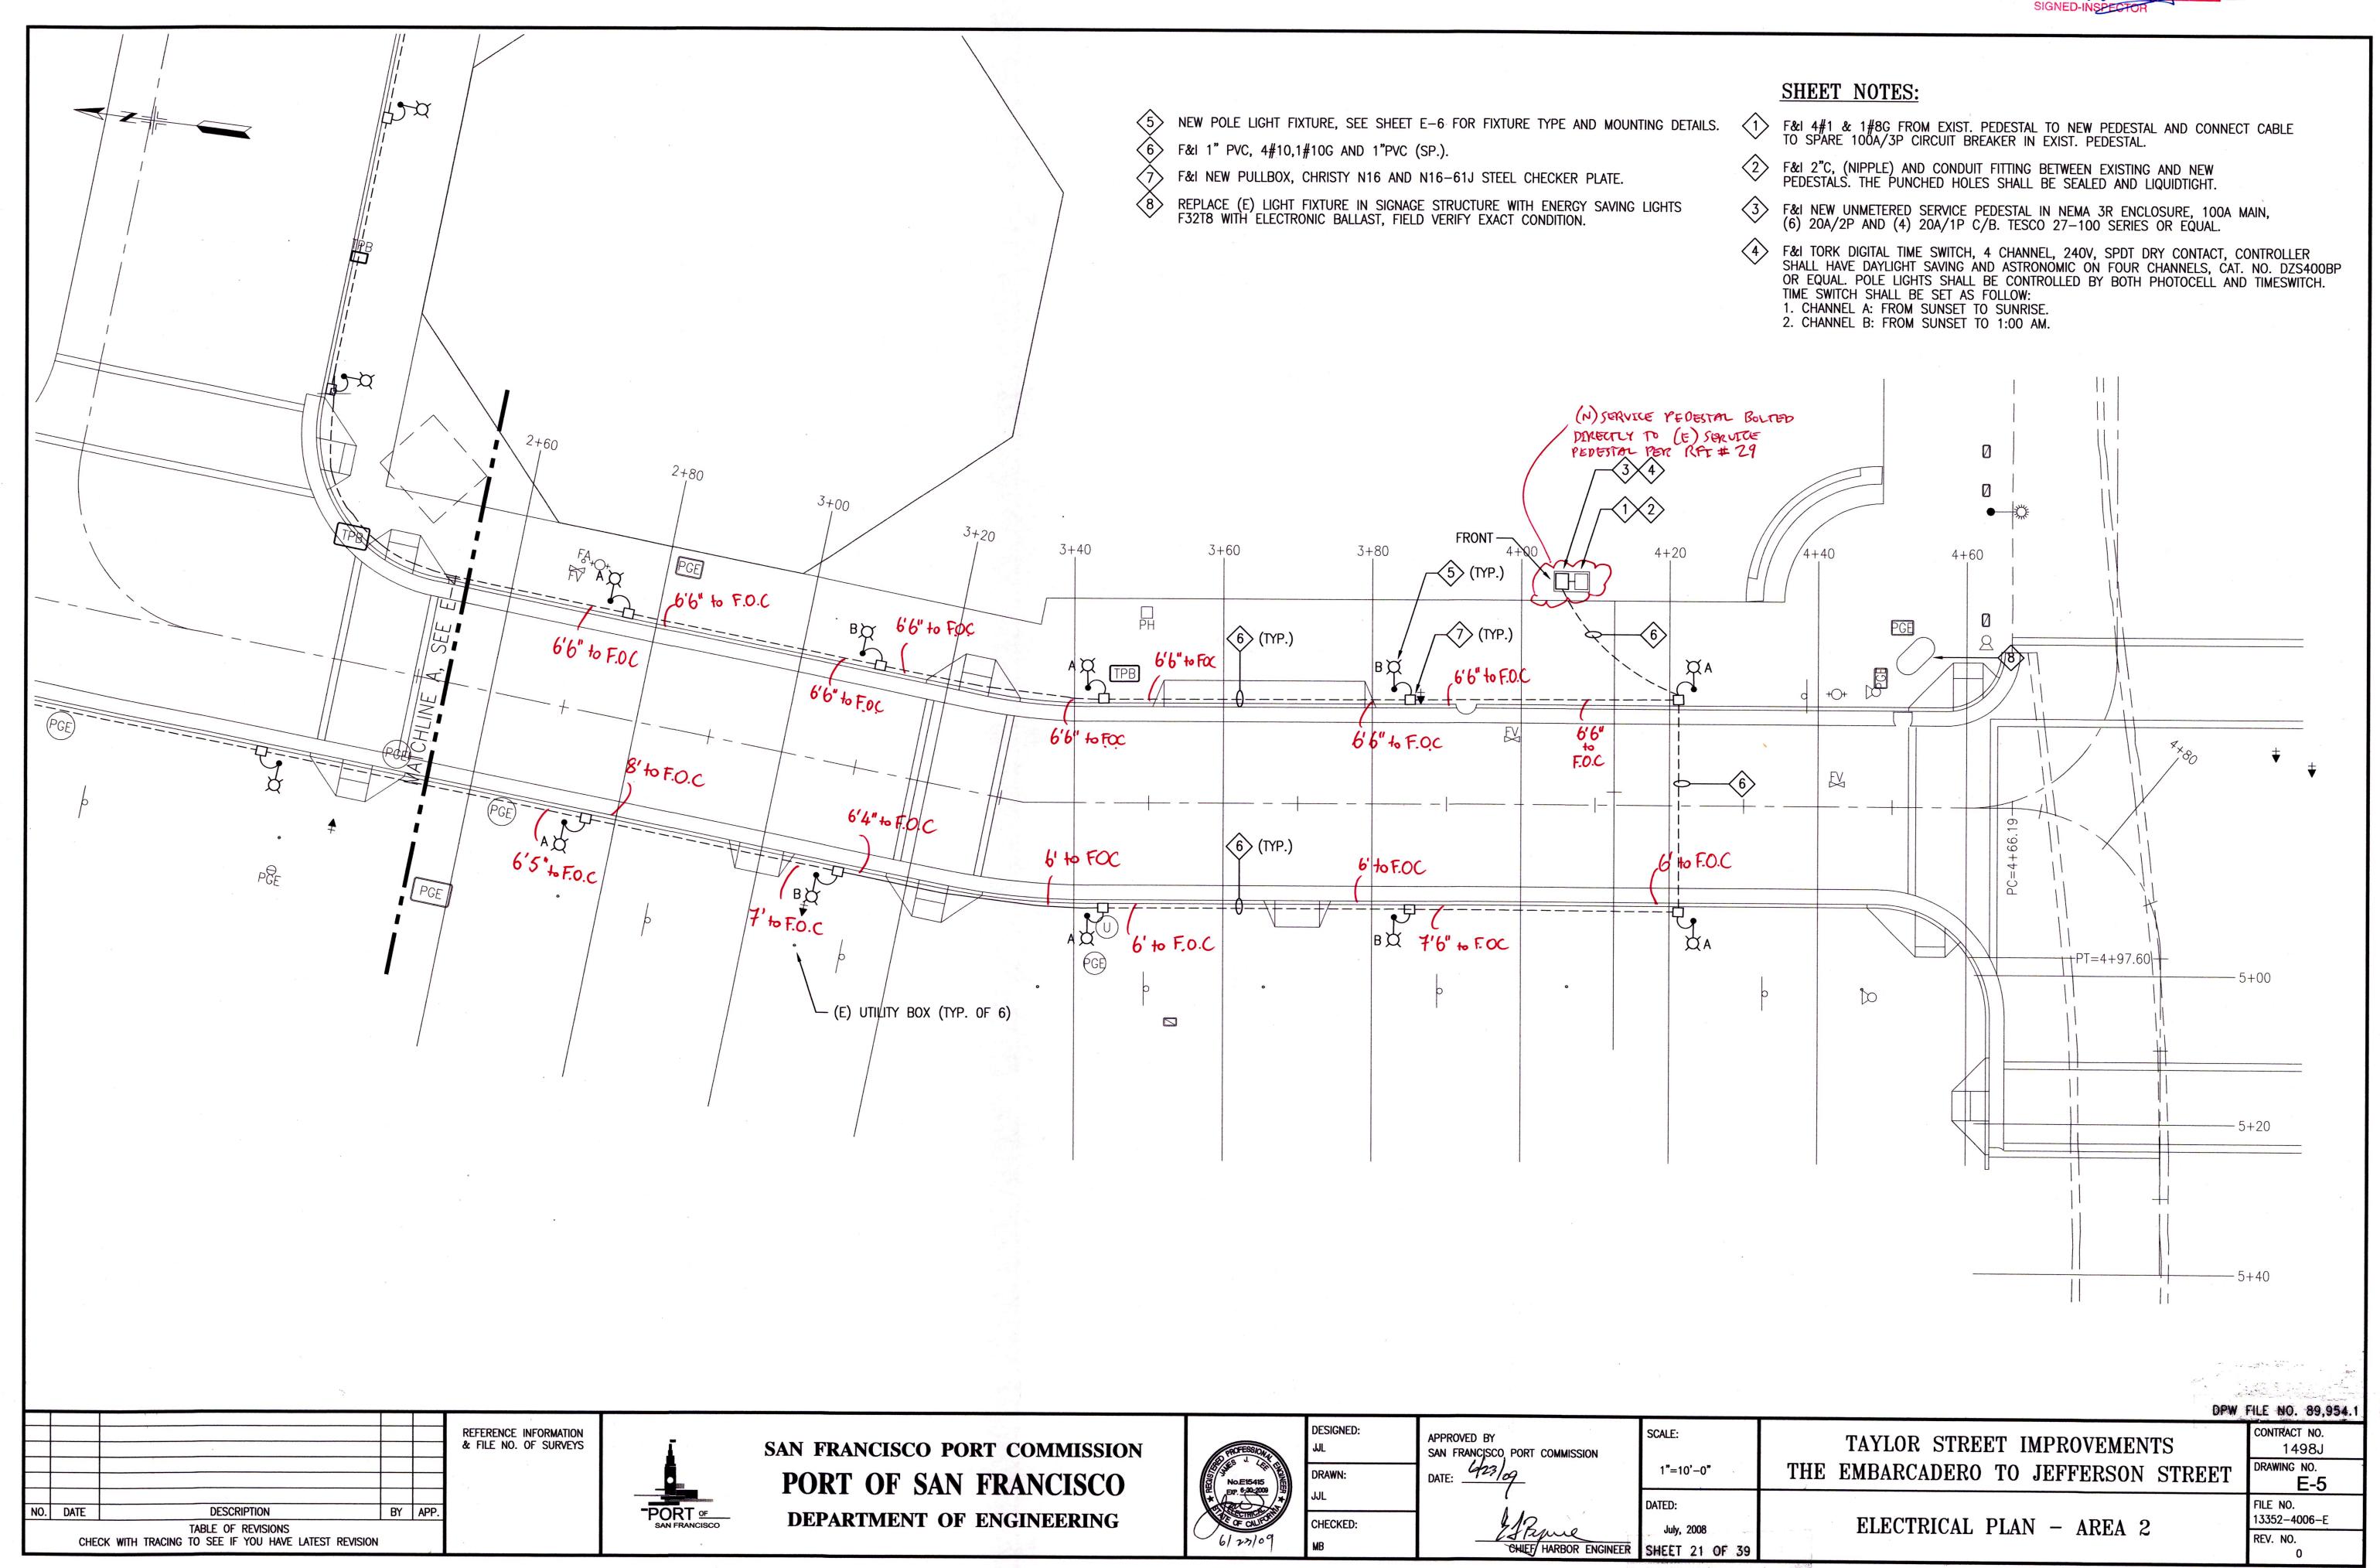


TABLE OF REVISIONS CHECK WITH TRACING TO SEE IF YOU HAVE LATEST REVISION


PLANS ARE TO BE RETURNED WITH DORRECTIONS MADE AND CERTIFIED TO IN RED INK AND DATED BY THE INSPECTOR IN CHARGE UPON COMPLETION OF THE WORK BEFORE FINAL PAYMENT PAN BE MADE. Synand Nory SIGNED-INSPECTOR 1

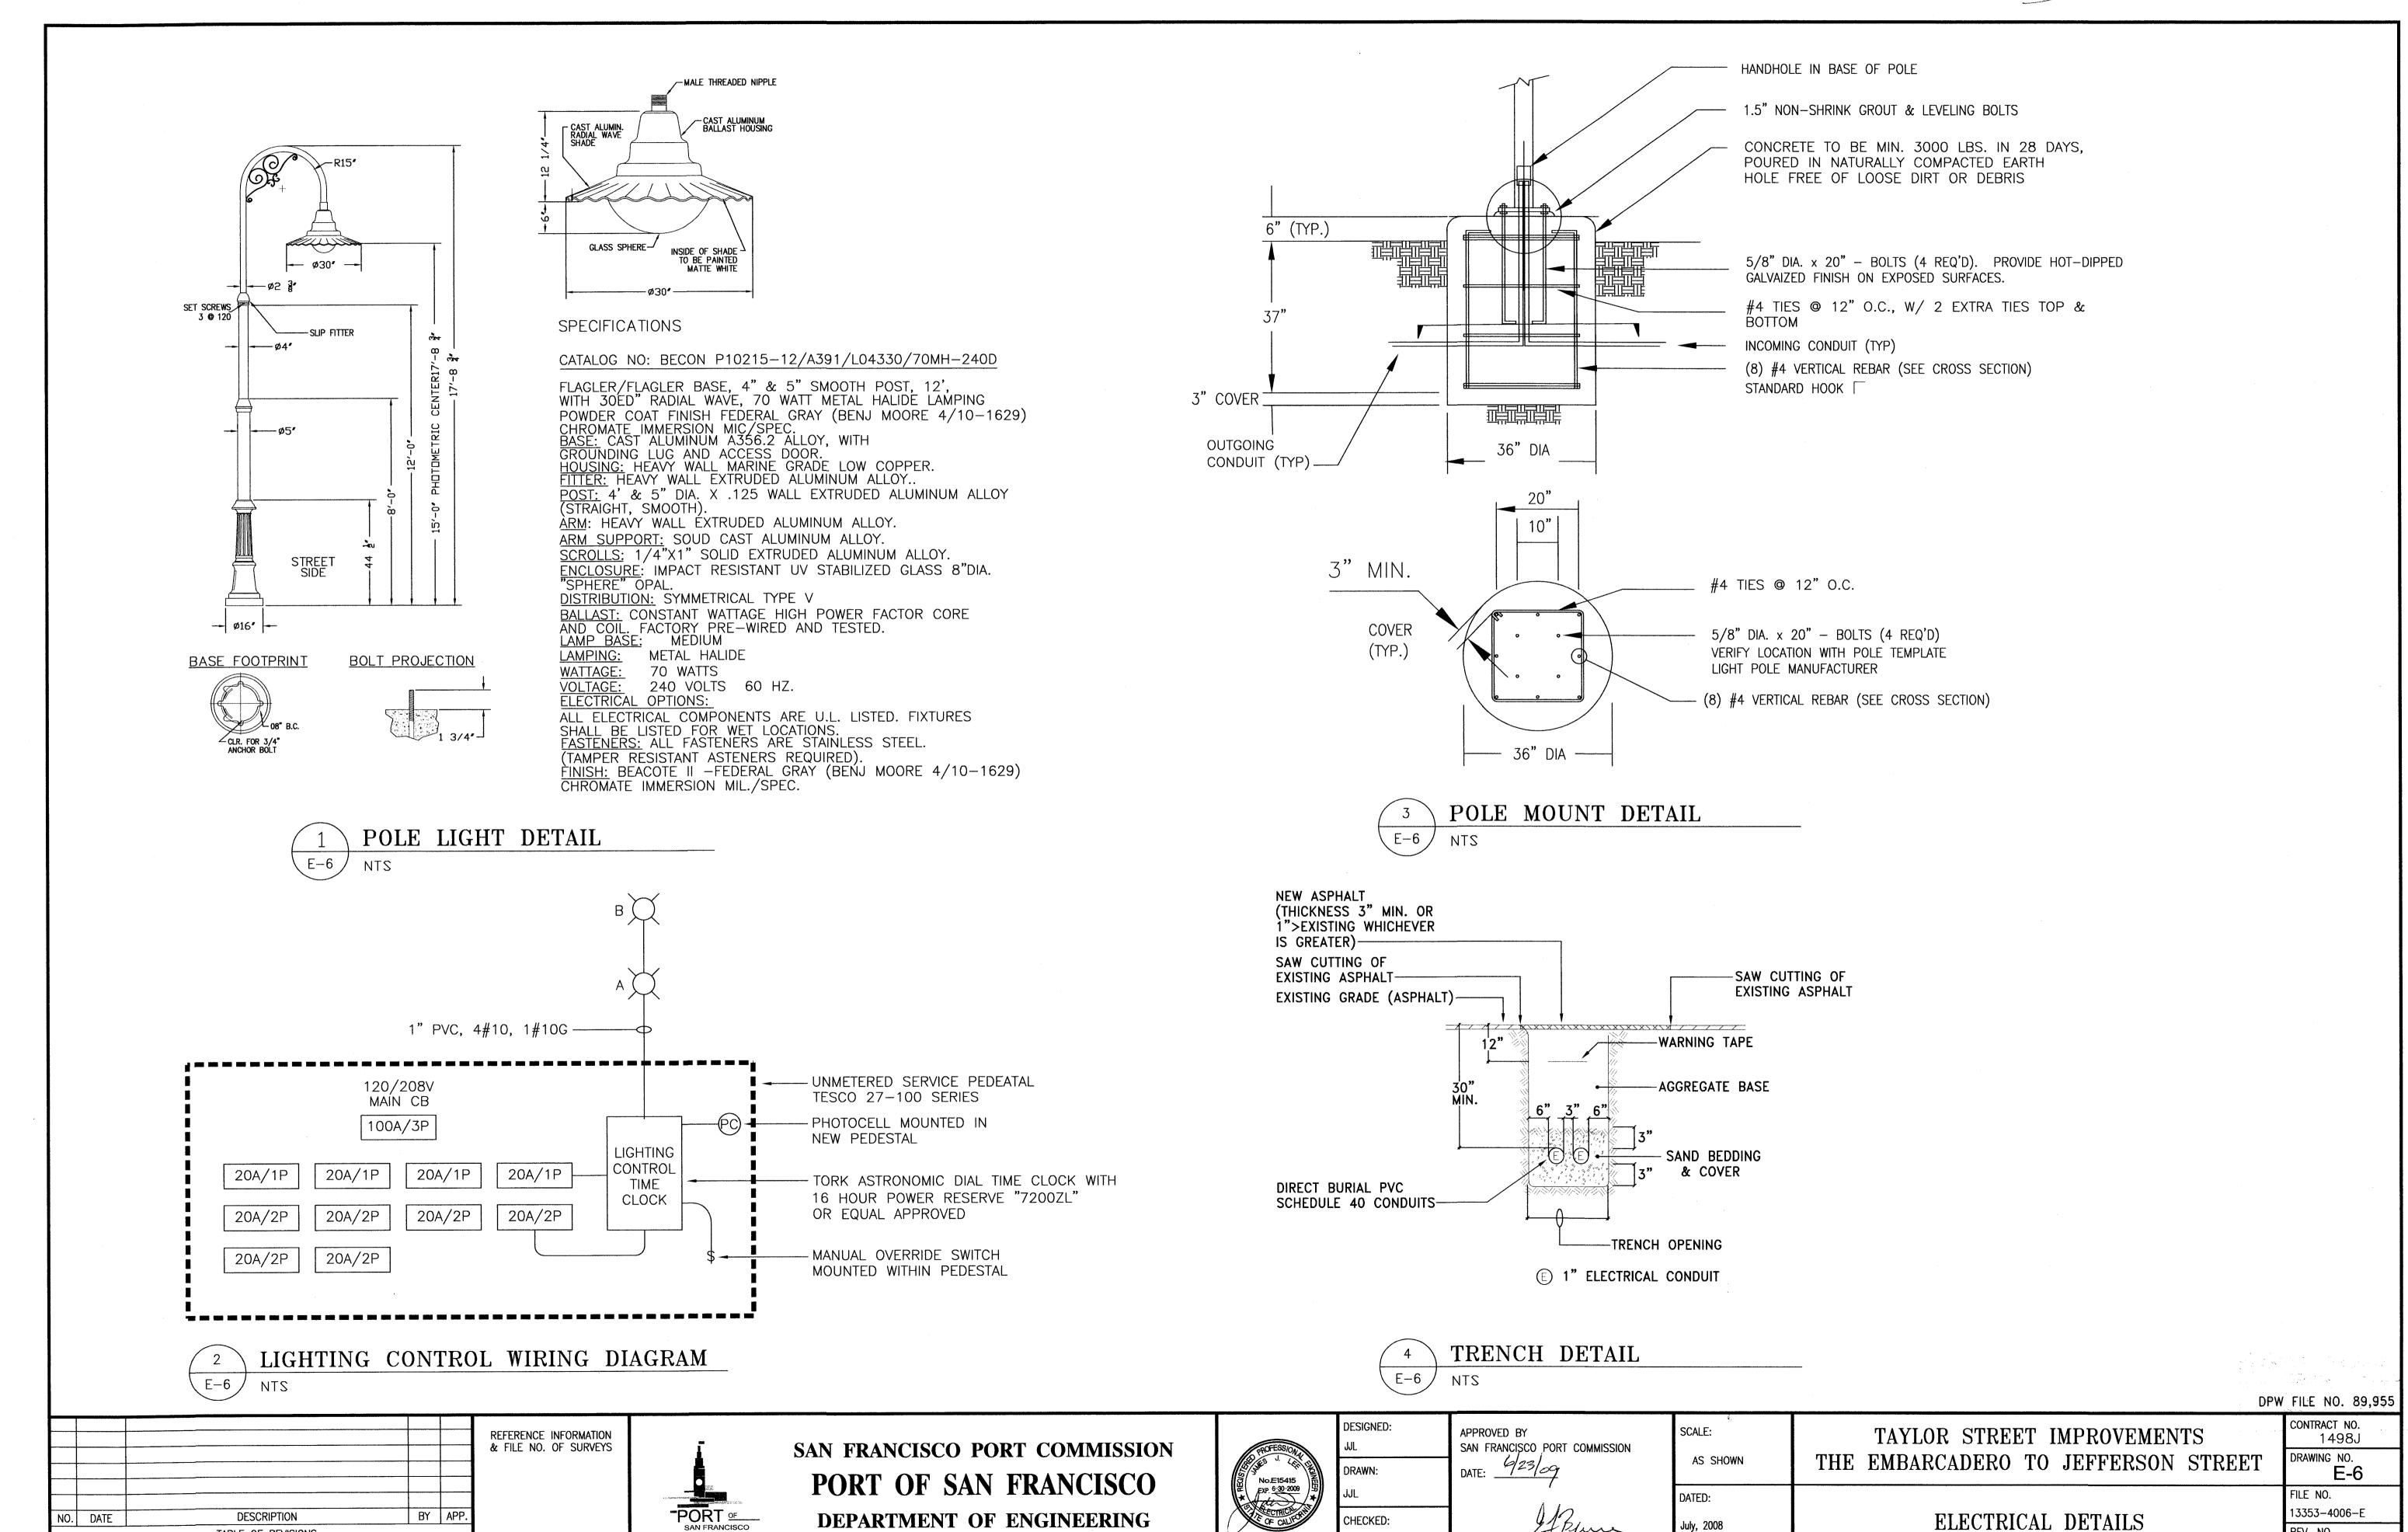


CHIEF/ HARBOR ENGINEER

SHEET 22 OF 39


REV. NO.

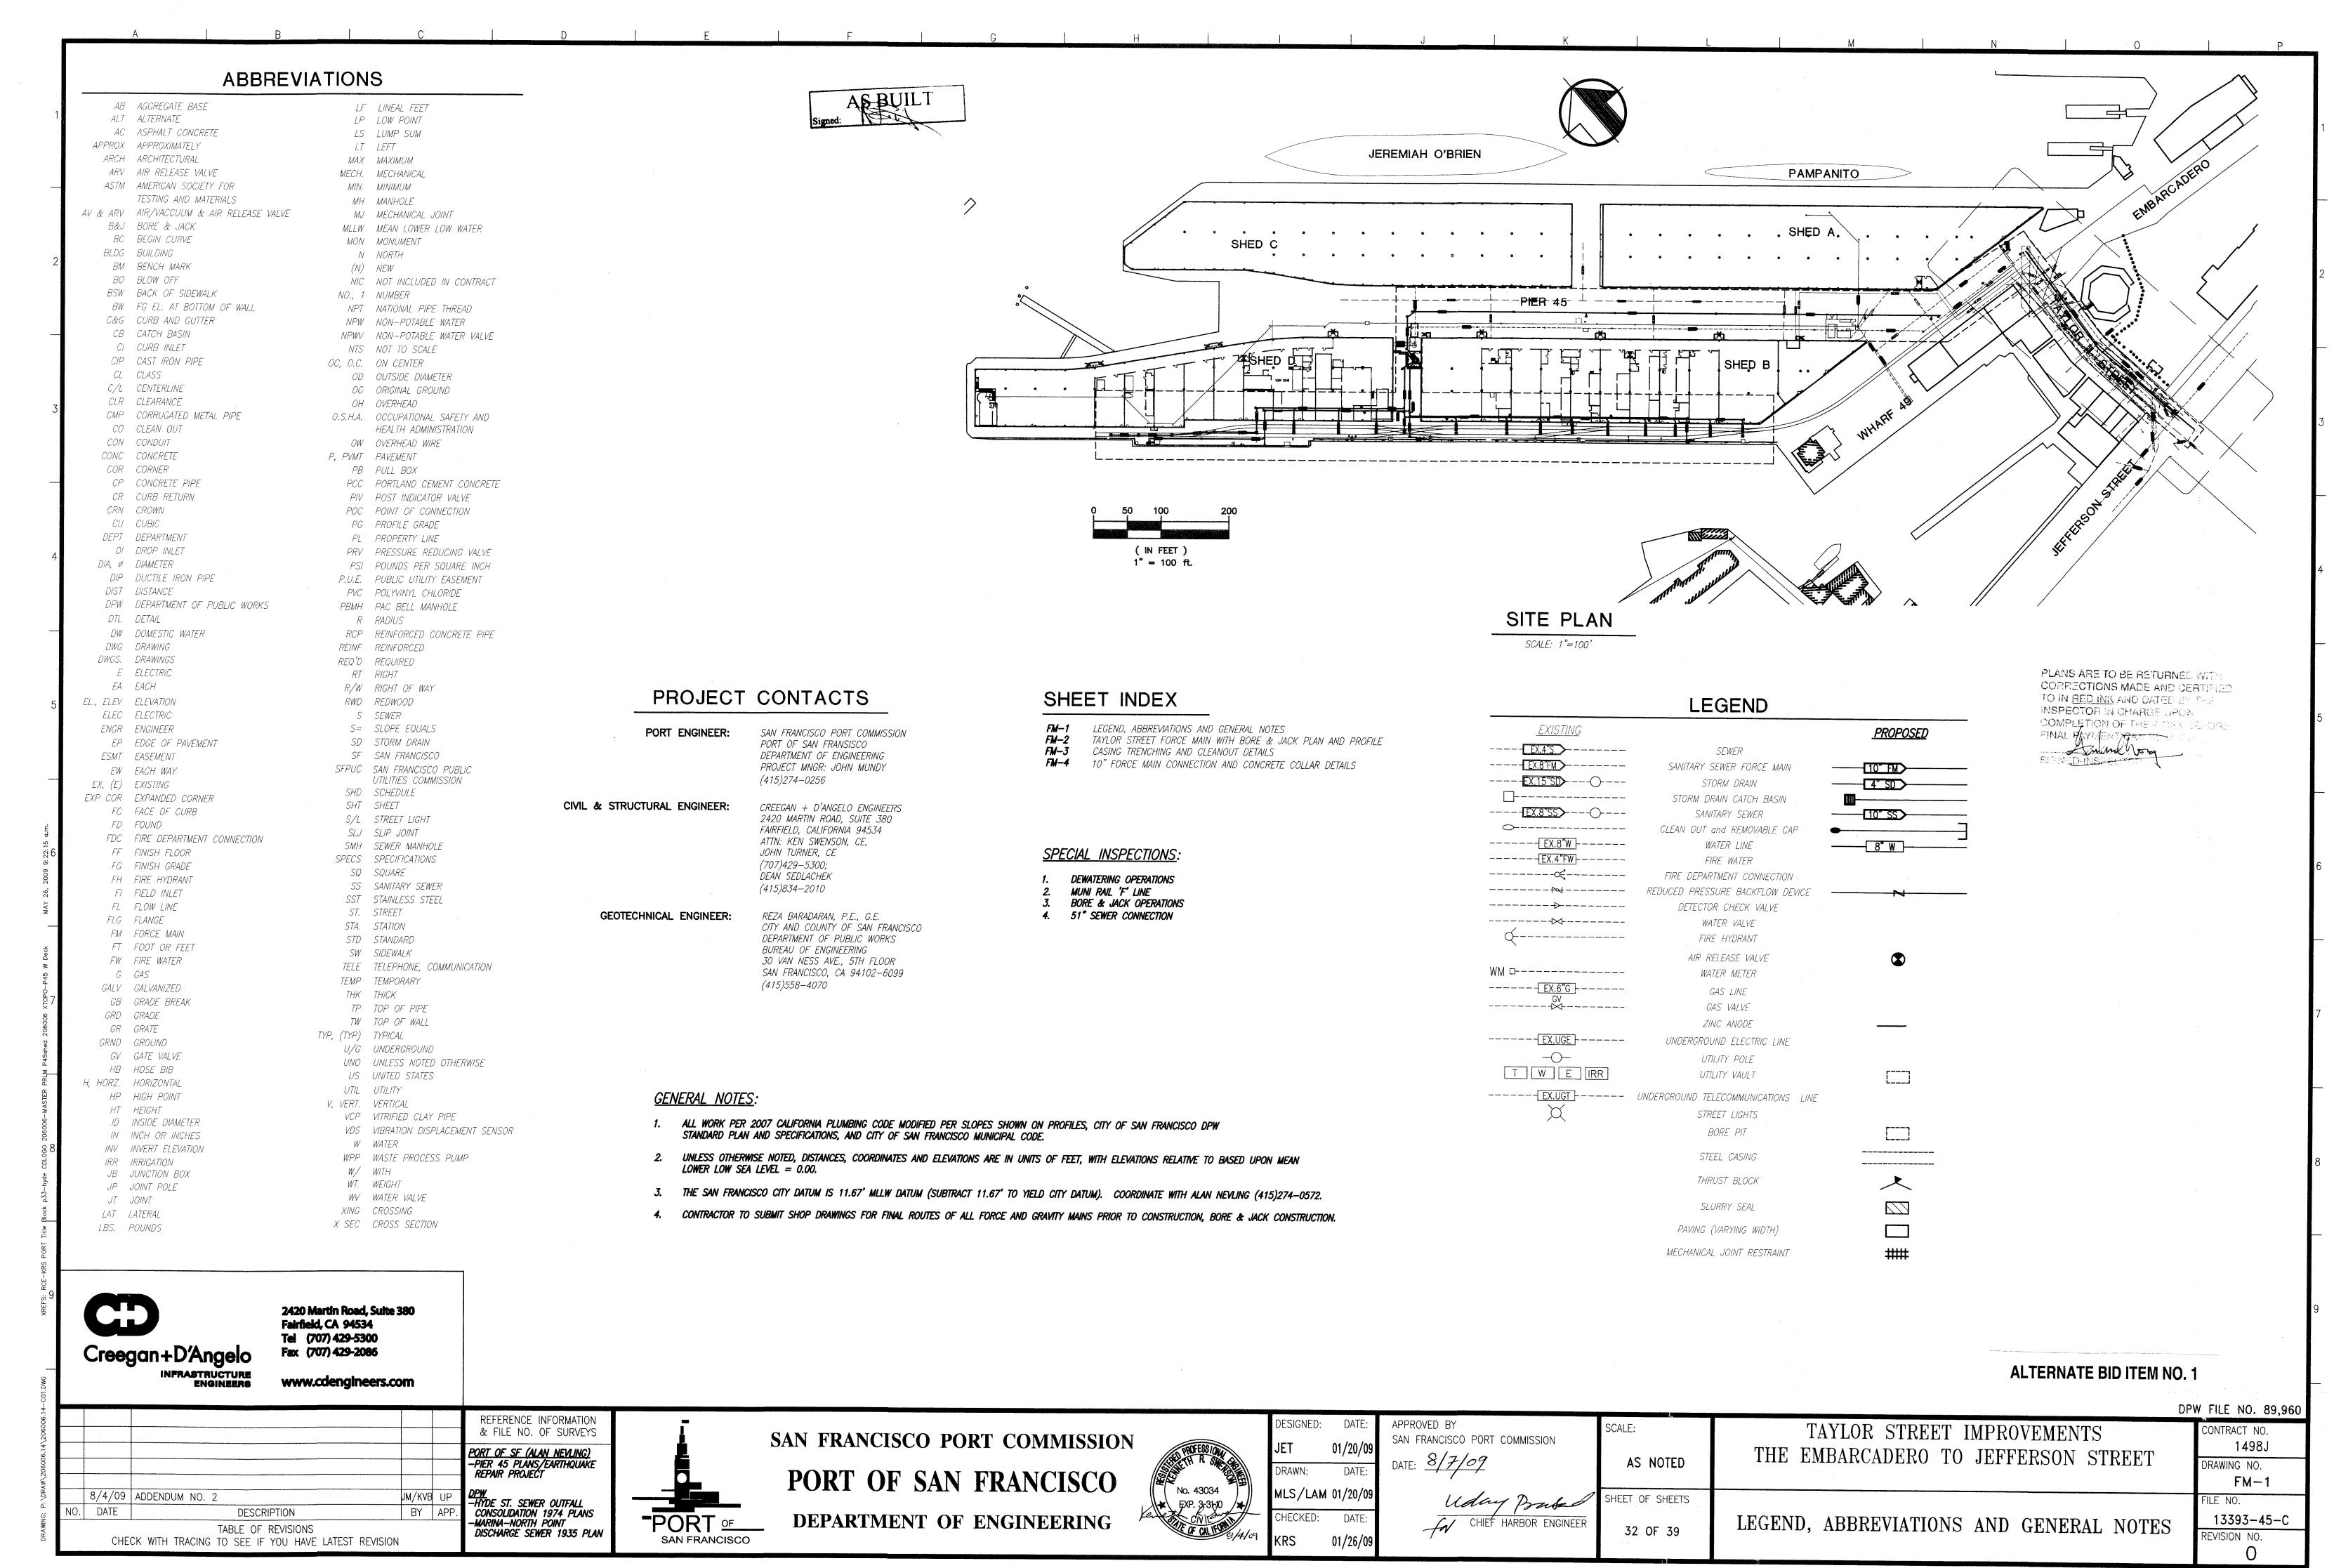


G:\07 STAFF\SCHU\Pier45forJM\CivilExtracted

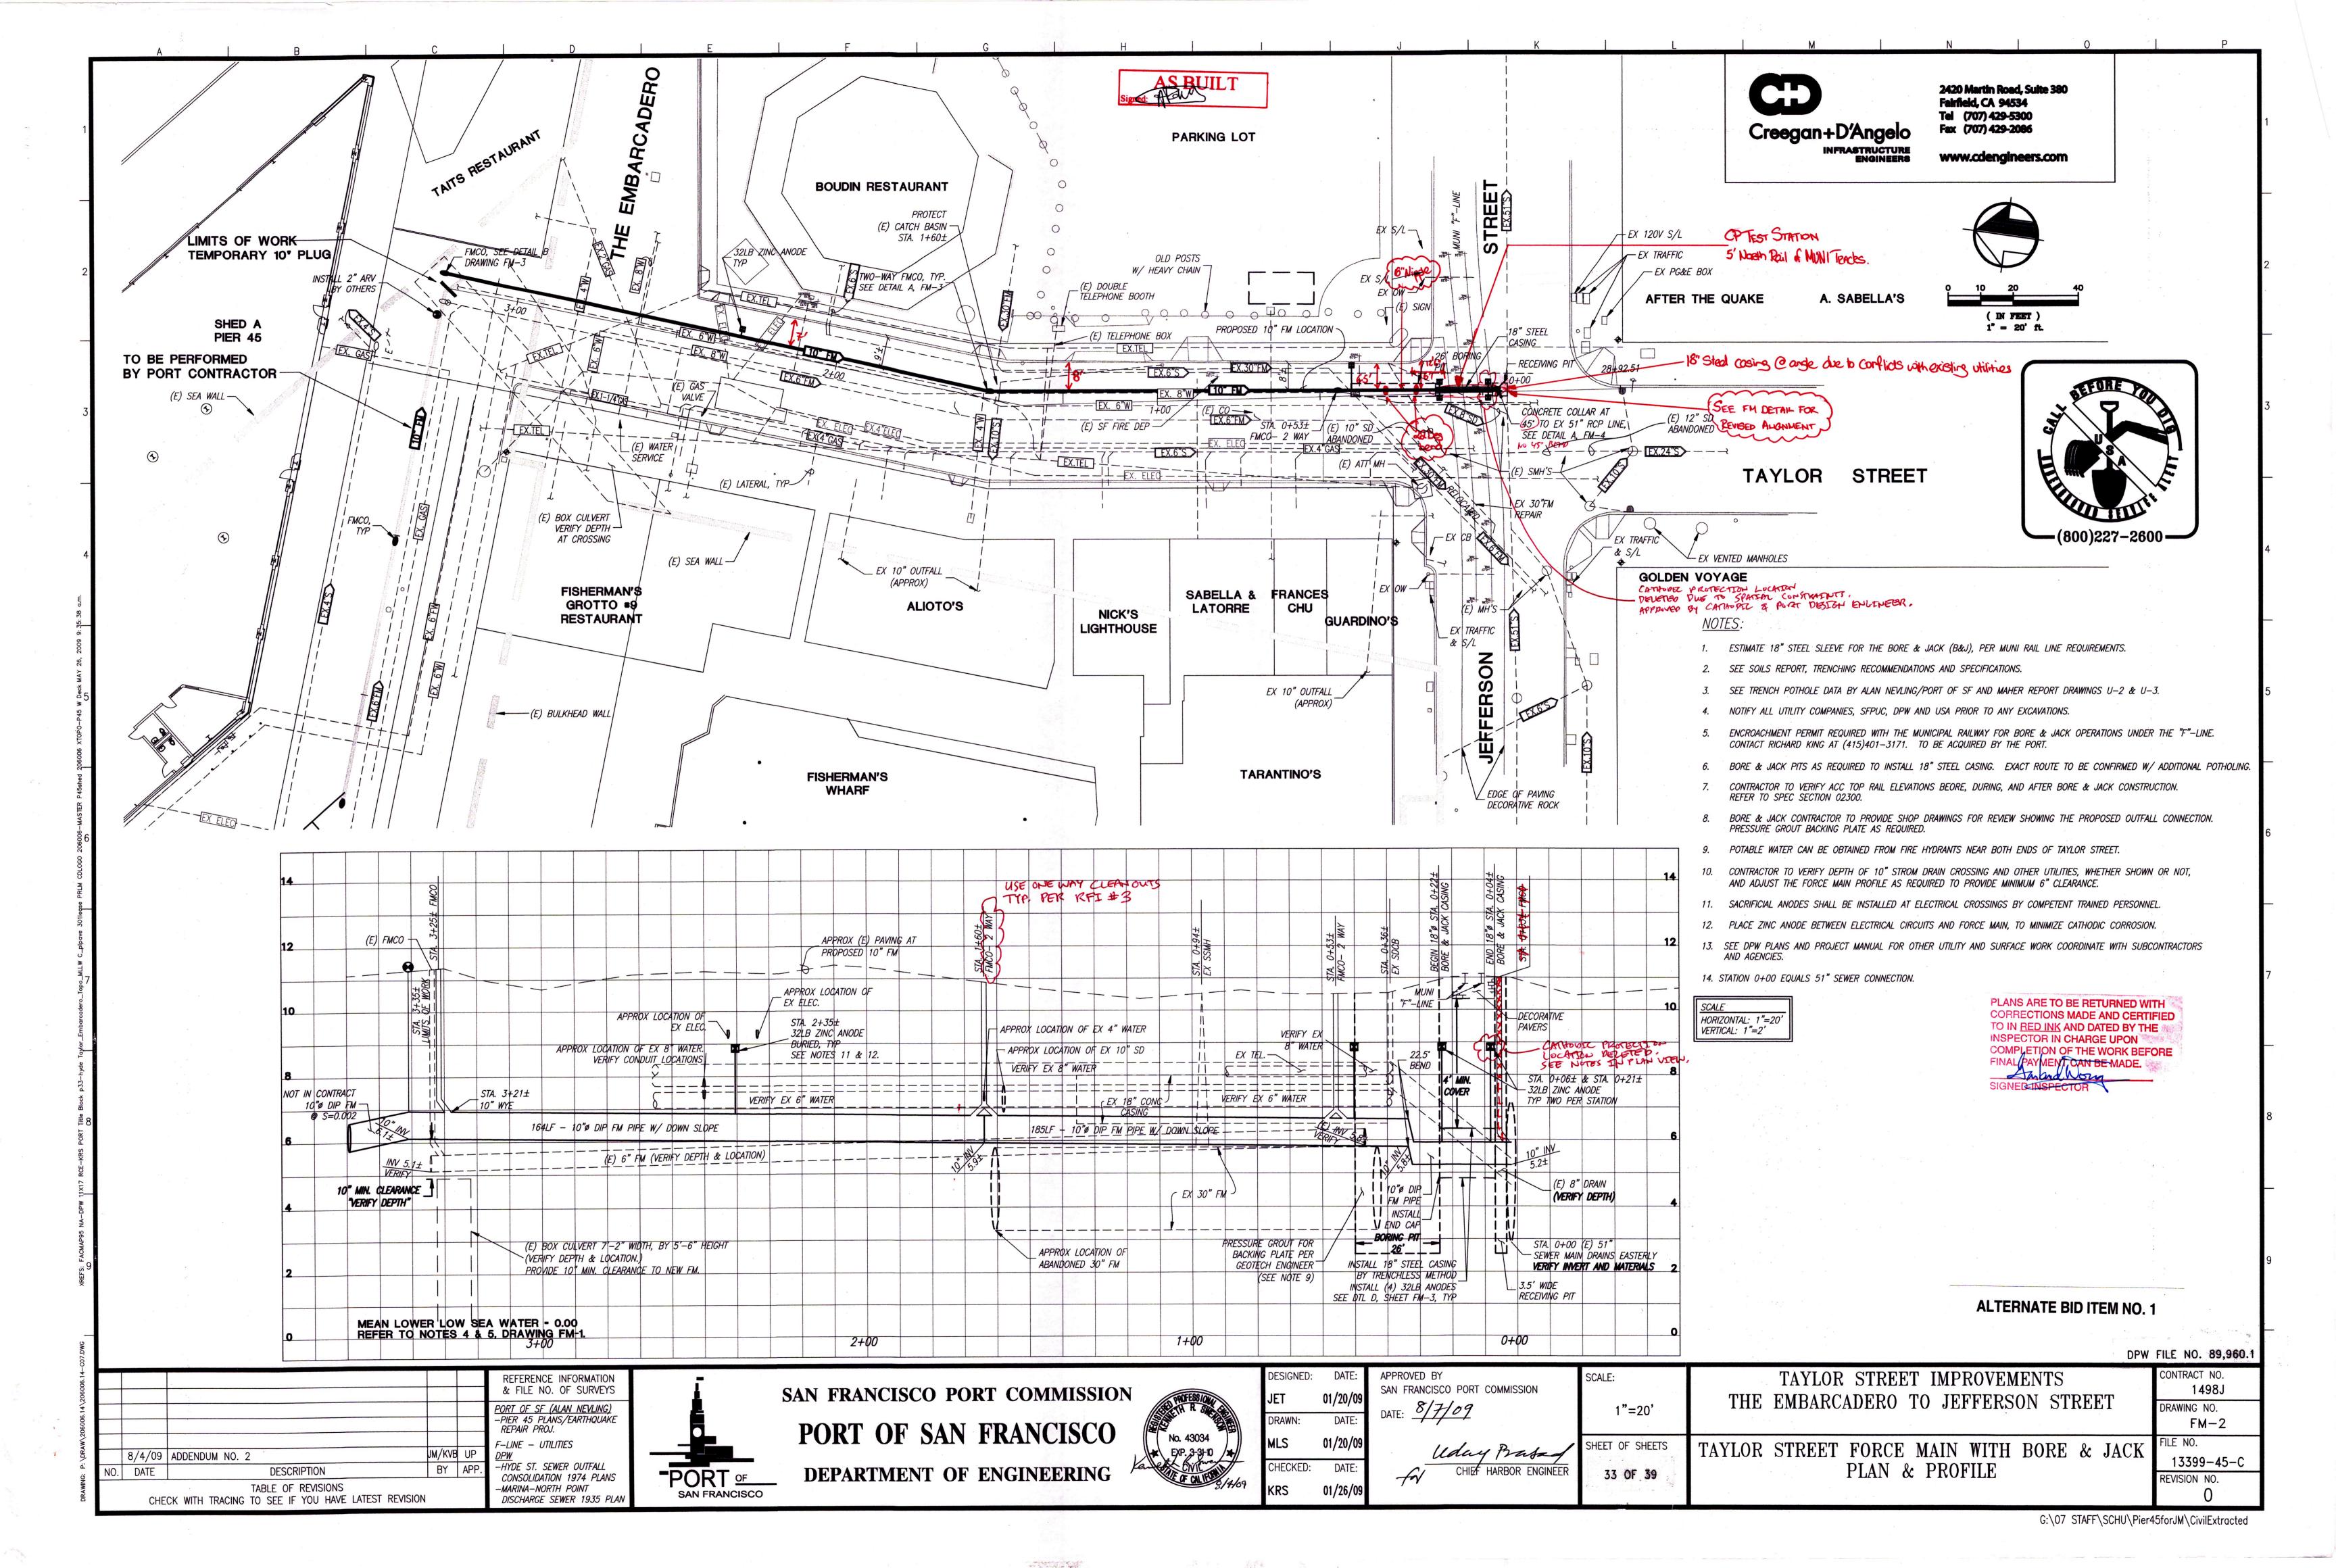


PLANS ARE TO BE RETURNED WITH COPRECTIONS MADE AND CERTIFIED TO IN RED INK AND DATED BY THE INSPECTOR IN CHARGE UPON COMPLETION OF THE WORK BEFORE FINAL PRYMENT DAN BE MADE. - Salandhong SIGNED-INSPECTION I

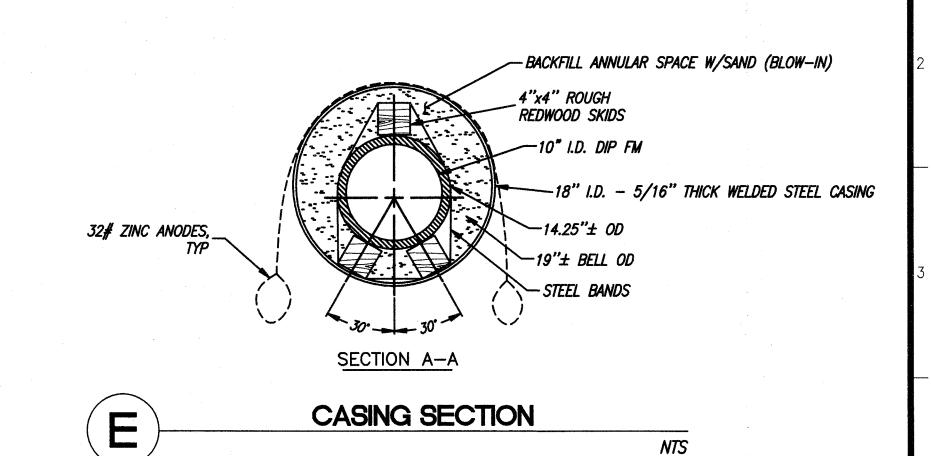


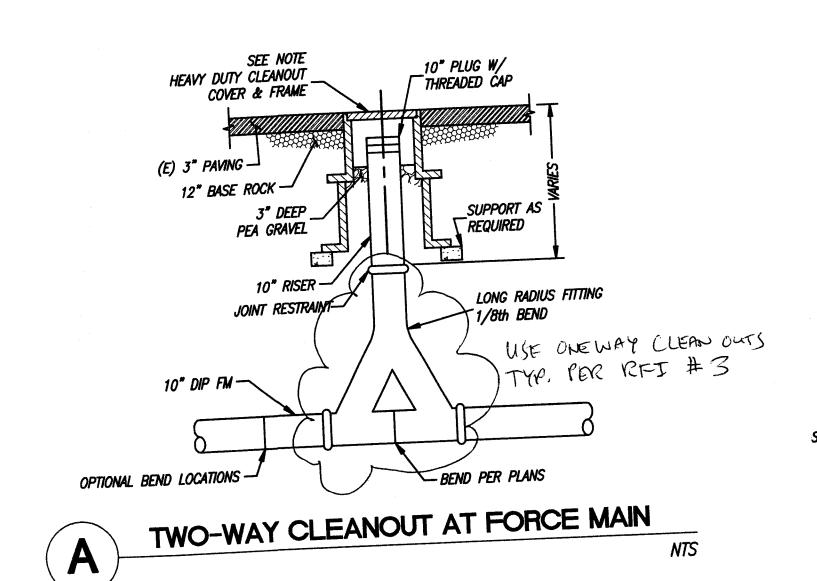


2420 Martin Road, Suite 380 Fairfield, CA 94534 Tel (707) 429-5300 Fax (707) 429-2086

BY APP

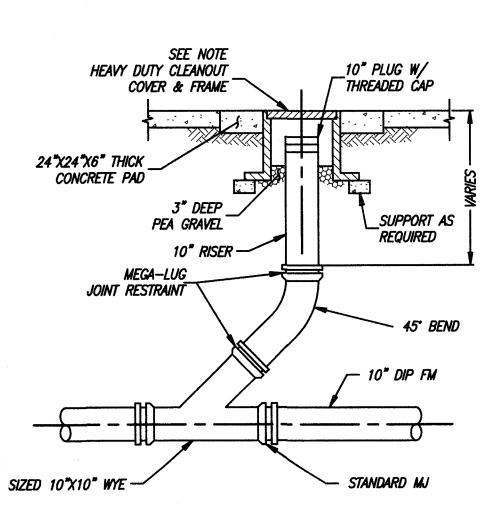

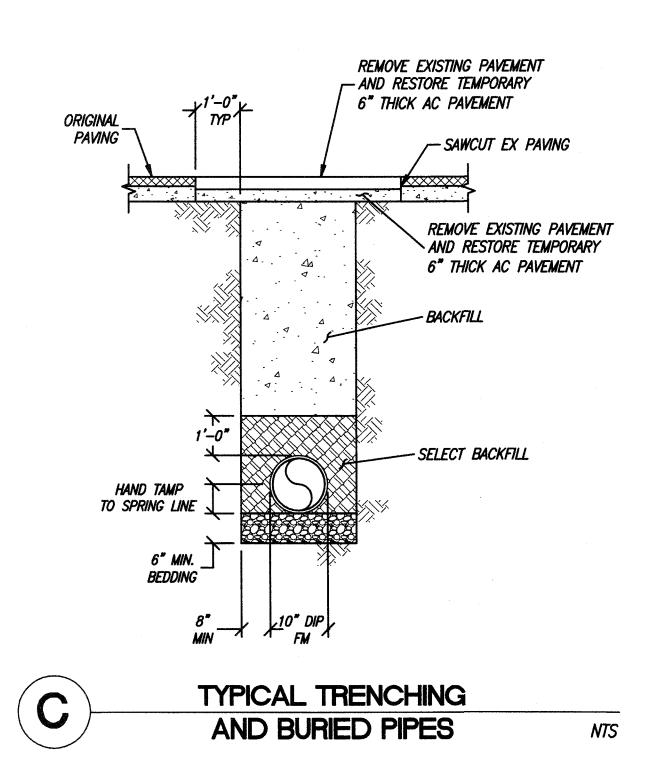

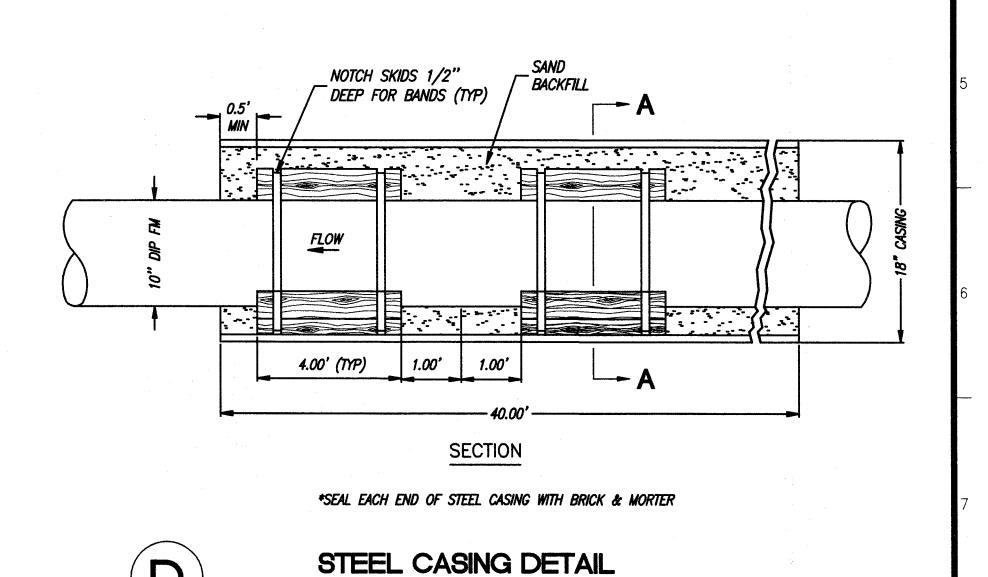

UNDER MUNI RAILWAY

ITRACTOR SHALL CONSTRUCT NEW COVERS AND FRAMES TO FINISHED GRADE AND TALL TEMPORARY GRADE RINGS AS NEEDED TO CONFORM TO EXISTING GRADE.

DE RINGS SHALL BE REMOVED DURING ROADWAY CONSTRUCTION.

CLEAN OUT AT 10' FORCE MAIN

ALTERNATE BID ITEM NO. 1


TAYLOR STREET IMPROVEMENTS CONTRACT NO. 1498J DRAWING NO. FM-3FILE NO. 13404-45-C REVISION NO.

NTS

Creegan+D'Angelo
INFRASTRUCTURE
ENGINEERS www.cdengineers.com 8/4/09 ADDENDUM NO. 2 DESCRIPTION NO. DATE TABLE OF REVISIONS
CHECK WITH TRACING TO SEE IF YOU HAVE LATEST REVISION

REFERENCE INFORMATION & FILE NO. OF SURVEYS PORT OF SF (ALAN NEVLING) -PIER 45 PLANS/EARTHQUAKE REPAIR PROJ.




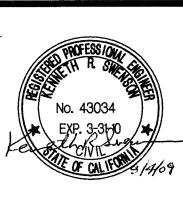

DESIGNED:	DATE:
JET	01/20/09
DRAWN:	DATE:
MLS	01/20/09
 MLS CHECKED:	01/20/09 DATE:

APPROVED BY SAN FRANCISCO PORT COMMISSION
DATE: 8/7/09
Walay Batal Col CHIEF HARBOR ENGINEER
AN CHIEF MARBOR ENGINEER


DPW FILE NO. 89,960.2

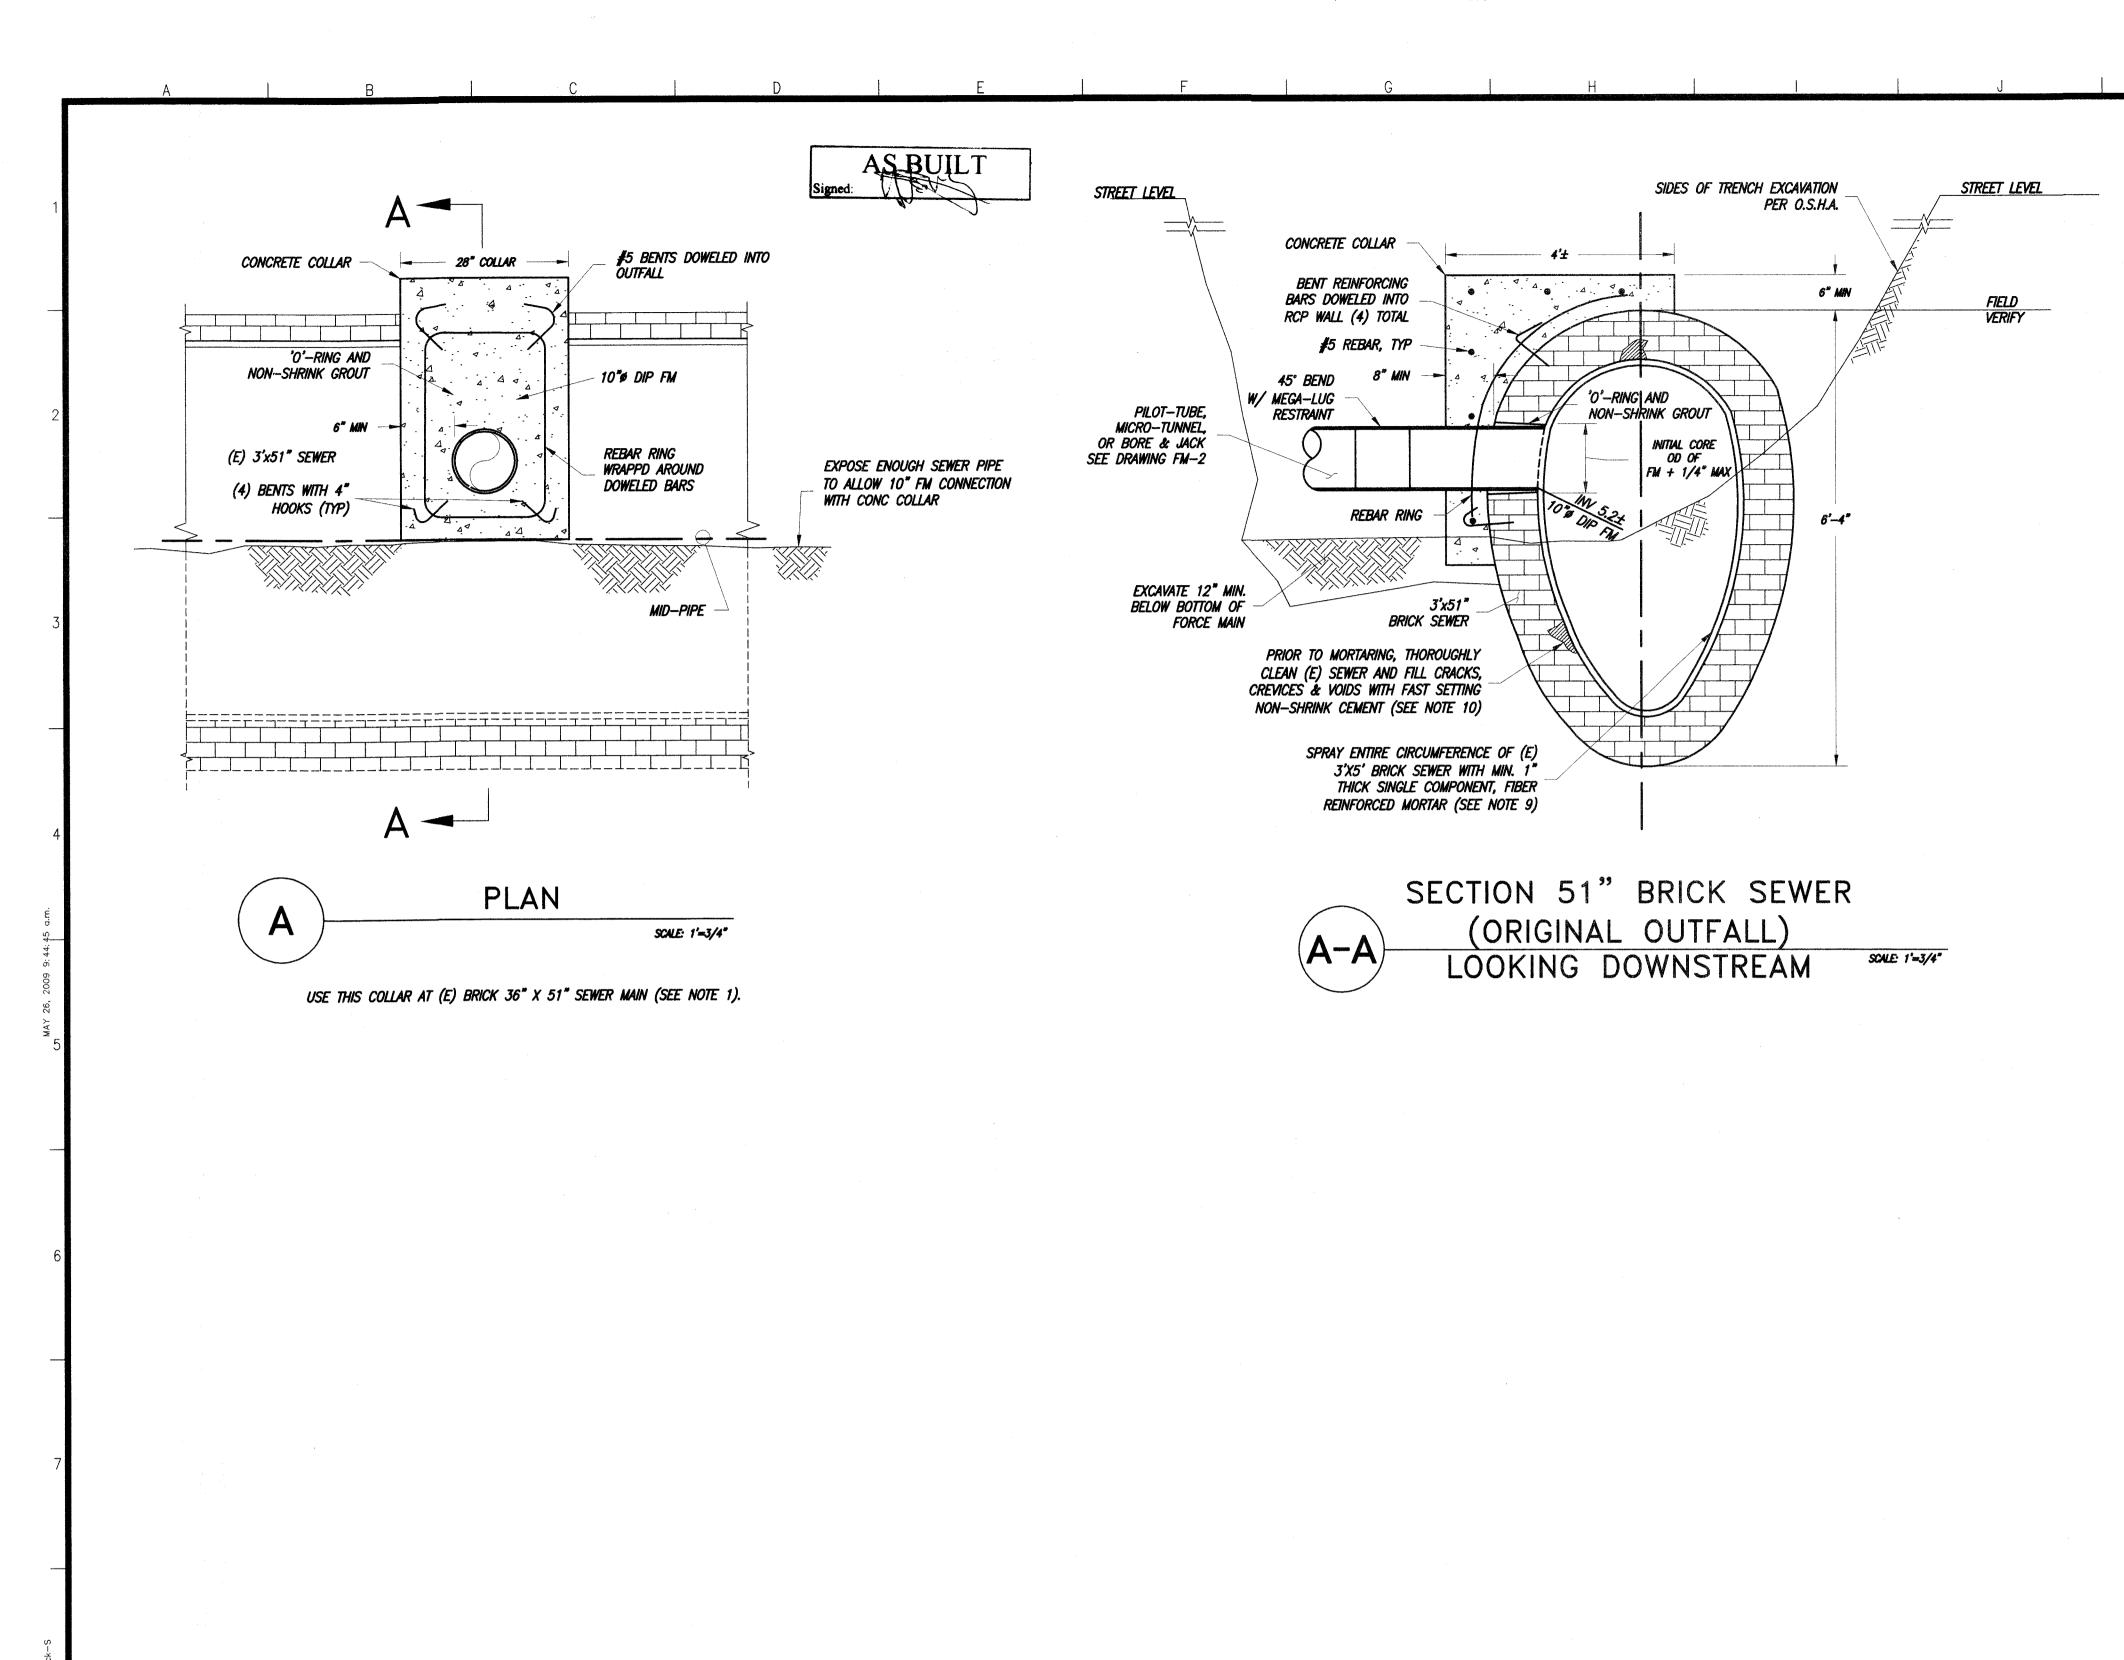


2420 Martin Road, Suite 380

Fairfield, CA 94534 Tel (707) 429-5300 Fax (707) 429-2086

Creegan+D'Angelo

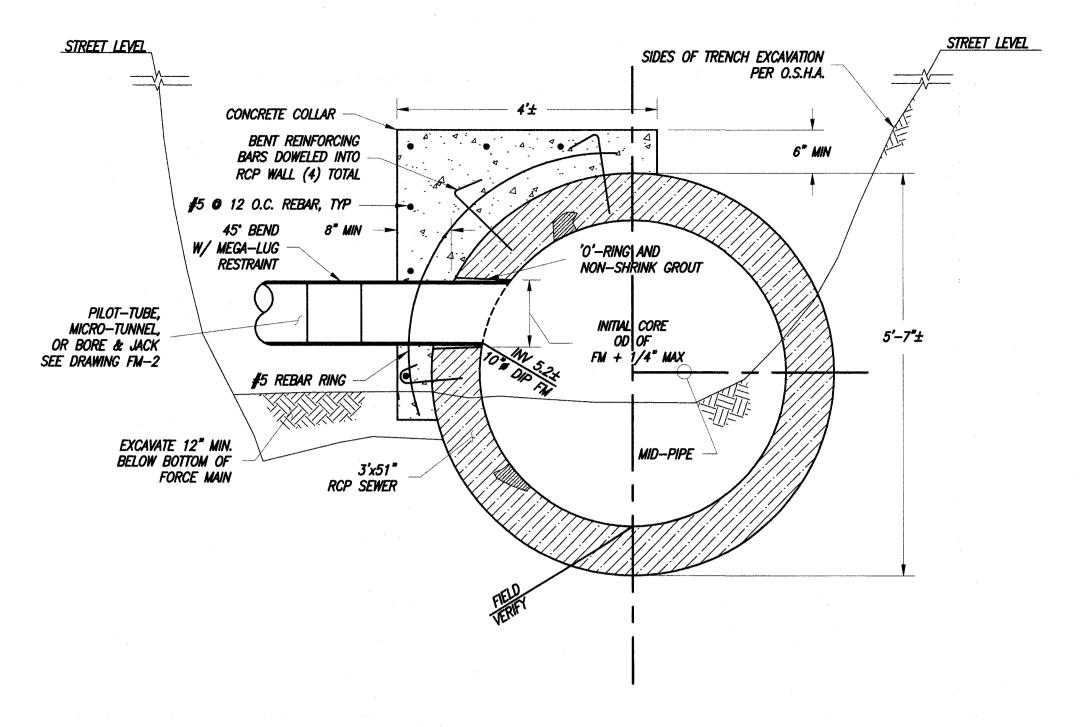

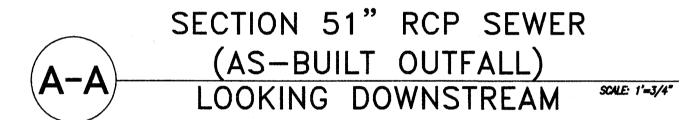

USE THIS COLLAR IF RCP ENCOUNTERED AT OUTFALL CONNECTION.

PLANS ARE TO BE RETURNED WITH COMMECTIONS MADE AND CERTIFIED TO IN RED INK AND DATED BY THE INSPECTOR IN CHARGE UPON COMPLETION OF THE WORK BEFORE FINAL PAYMENT CAN BE MADE.


SIGNED-INSPECTOR

<u>NOTE:</u>

- 1. (2) RECORD DRAWINGS SHOW 51" RCP AT WHARF RESTAURANTS, OLDER DRAWINGS INDICATE BRICK SEWER. CONTRACTOR TO VERIFY MATERIALS, AND ENTER OUTFALL ABOVE MID-PIPE.
- 2. CORE DRILL INTO THE (E) BRICK (OR CONCRETE PIPE) TO 1/4" OVER THE OUTSIDE DIAMETER OF THE NEW 10" FORCE MAIN.
- 3. DOWEL AND PLACE NON—SHRINK GROUT AND (4) BENT REINFORCING BARS INTO (E) BRICK OR 51" RCP SEWER.
- 4. WRAP REBAR INTO RING AROUND BENT BARS.
- 5. TRIM THE 10" FORCE MAIN TO CONFORM TO THE INTERIOR OF THE PIPE WHEN INSTALLED.
- 6. INSERT THE STUB INTO THE CORE ENSURING THAT NO PORTION OF THE 10" FORCE MAIN PROTRUDES PAST THE INSIDE OF THE PIPE, AND THAT THE 10" FORCE MAIN PROTRUDES A MINIMUM OF 2 1/2" FROM THE OUTSIDE OF THE PIPE.
- 7. INSTALL 'O'-RING AND NON-SHRINK GROUT AROUND PERIMETER OF 10" FORCE MAIN. KEEP INSIDE OF 51" BRICK SEWER CLEAR OF NON-SHRINK GROUT. ALLOW SUFFICIENT TIME FOR NON-SHRINK GROUT TO CURE PRIOR TO INSTALLATION OF CONCRETE COLLAR.
- 8. POUR CONCRETE COLLAR WITH 5-SACK 3,000 PSI CONCRETE.
- 9. CONTRACTOR TO SUBMIT BORE & JACK DETAILS AND SHOP DRAWINGS FOR REVIEW BY THE ENGINEER AND PORT OF SF PRIOR
- 10. SPRAY MORTAR, SHALL HAVE A MIN. COMPRESSIVE STRENGTH OF 6,000 PSI AT 7 DAYS.
- 11. NON-SHRINK CEMENT SHALL BE QUICK SETTING WITH MIN. COMPRESSIVE STRENGTH OF 5,500 PSI AT 28 DAYS.

ALTERNATE BID ITEM NO. 1


ENGINEERS WWW.Cucilgiilecis.com									PW FILE NO. 89,960.3
	REFERENCE INFORMATION & FILE NO. OF SURVEYS	Ī	SAN FRANCISCO PORT COMMISSION	PROFESSION R. SMILE	DESIGNED: DATE: JET 01/20/0	APPROVED BY SAN FRANCISCO PORT COMMISSION	SCALE:	TAYLOR STREET IMPROVEMENTS	CONTRACT NO. 1498J
	<u>PORT OF SF (ALAN NEVLING)</u> —PIER 45 PLÂNS/EARTHQUAKE REPAIR PROJ.		PORT OF SAN FRANCISCO	No. 43034	DRAWN: DATE:	DATE: <u>9/1/09</u>	1'=3/4"	THE EMBARCADERO TO JEFFERSON STREET	DRAWING NO. FM-4
8/4/09 ADDENDUM NO. 2 DATE DESCRIPTION BY APP.		-DODT of		EXP. 3-31-10 A	MLS 01/20/0 CHECKED: DATE:	Uday Postad CHIEF HARBOR ENGINEER	SHEET OF SHEETS	10" FORCE MAIN CONNECTION AND CONCRETE COLLAR DETAILS	FILE NO. 13408-45-S REVISION NO.
TABLE OF REVISIONS CHECK WITH TRACING TO SEE IF YOU HAVE LATEST REVISION		PORT OF SAN FRANCISCO	DELAKTIVIENT OF ENGINEERING		KRS 01/26/0	To	35 OF 39	CONCIUNT COLLAIV DETAILO	revision no. O

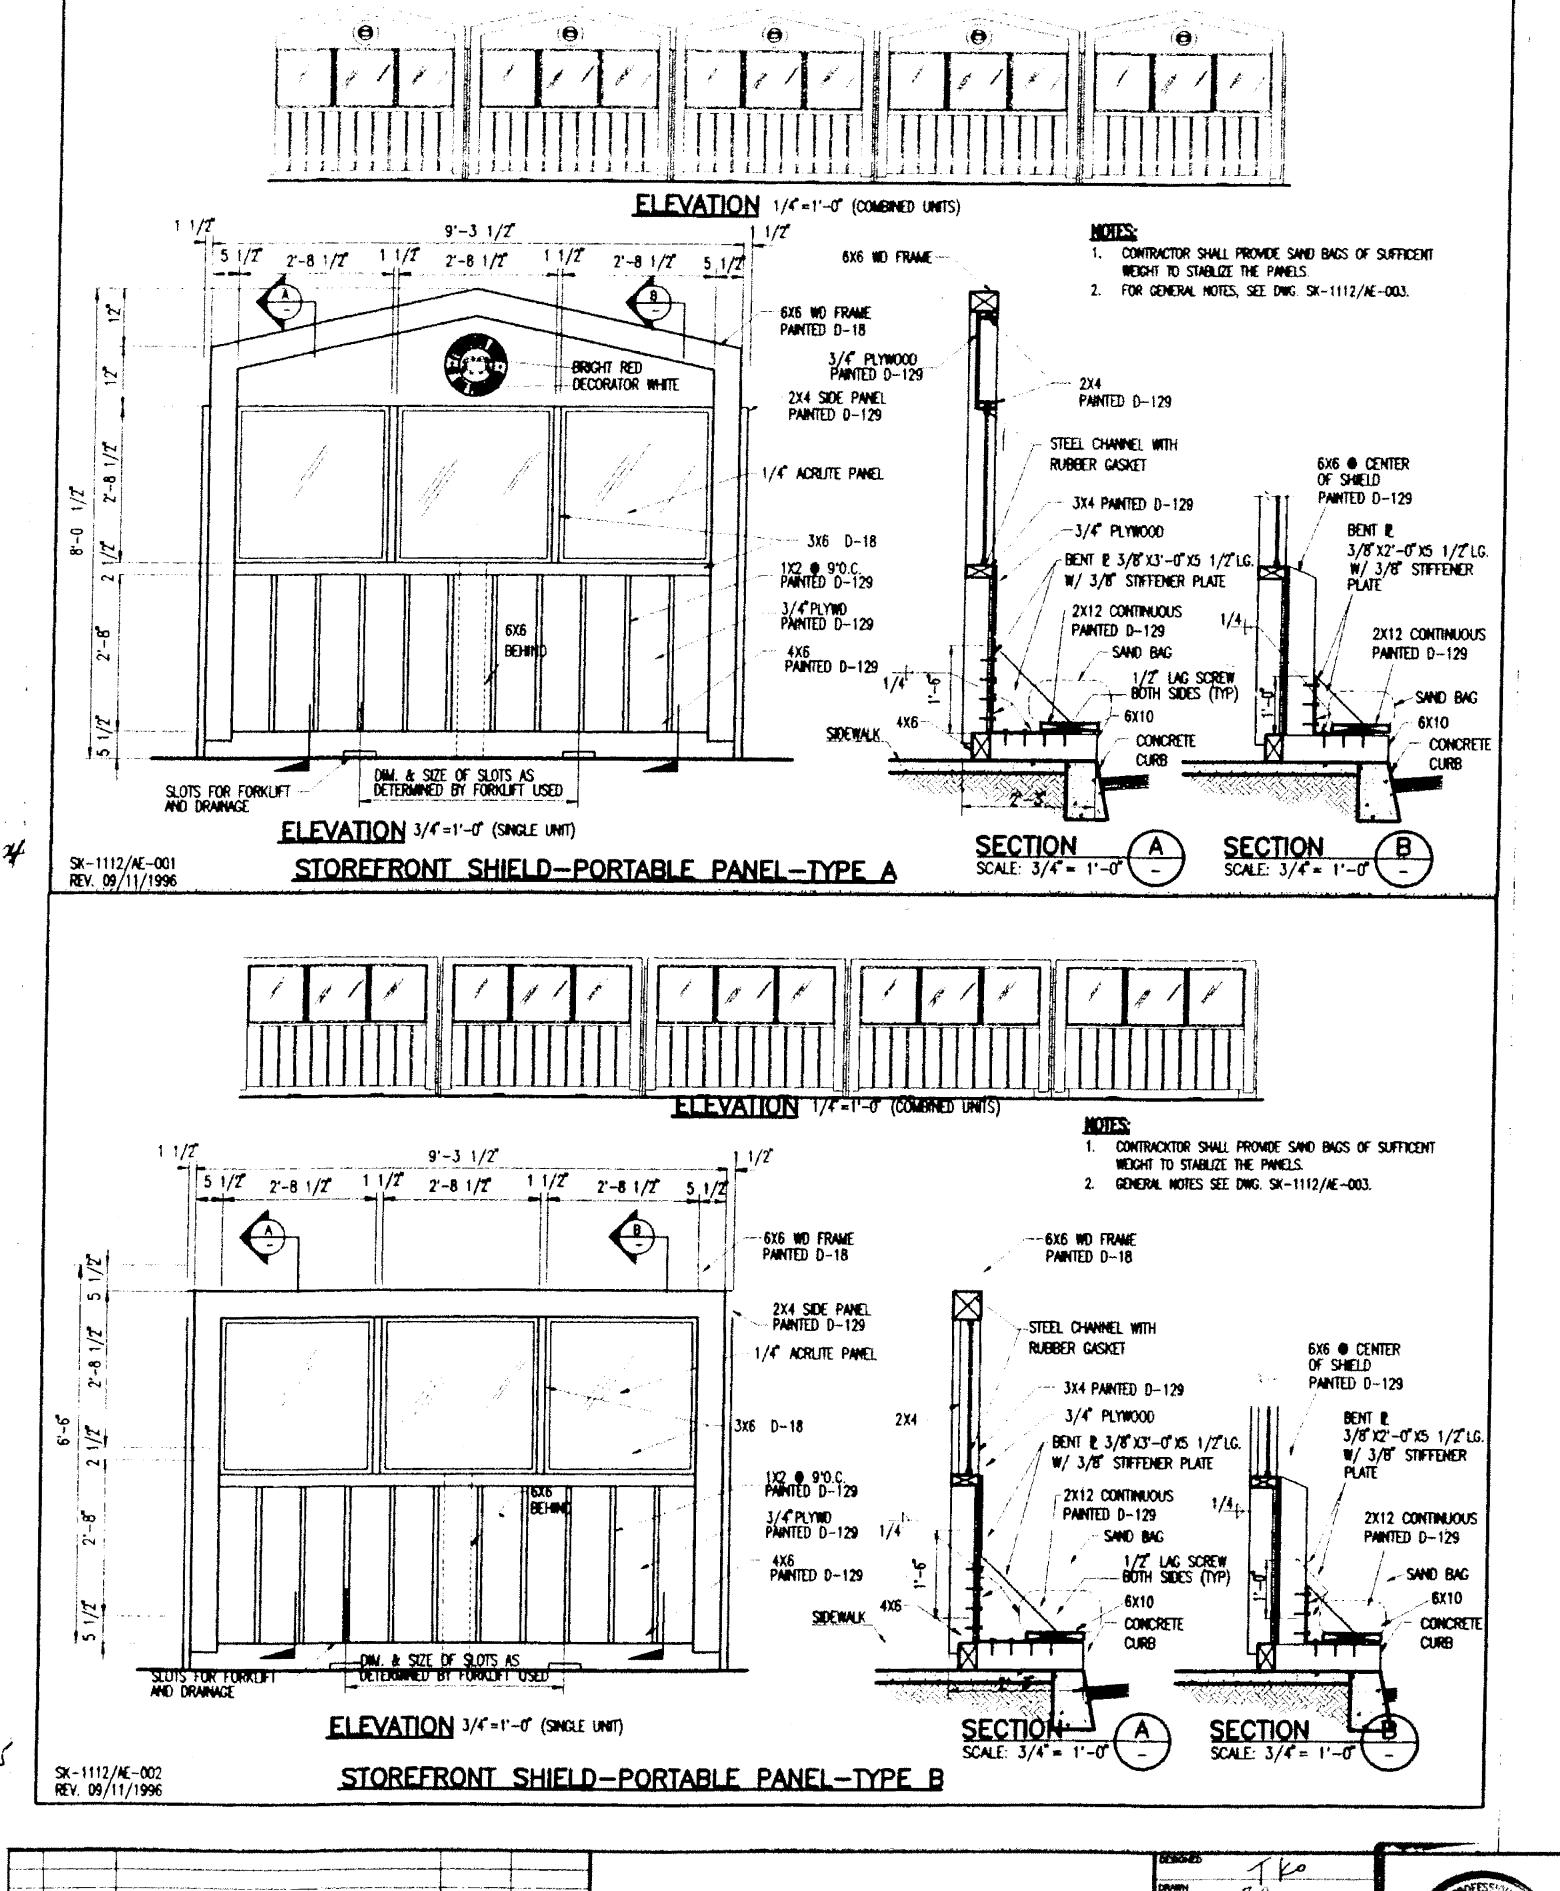

REVINED BY APPROVES !

PERCHIPTION

REVISIONS

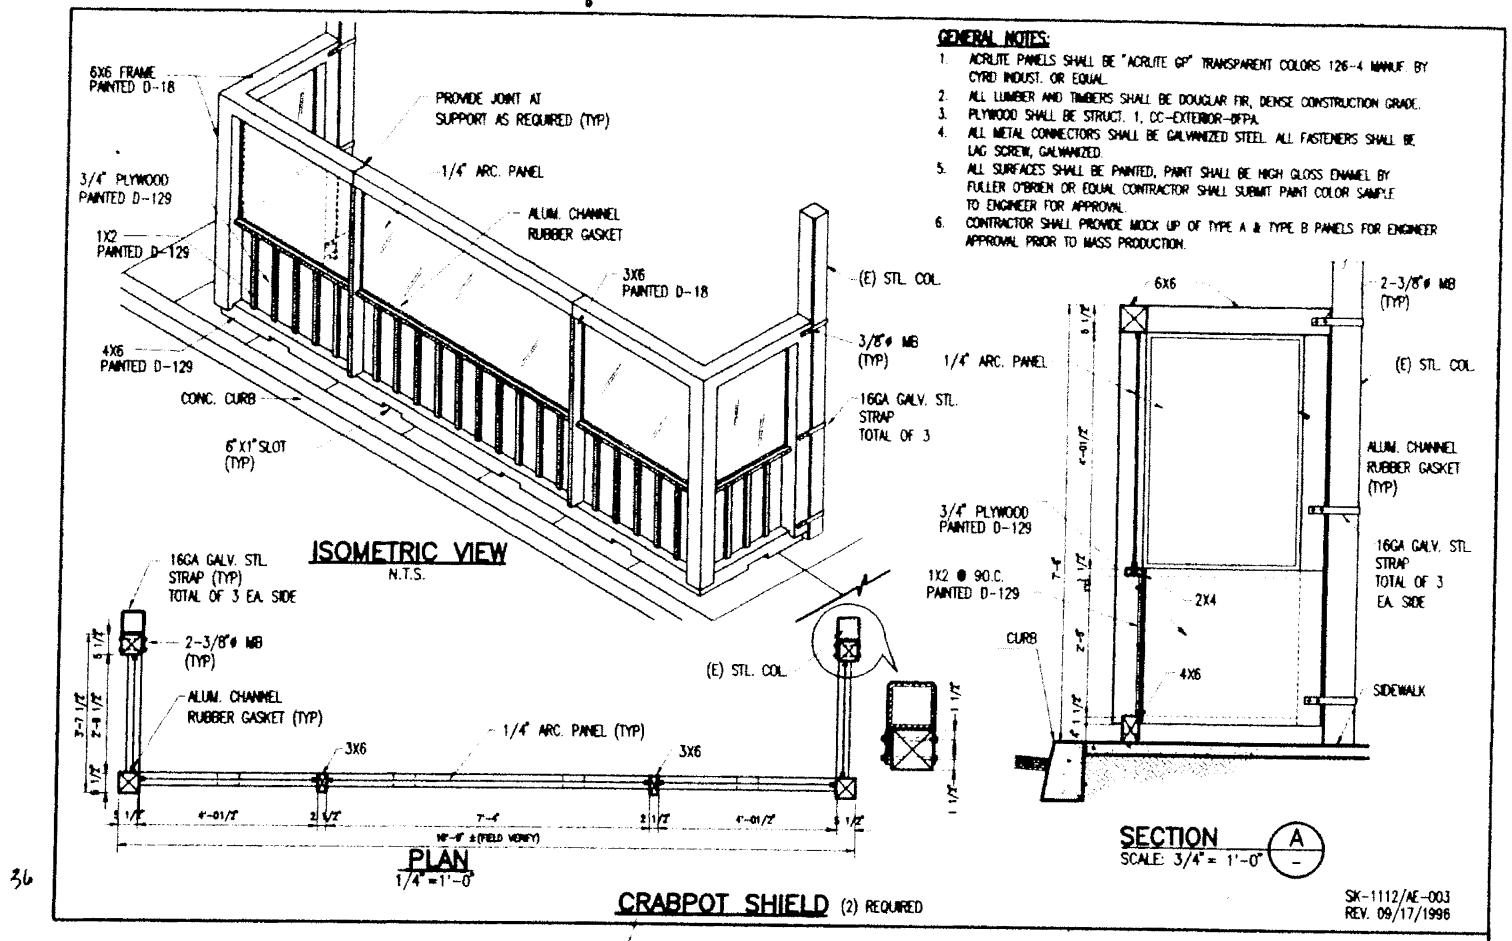

PLANS ARE TO BE RETURNED WITH CORRECTIONS MADE AND CERTIFIED TO IN RED INK AND DATED BY THE INSPECTOR IN CHARGE UPON COMPLETION OF THE WORK BEFORE FINAL PAYMENT CAN BE MADE.

January John
SIGNED-INSPECTOR



PUBLIC TRANSPORTATION DEPARTMENT

DIRECTOR OF PUBLIC TRANSPORTATION

NORTHPOINT STREET TO JONES STREET

STOREFRONT AND CRABPOT SHIELDS

MUNI METRO SYSTEM

F-LINE FISHERMAN'S WHARF LOOP

MR-1112R 5K-1112/AE-001, 2, 3

PROJEMO / HEENAME WOLLD'S HEAR HAVE

PLANS ARE TO BE RETURNED WITH CORRECTIONS MADE AND CERTIFIED TO IN RED INK AND DATED BY THE INSPECTOR IN CHARGE UPON COMPLETION OF THE WORK BEFORE FINAL PAYMENT DAN BE MADE SIGNED-INSPECTOR (

TAYLOR STREET IMPROVEMENTS

SIGNAL HEAD MOUNTINGS

Daniel R anellano 6/26/09 SECTION ENGINEER DATE:

DATE

CHECKED:

Exp.3/31/201

NONE

SHEET OF SHEETS

26 OF 39


1498J

STR-7025

DRAWING NO.

FILE NO.

REV. NO.

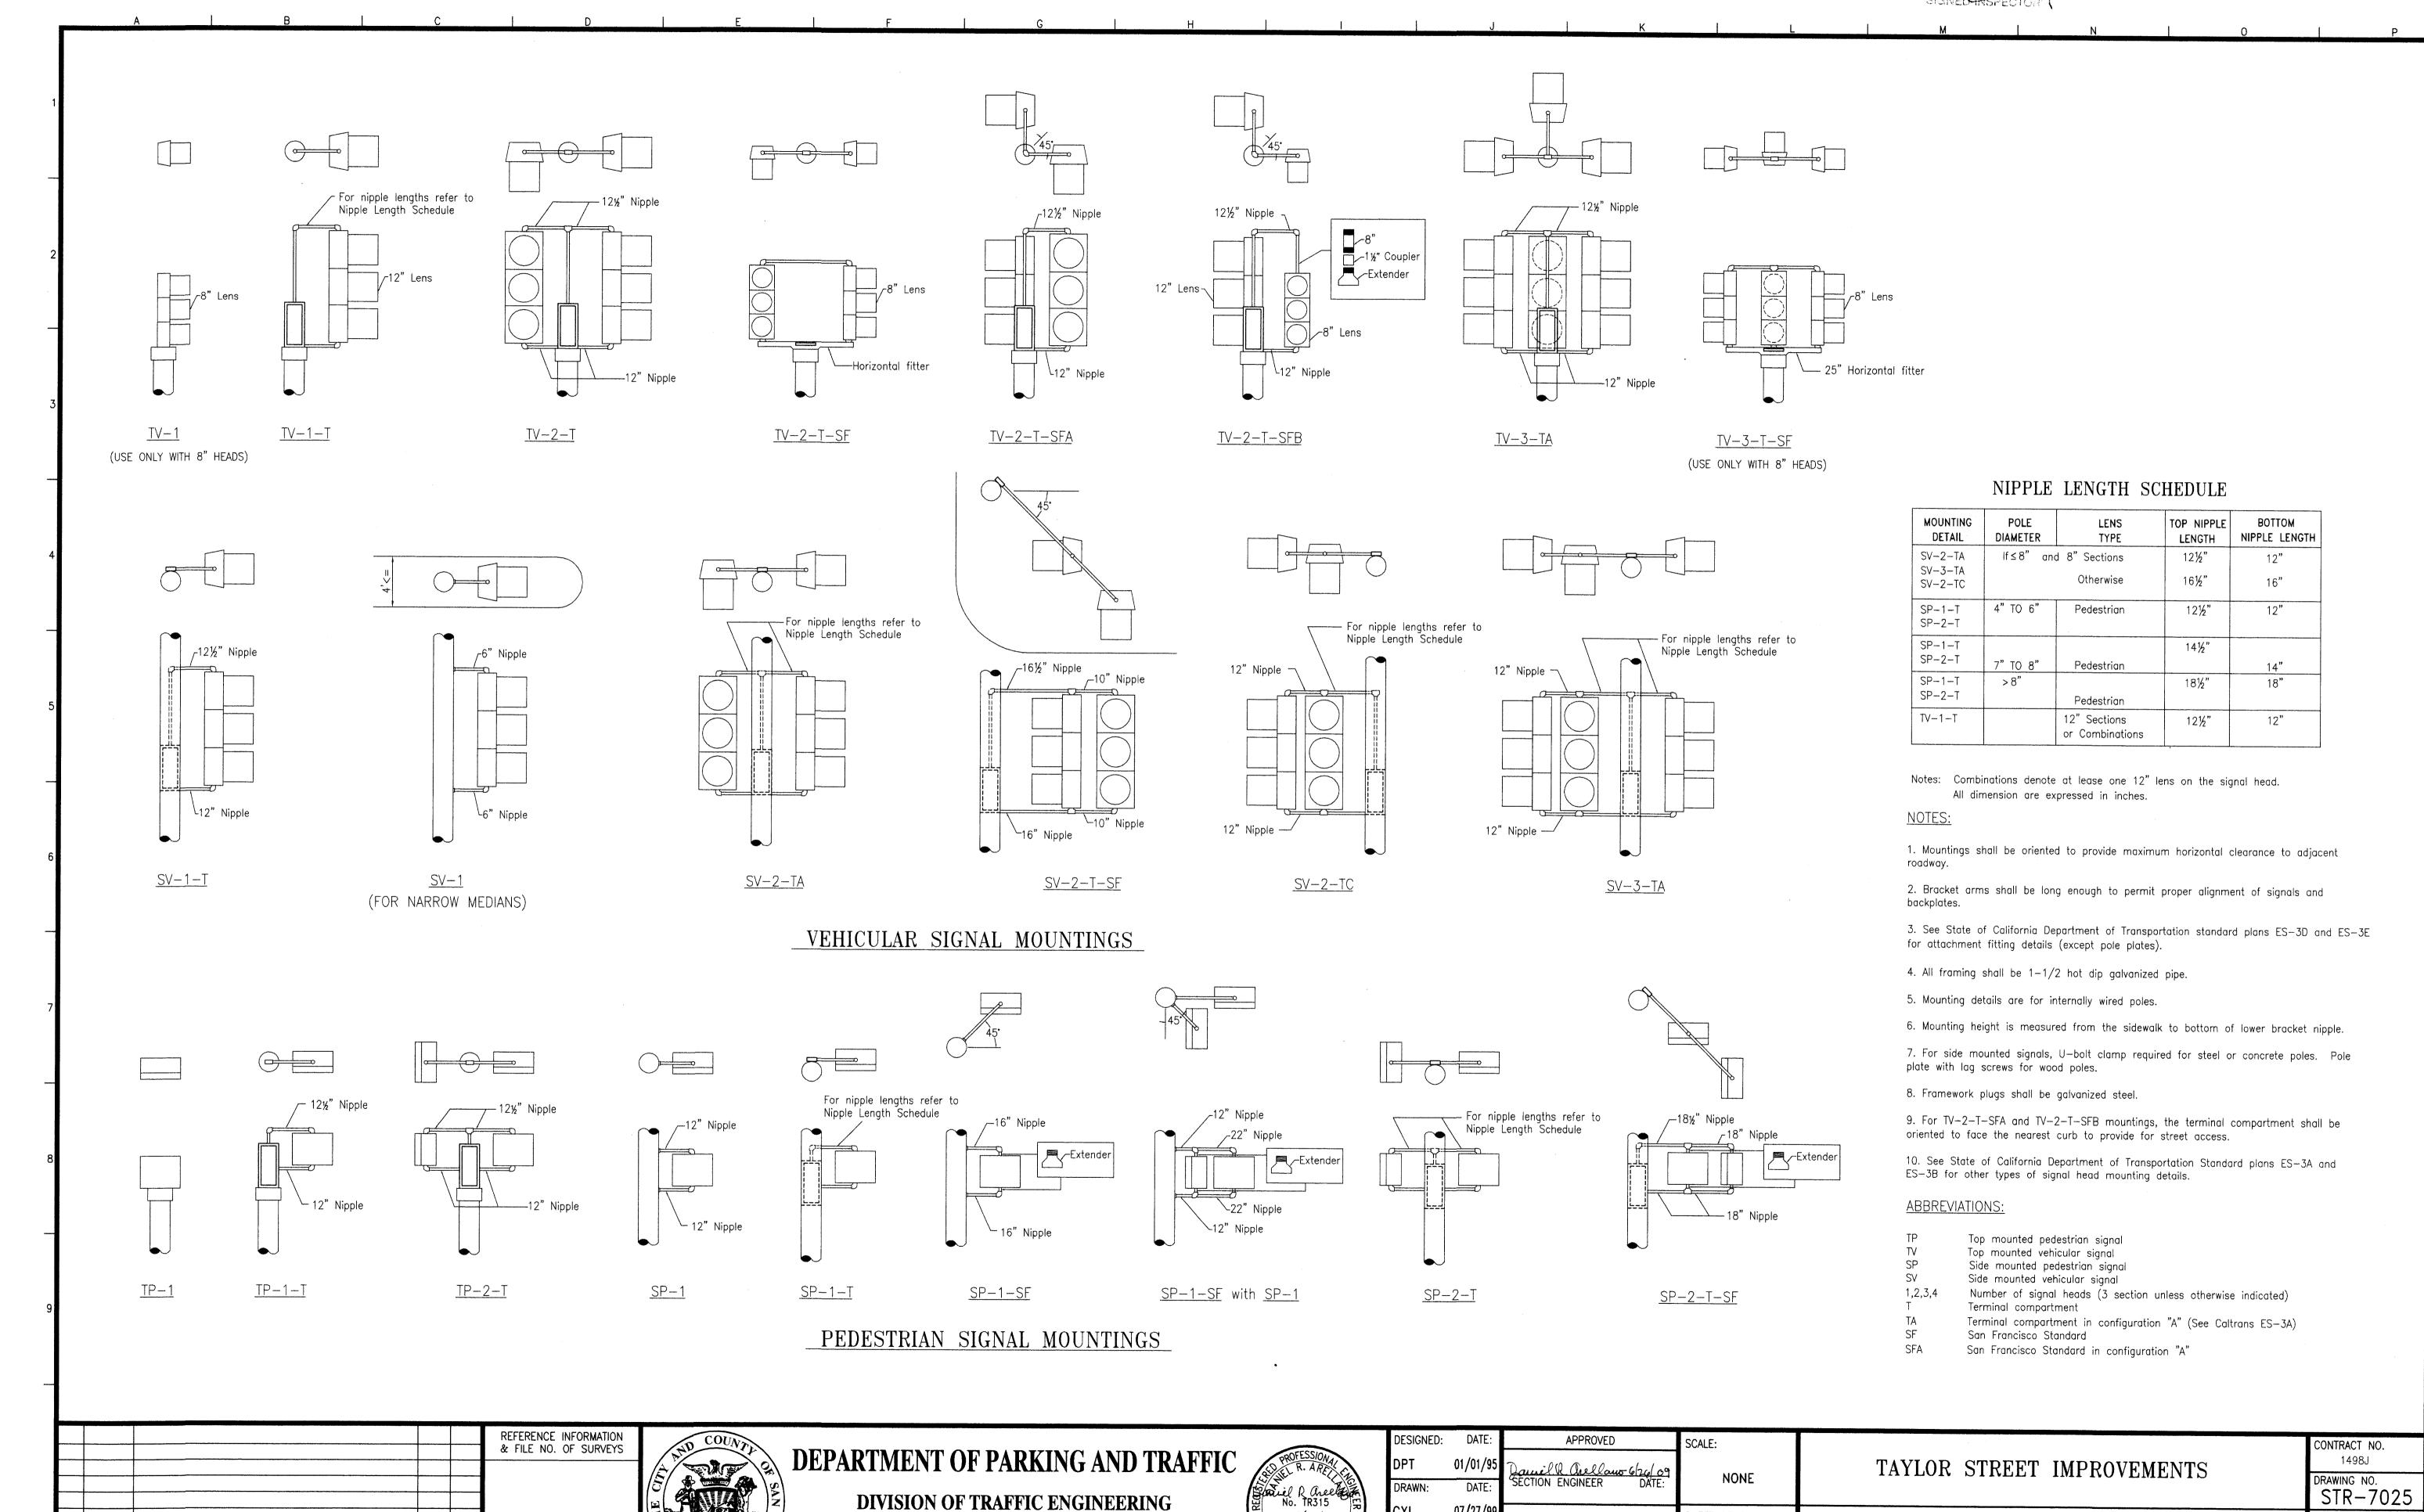

DIVISION OF TRAFFIC ENGINEERING

CITY AND COUNTY OF SAN FRANCISCO

DESCRIPTION


TABLE OF REVISIONS
CHECK WITH TRACING TO SEE IF YOU HAVE LATEST REVISION

BY APP

NO. DATE


PLANS ARE TO BE RETURNED WITH DURRECTIONS MADE AND CERTIFIED TO IN RED INK AND DATED BY THE INSPECTOR IN CHARGE UPON COMPLETION OF THE WORK BEFORE FINAL BAYMENT CAN BE MADE.

SIGNED-INSPECTOR

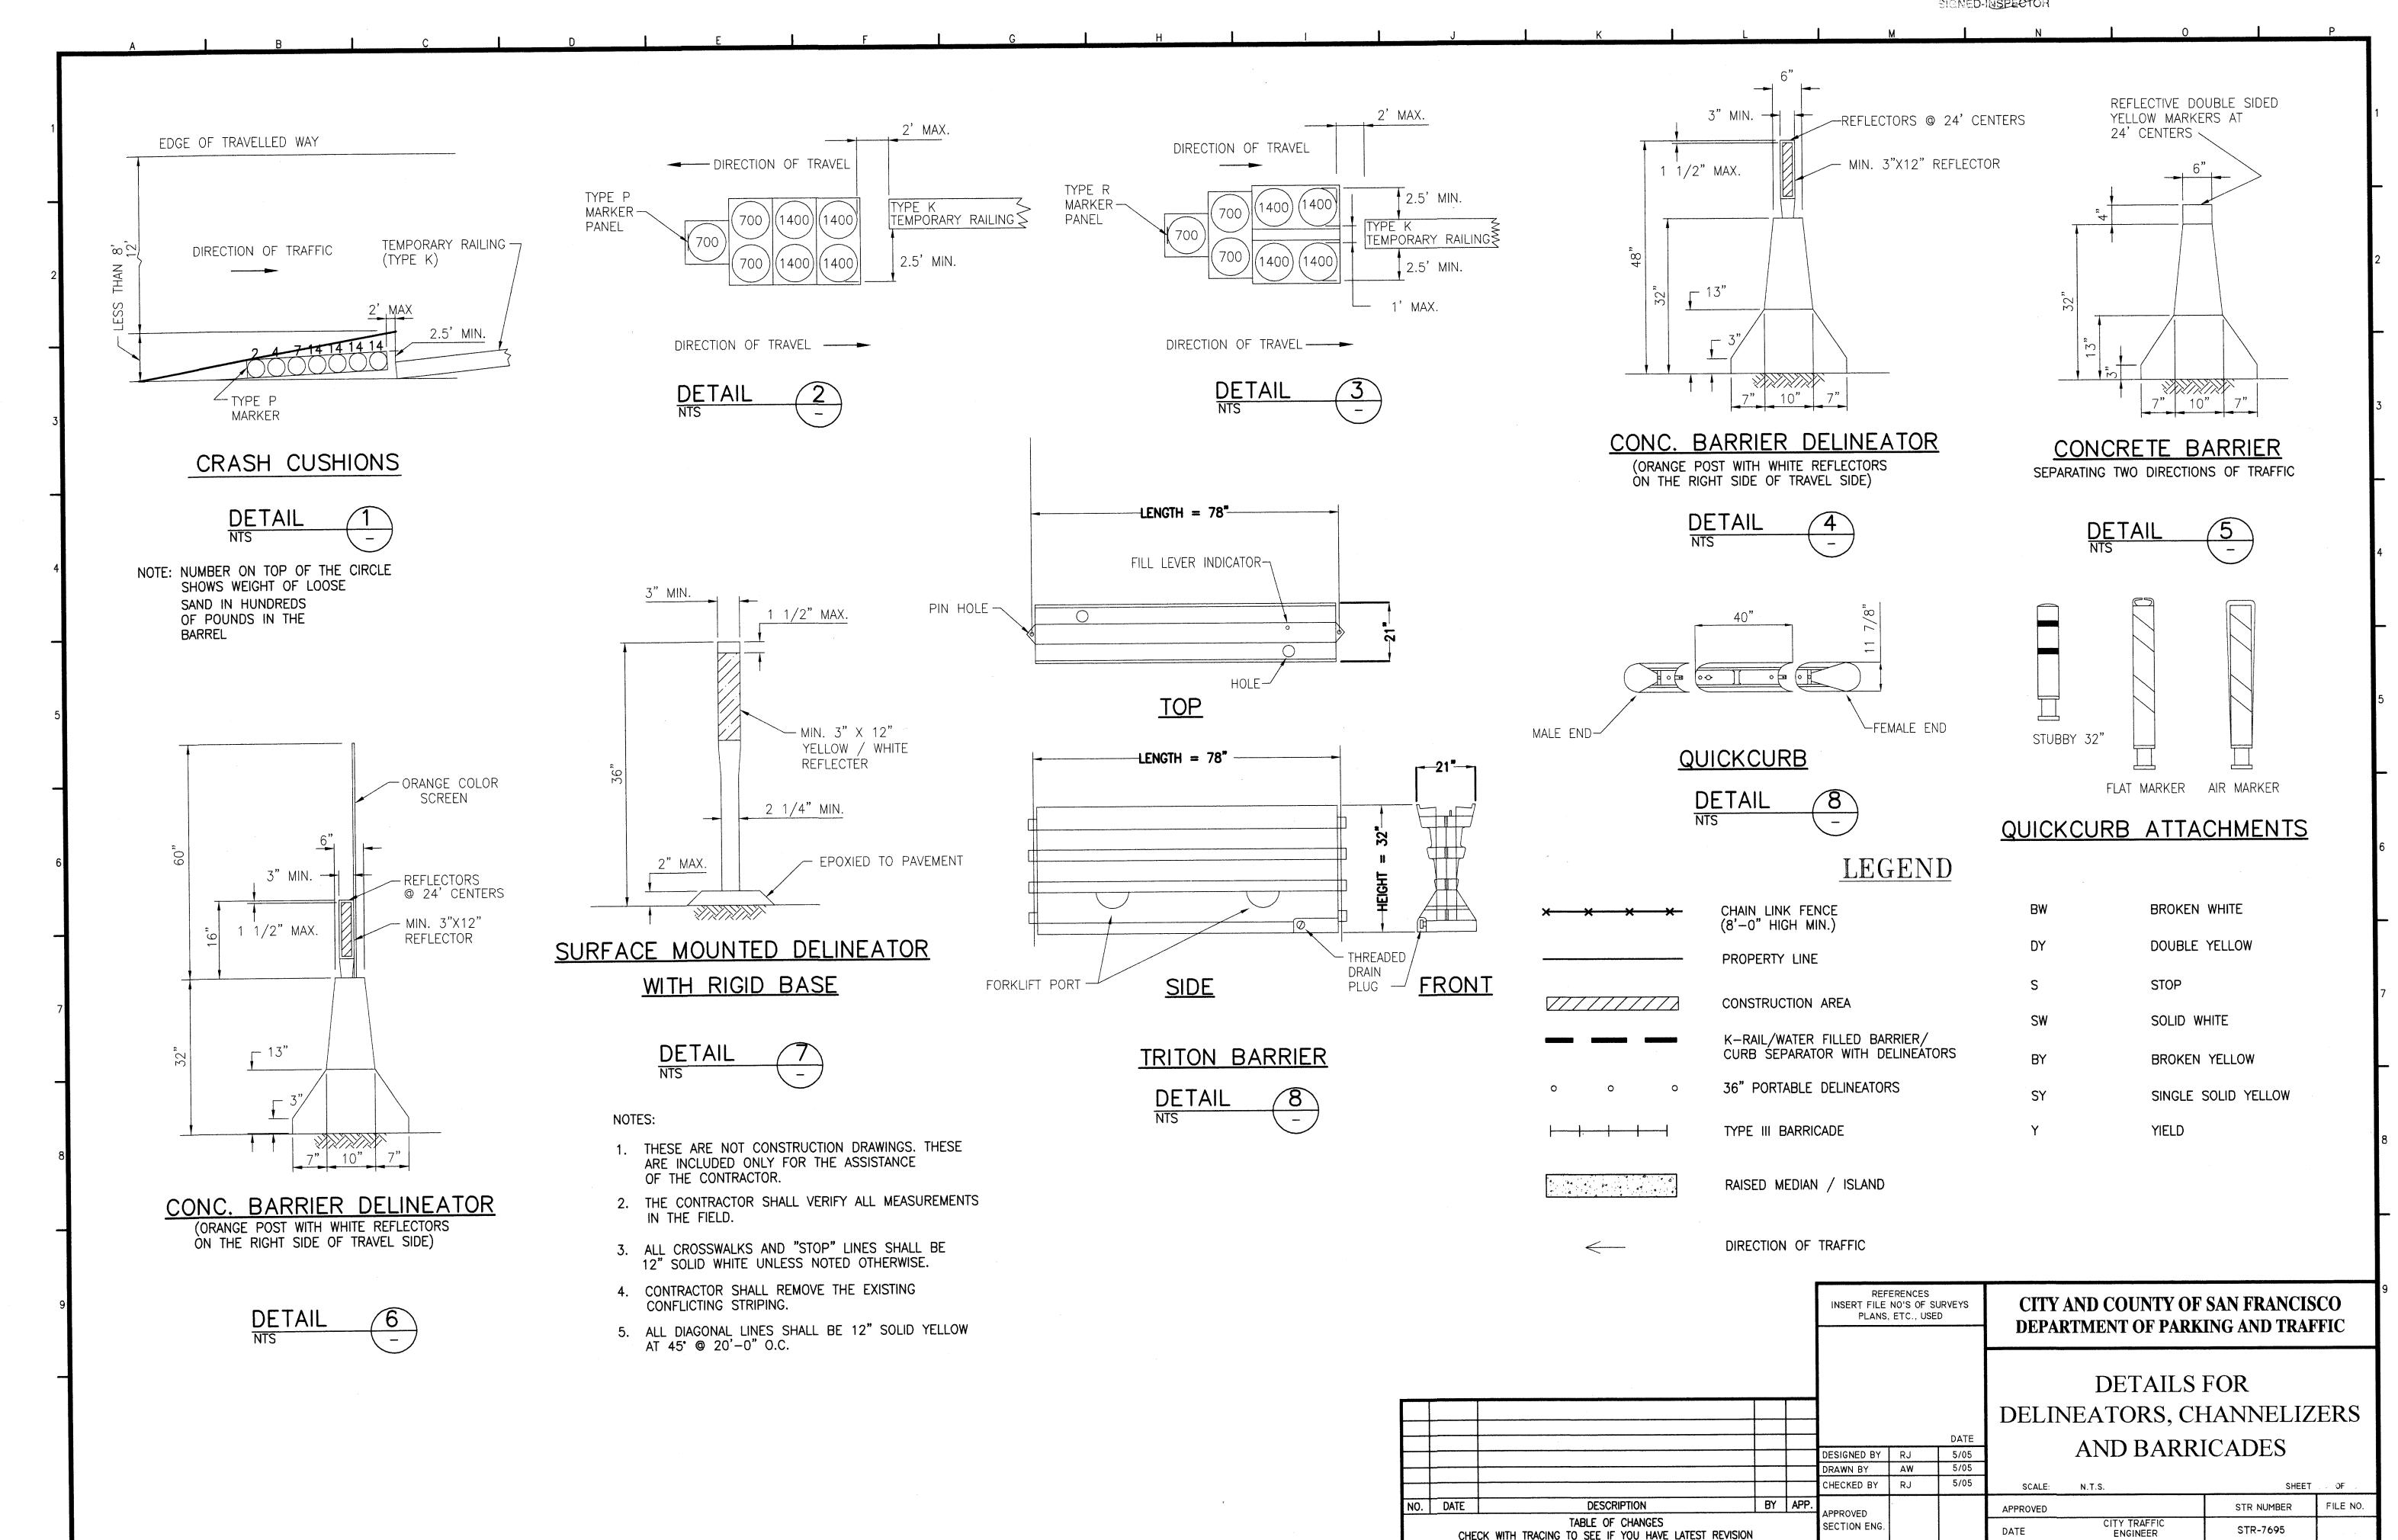

CORRECTIONS WAS AND DUPTIMES
TO IN REGING AND DATED BY THE
INSPECTOR IN CHARGE UPON
COMPLETION OF THE WORK BEFORE
FINAL PAYMENT CAN BE MADE.

SIGNED-INSPECTOR

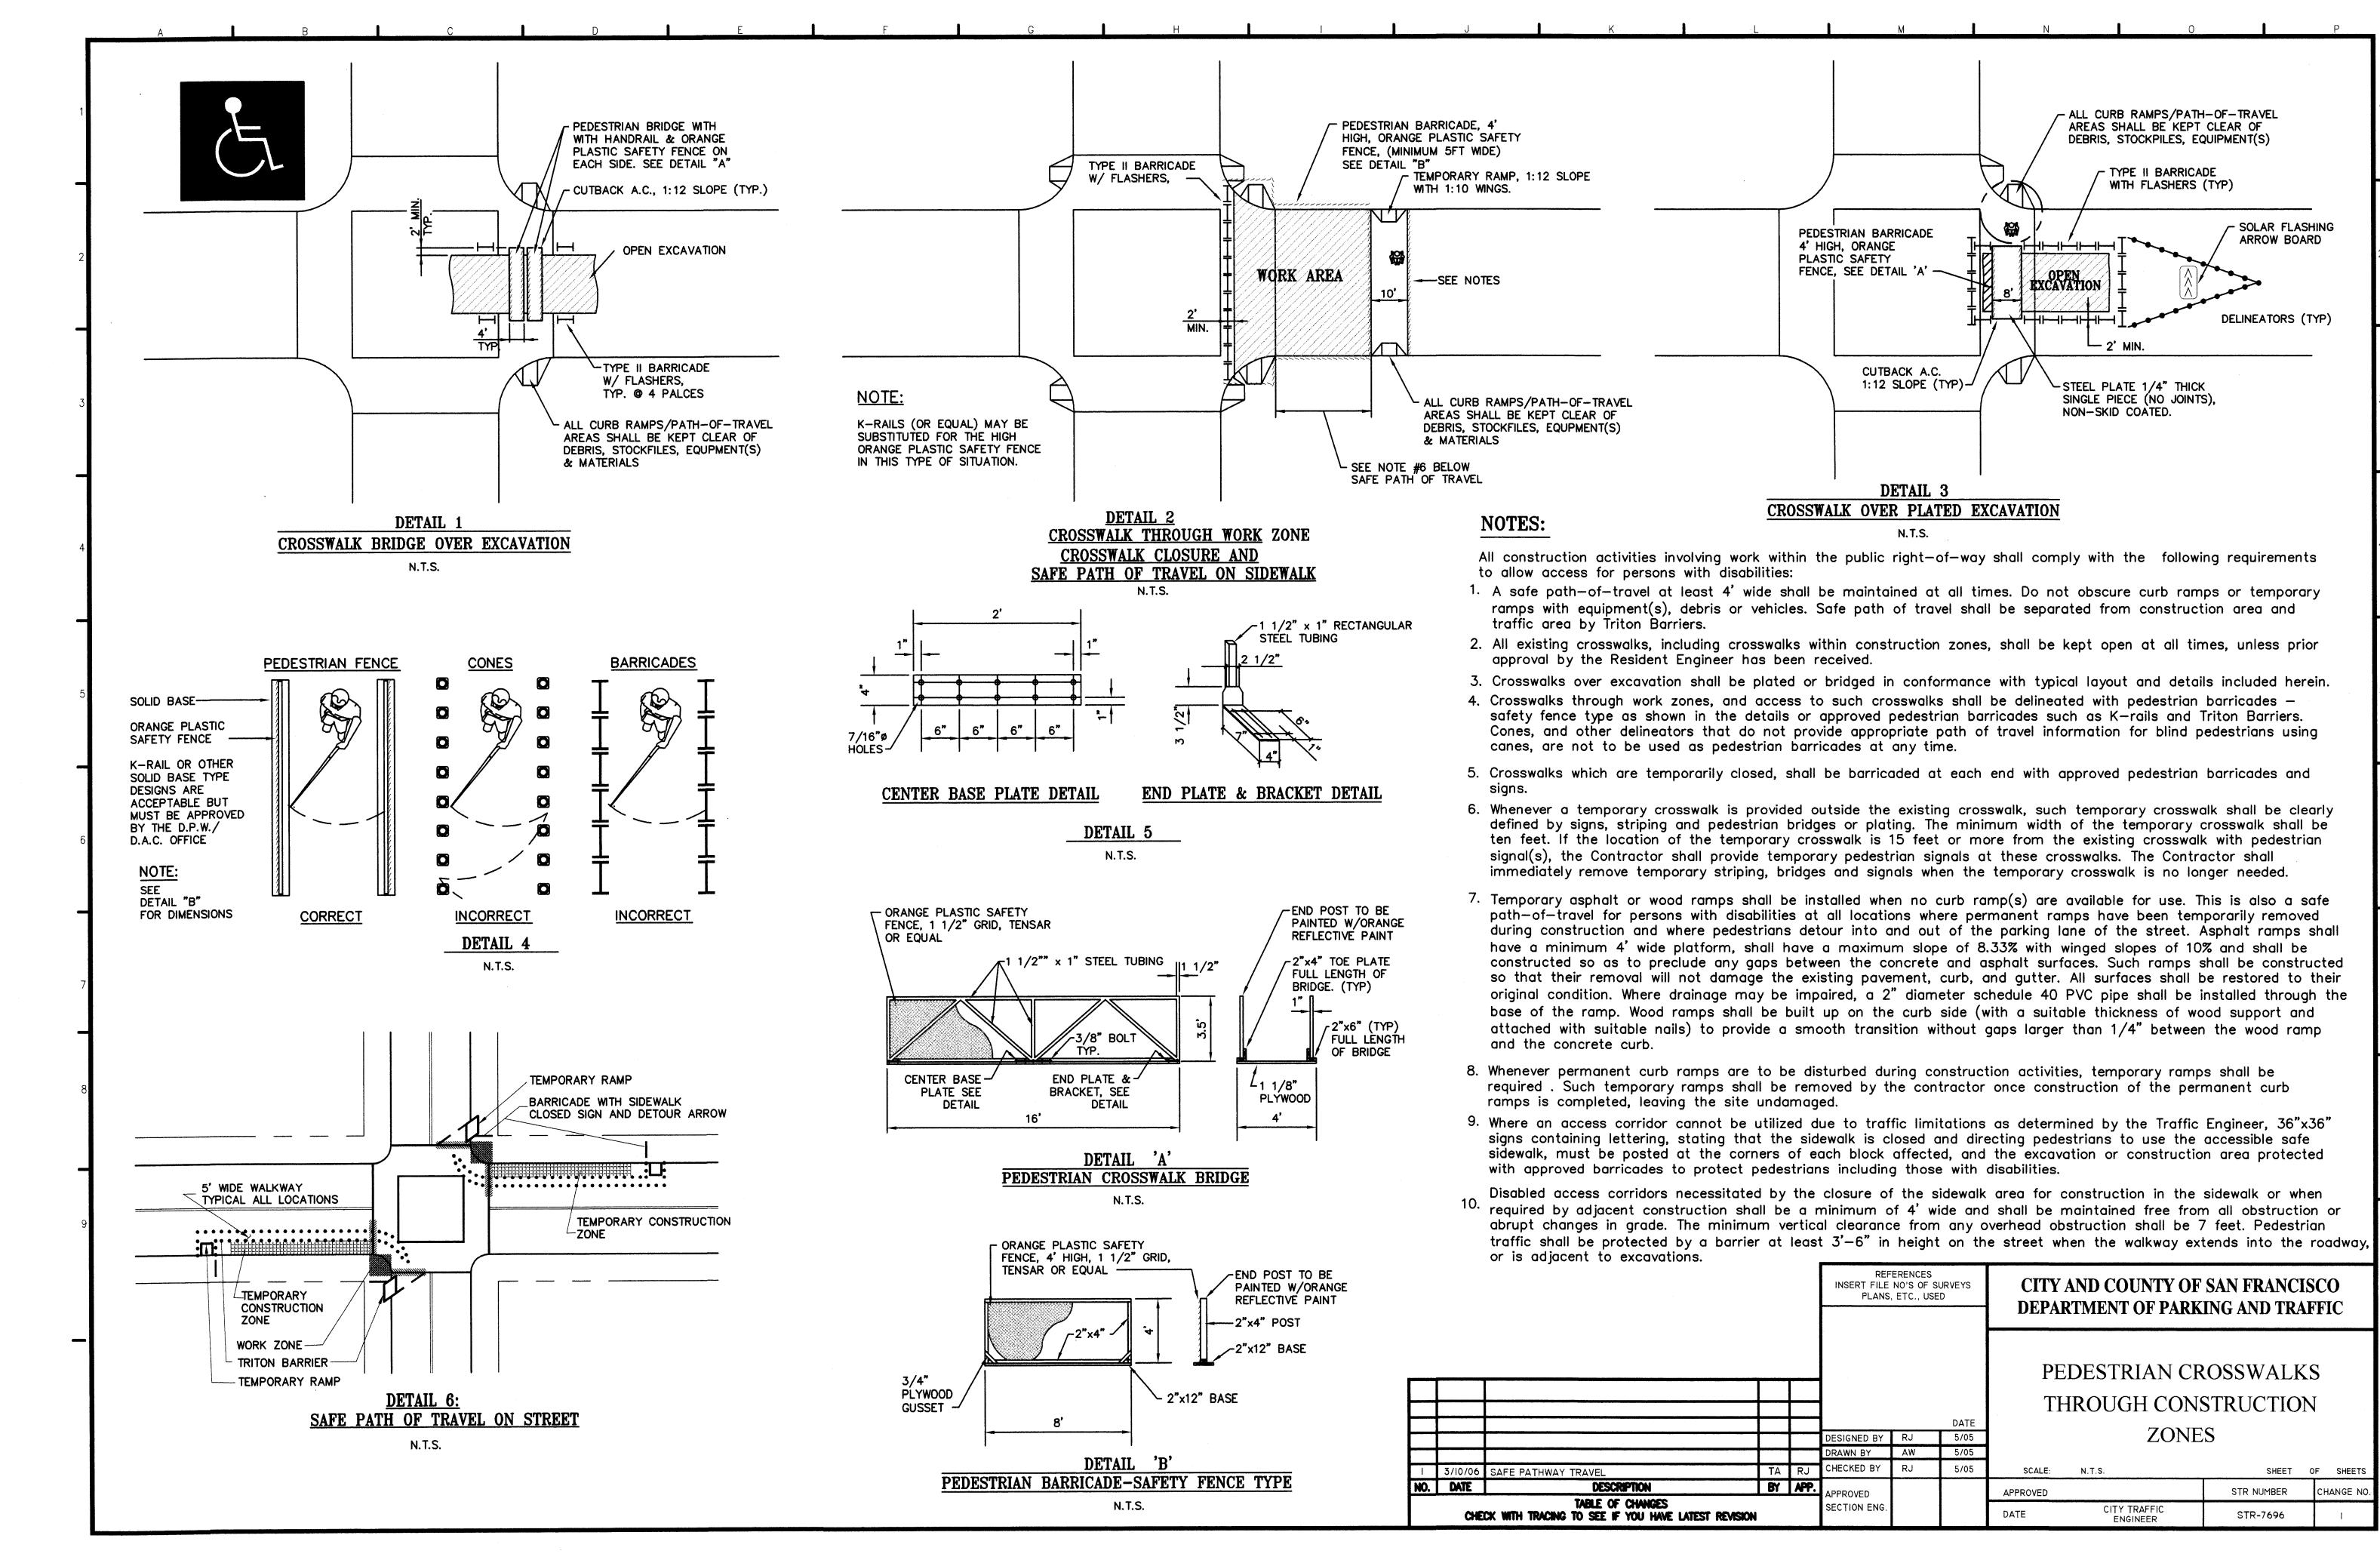



8 INCH DUCTILE IRON PIPE MAIN INSTALLATION IN TAYLOR STREET FROM THE EMBARCADERO TO JEFFERSON STREET

LEGEND:

SFWD WATER DEPARTMENT
AWS AUXILIARY WATER SUPPLY SYSTEM
BLP BUREAU OF LIGHT, HEAT & POWER
C TCI CABLE
DOE DEPARTMENT OF ELECTRICITY
E PG & E ELECTRICITY
G PG & E GAS
ST PG & E STEAM
HH HETCH HETCHY WATER & POWER
T PACIFIC BELL TELEPHONE
TH SAN FRANCISCO THERMAL
MC MCI METRO (TELEGRAPH)
TS DEPARTMENT OF PARKING & TRAFFIC

(TRAFFIC SIGNAL)

PIPE

CIP CAST IRON PIPE

CP CONCRETE PIPE

C COPPER PIPE

DIP DUCTILE IRON PIPE
G GALVANIZED PIPE
IP IRON PIPE
ISP IRON STONE PIPE
P PIPE
PP PLASTIC PIPE
RCP REINFORCED CONCRETE PIPE

SP STEEL PIPE
TP TRANSITE PIPE
VCP VITRIFIED CLAY PIPE
WIP WROUGHT IRON PIPE

CONDUIT

C CONDUIT
CC CABLE CONDUIT
DBC DIRECT BURIAL CONDUIT
FC FIBER CONDUIT
FCC FIBER CEMENT CONDUIT
PC PLASTIC CONDUIT
SC SOAPSTONE CONDUIT
TC TILE CONDUIT
WC WOOD CONDUIT

DUCT

CD CONCRETE DUCT
CWD CREOSOTED WOOD DUCT
D DUCT
PD PAPER PIPE DUCT
TD TRANSITE DUCT

TK TRANSITE KORDUCT VCD VITRIFIED CLAY DUCT

GENERAL

ABANDONED AIR VALVE **BLOW OFF BRICK LINED BUTTERFLY VALVE** CONNECT CV CHECK VALVE DISCONN DISCONNECT FIRE ALARM FIRE CISTERN **GATE VALVE** HIGH PRESSURE HYDRANT **HYDRANT** STOP COCK SERV SERVICE TAPPING GATE VALVE

STRUCTURE

UNKNOWN

TRAFFIC SIGNAL

HYDRANT

MANHOLE

PULL BOX, JUNCTION BOX OR SPLICE BOX OR CABLE BOX

VAULT

S-18"VCP (SEWER - 18" VITRIFIED CLAY PIPE)

(TELEPHONE - FOUR DUCTS - 3" FIBER CONDUIT)EXISTING ABANDONED UTILITY

MAIN TO BE ABANDONED IN THIS CONTRACT

LIST OF DRAWINGS

DRAWING NO.

TITLE

WD-1

LEGEND, ABBREVIATIONS AND GENERAL NOTES

WD-2

8" D.I. WATER MAIN INSTALLATION

GENERAL NOTES

FOR 3" AND LARGER PIPES, HEAVY LINES AND SYMBOLS INDICATE WORK TO BE DONE BY THE CONTRACTOR. LIGHT LINES AND SYMBOLS INDICATE EXISTING MAINS.

PIPES LESS THAN 3" IN DIAMETER (SERVICE PIPES) ARE SHOWN IN LIGHT LINES, SIZES SHOWN ARE FOR NEW TAP SIZES. FOR ADDITIONAL INFORMATION, REFER TO THE SERVICE LIST IN THE TECHNICAL SPECIFICATIONS.


THE LOCATION AND GENERAL ARRANGEMENT OF UNDERGROUND UTILITIES, UNDERGROUND STRUCTURES, PIPE LINES WITH FITTINGS, VALVES AND APPURTENANCES, WHERE SHOWN, ARE DIAGRAMMATIC.

INFORMATION AS TO UNDERGROUND AND/OR OTHER CONDITIONS AS INDICATED BY ADJUSTMENTS IN PIPE ALIGNMENT, OR OBSTRUCTION SHOWN ON THE PLANS AND/OR SPECIFICATIONS HAS BEEN OBTAINED WITH REASONABLE CARE BASED ON INFORMATION OBTAINED FROM AVAILABLE RECORDS OF THE OWNERS OF THE UTILITIES AND HAS BEEN RECORDED IN GOOD FAITH.

THERE IS NO EXPRESSED OR IMPLIED AGREEMENT THAT THE WATER DEPARTMENT AND THE OWNERS OF UTILITIES MAKE ANY REPRESENTATION AS TO THE COMPLETENESS OR ACCURACY OF SAID INFORMATION OF UTILITY FACILITIES THAT MAY HAVE BEEN PLACED OR INDICATED HERE ON.

THE PROPOSED LOCATION WITHIN THE STREET OR SIDEWALK AREA FOR FACILITIES TO BE CONSTRUCTED UNDER THIS CONTRACT, AS SHOWN ON THE PLANS, IS APPROXIMATE ONLY. THE CONTRACTOR SHALL DIG TEST HOLES TO DETERMINED THE EXACT LOCATION OF THE WORK WITHIN THE STREET OR SIDEWALK AREA. CHANGES IN THE ALIGNMENT OF ANY PORTION OF THIS WORK WHICH MAY RESULT IN DIFFERENT CONSTRUCTION METHODS OR DIFFERENT CONDITIONS, SUCH AS REQUIRING HAND DIGGING FOR PORTIONS OF THE WORK, WILL NOT BE SUBJECT TO CLAIM FOR ANY EXTRA PAYMENT.



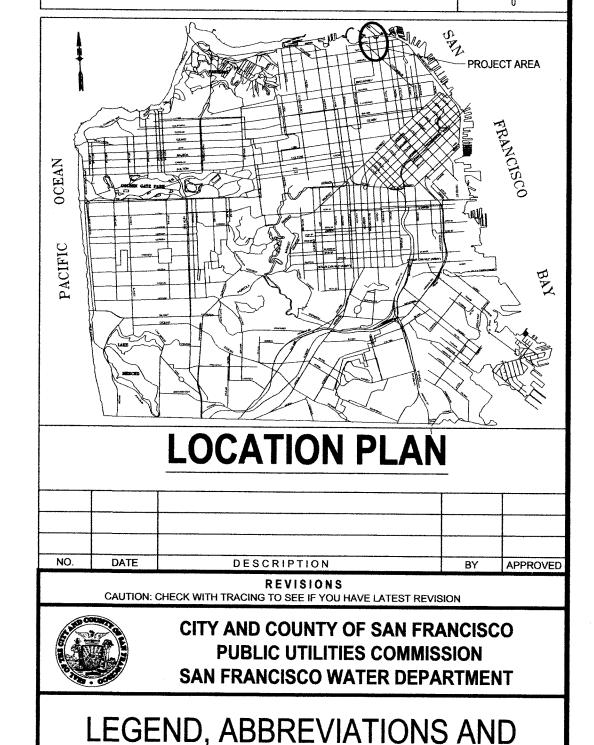

TAYLOR STREET IMPROVEMENTS

REFERENCES
GATE BOOK PAGES, PLANS,
SURVEY NOTES, ETC. USED

Gate Book Pages:

SECTION ENGINEER

SECTION ENGINEER

PROJECT ENGINEER

M. GARDINER

A. CHAN

O6/09

CH.

T. NGUYEN

DRAWING NO.

REVISION F

SHEET 15 OF 39



PLANS ARE TO BE RETURNED WITH CORRECTIONS MADE AND CERTIFIED TO IN RED INK AND DATED BY THE INSPECTOR IN CHARGE UPON COMPLETION OF THE WORK SEFORE FINAL PRYMENT CAN BE MADE

